



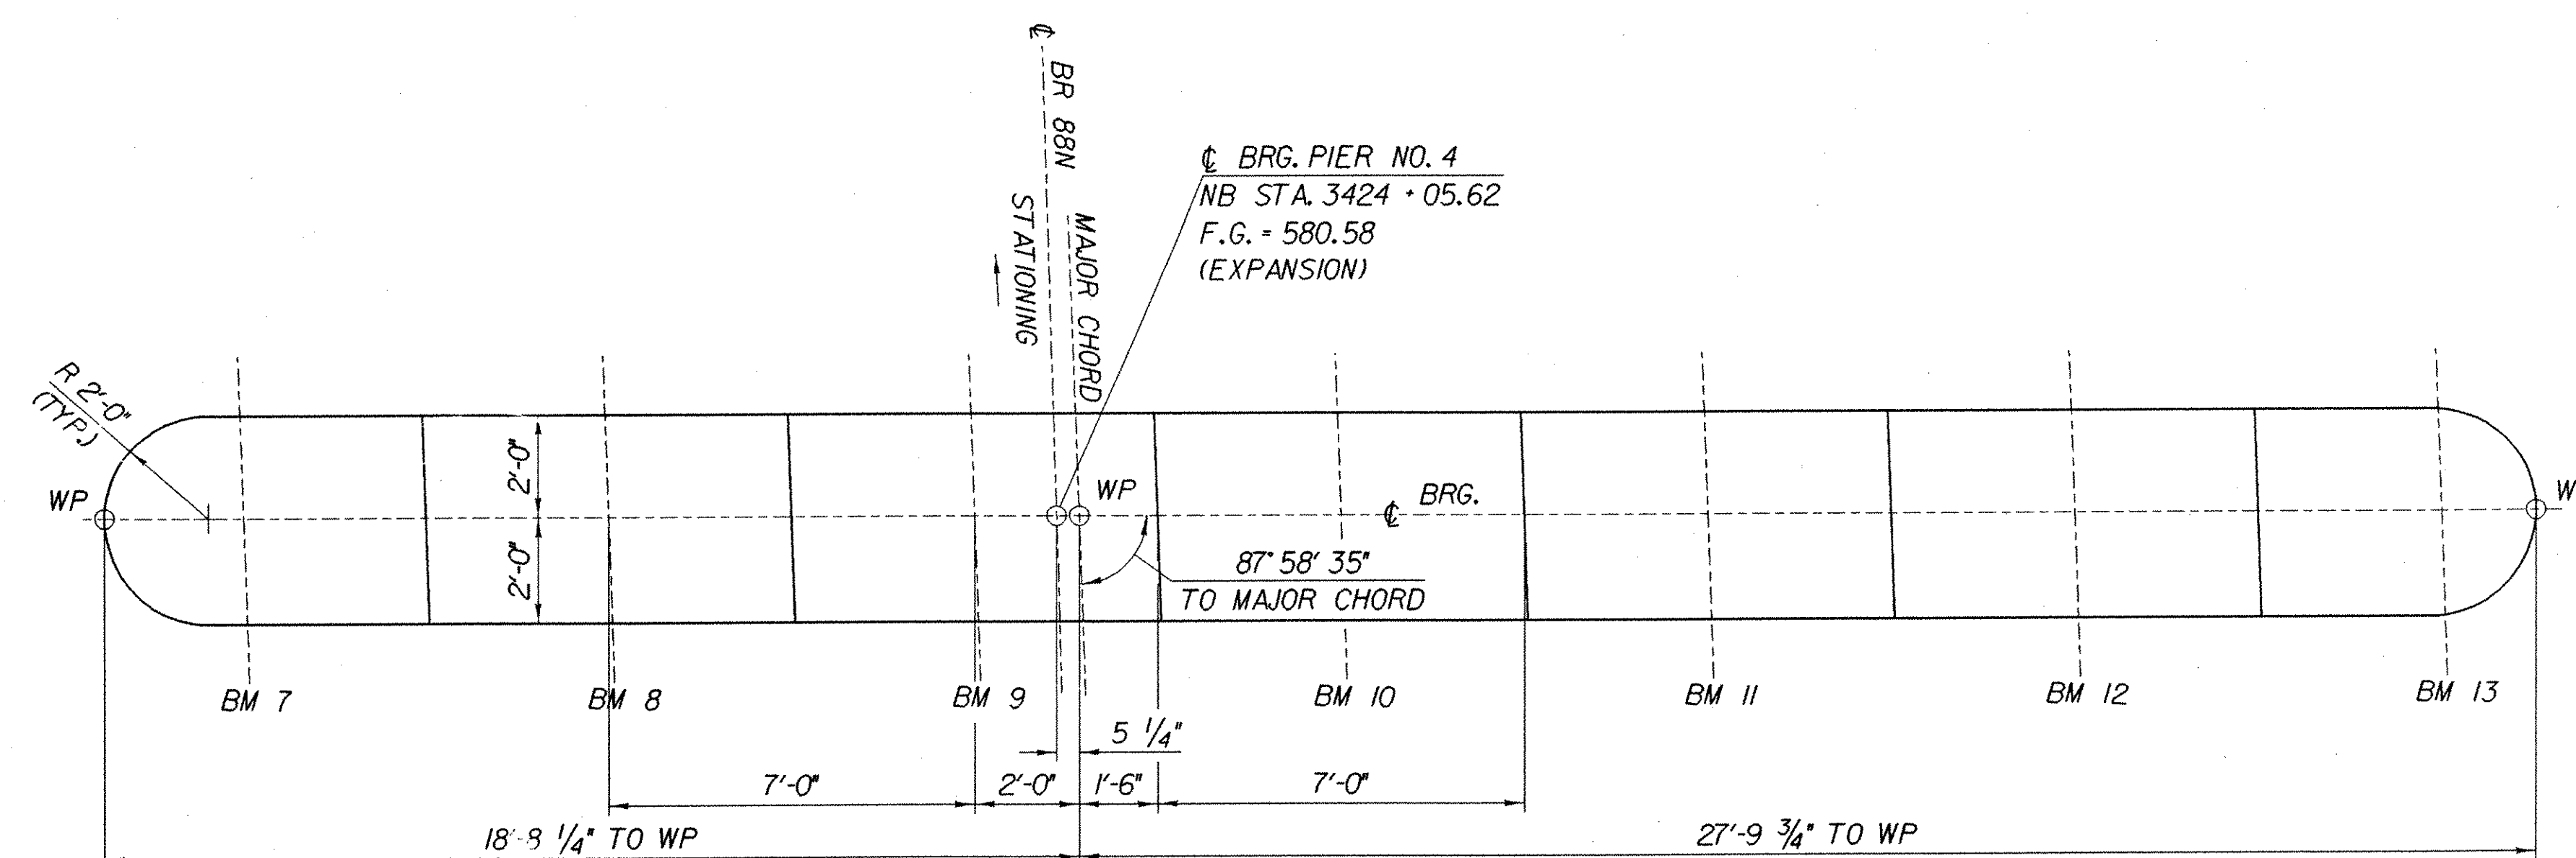

PIER NO. 4 PLAN

SCALE: $\frac{3}{8}$ " = 1'-0"

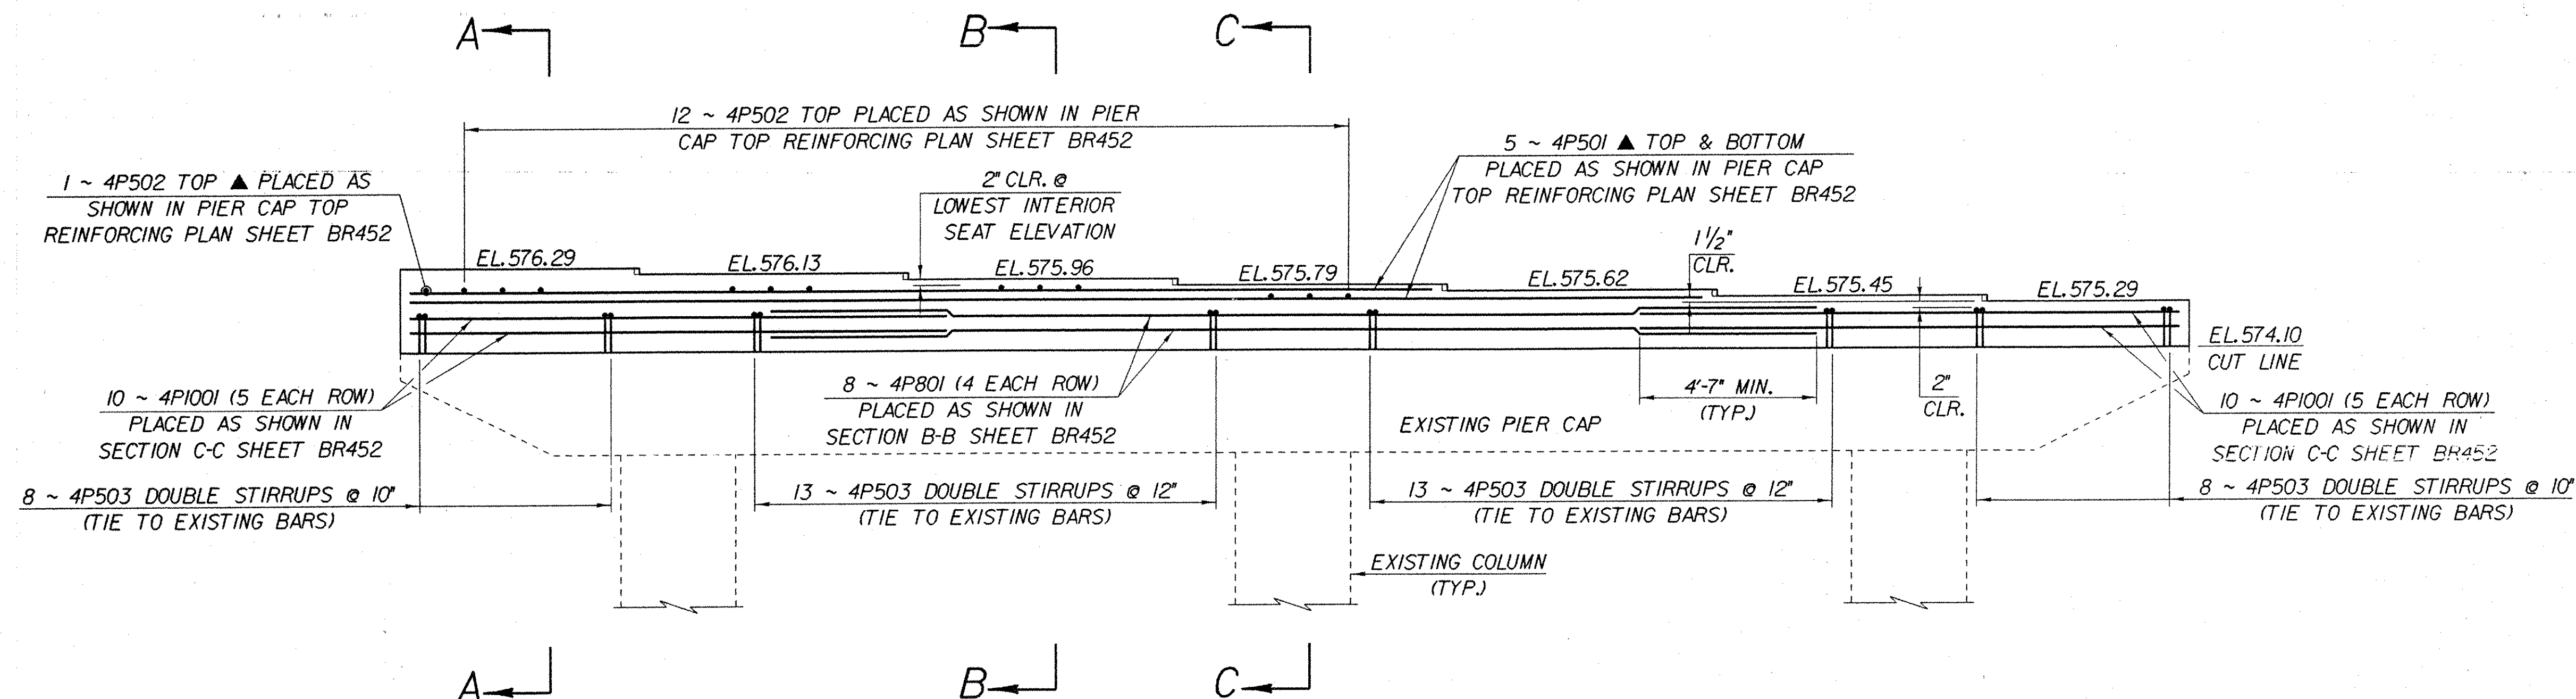

PIER NO. 4 PARTIAL ELEVATION

(LOOKING UPSTATION)

SCALE: $\frac{3}{8}$ " = 1'-0"

NOTE:

NF = NEAR FACE
FF = FAR FACE
EF = EACH FACE
▲ = CUT TO FIT IN FIELD
3" CLR. UNLESS OTHERWISE SPECIFIED ON THE PLANS.

IMPORTANT NOTE: BRIDGE FINISHED GRADES ARE CENTERLINE GRADES.

STATE OF VERMONT AGENCY OF TRANSPORTATION			
Town of FAIRFAX-FAIRFIELD-ST. ALBANS		Bridge No.	88N
Highway No. 1-89		Log Sta.	
		Surv. Sta.	
1-89 OVER ST. ALBANS SOUTH STATE HIGHWAY (EXIT 19)			
PIER NO. 4 DETAILS			
Designed By	P. PERRY	Drawn By	K. CHISHOLM
Checked By	M. LOZIER	Bridge Design Supervisor	R. R. WHITCOMB
Date	2/00	Date	2/00
PROJECT FAIRFAX-FAIRFIELD-ST. ALBANS		PROJECT NO. 1M 089 - 3 (27)	
I.G.C. Info. 96a056Structures\sa056ab3.dgn		sa056pr41	
Bridge Sheet No. BR451		Sheet 203 of 370	