
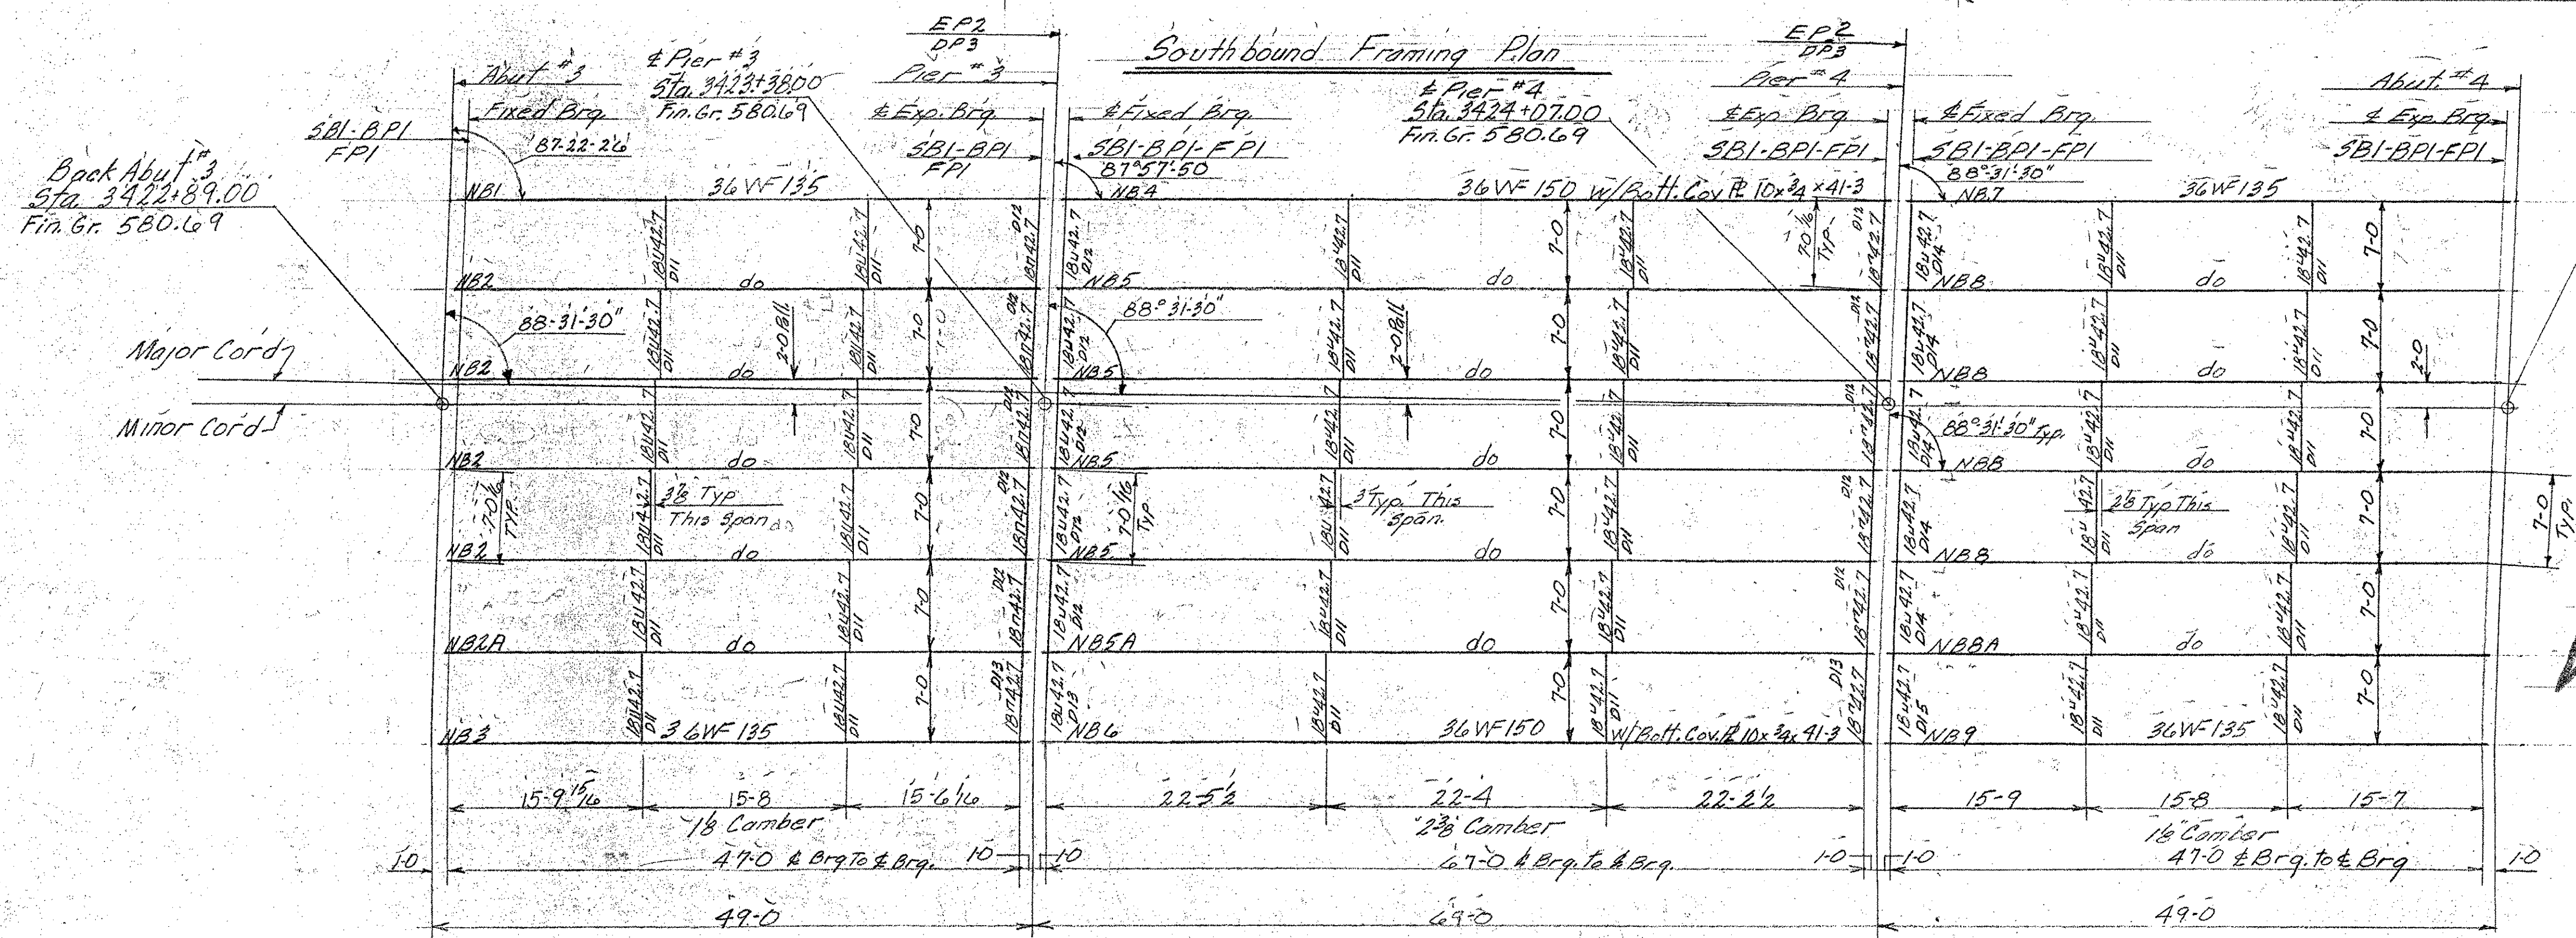
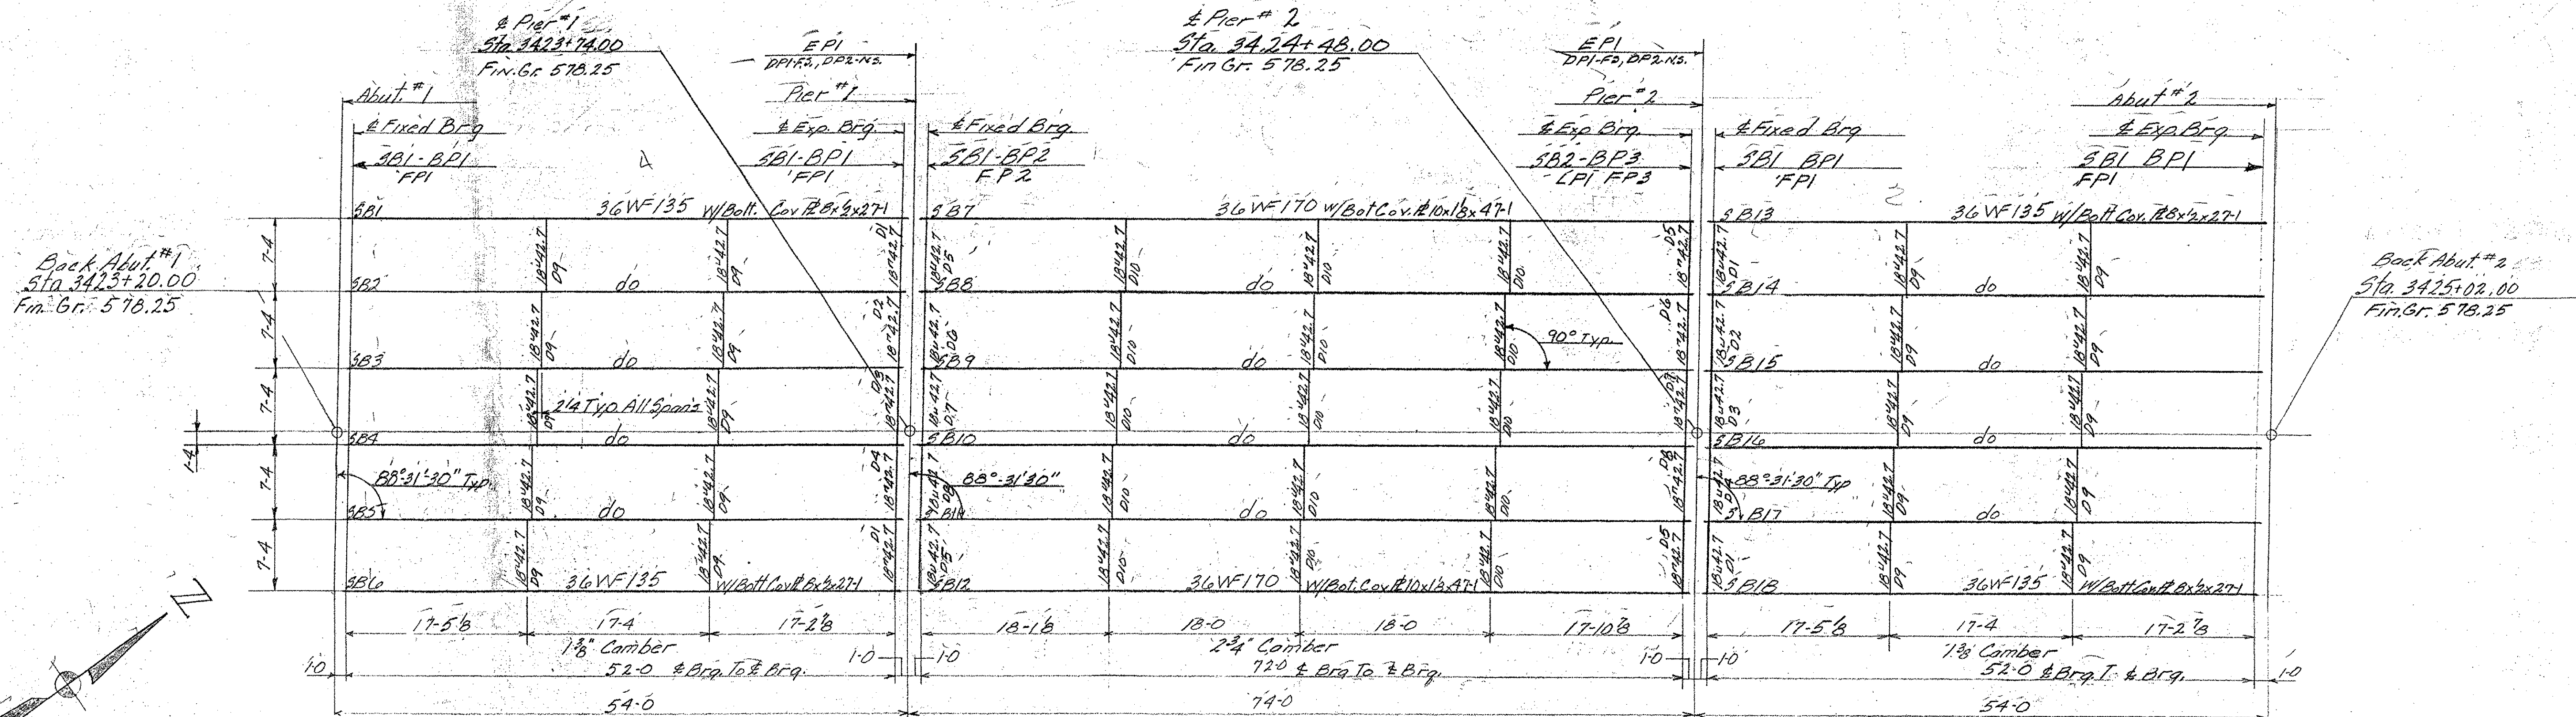


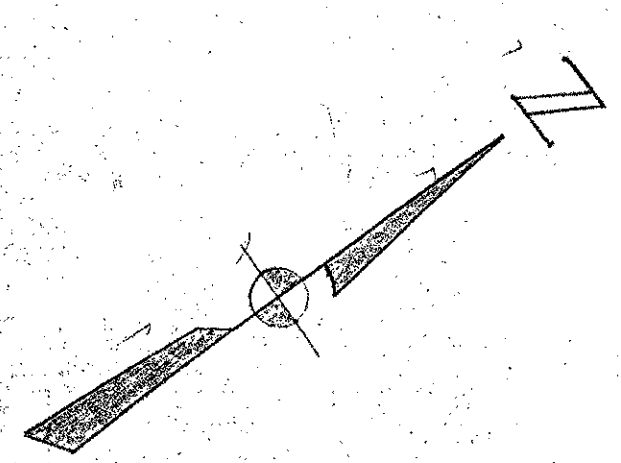

BRIDGE SHEET BR464
REFERENCE SHEET 10 OF 37
SHEET 216 OF 370

Ext. Wgts. with
Weld corrections

Northbound Framing Plan

To be filed with Record Plans

VERMONT STRUCTURAL STEEL CORPORATION BURLINGTON, VT.			
PROJECT		T-89 Over Approach Road	
LOCATION		Georgia-Fairfax-Fairfield St. Means	
CUSTOMER		Lane Constr. Co.	
ARCHITECT		State of Vermont Dept. of Highways	
JOB NO.		66-1184-220	
SHEET NO.		E1	
DATE		11-7-66	
DRAWN BY		L.C.	
CHK'D BY		R.M.	
HOLES			
BOLTS			
PAINT		R.L. (VT. Spec.)	
PRINT RECORD			
NO.	FOR	DATE	
3	APP	11-21	
2	SHOF	11-21	
3	APP	11-21	
2	SHOF	11-21	
3	APP	11-21	
2	SHOF	11-21	

2 LANE 12-28
DWEL 12-7-66
2 LANE 12-7-66