
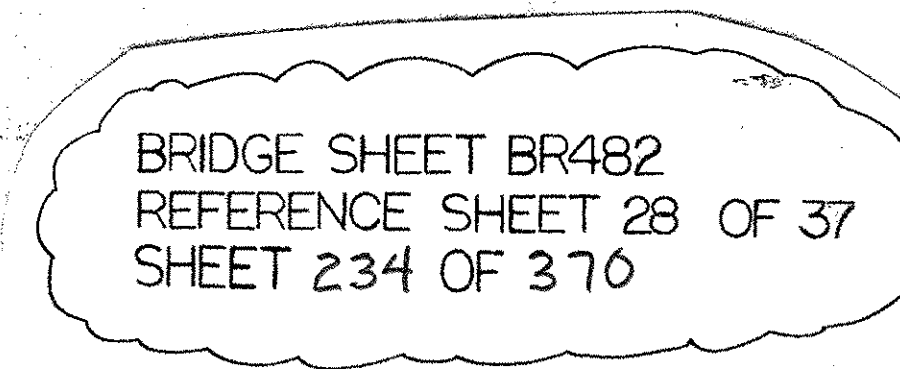


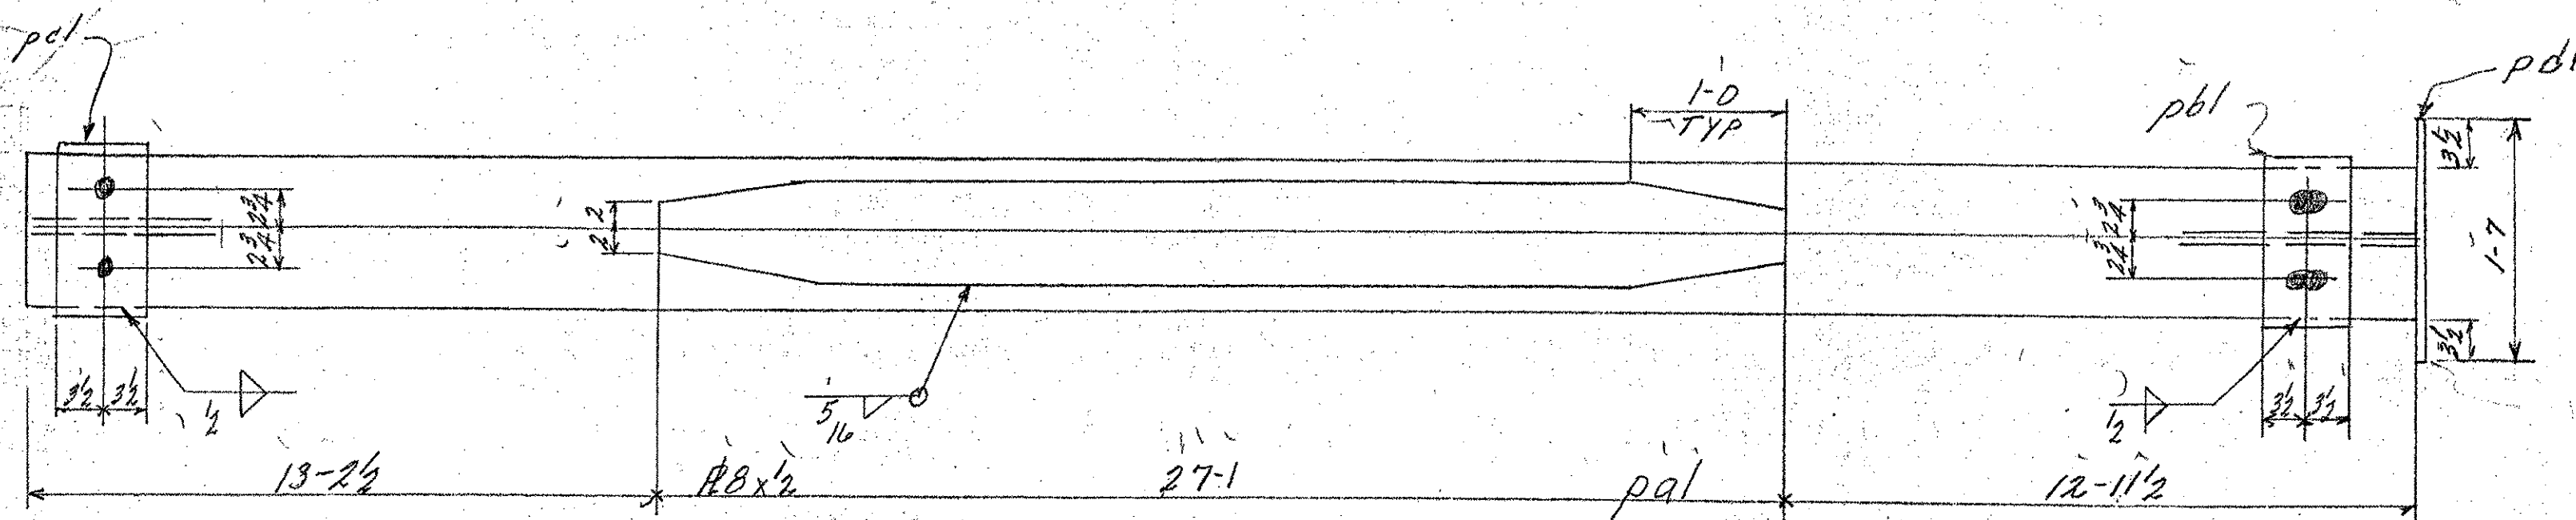

SPR 05 PAs Noted 661104 LANE 12-22