


# Crossover Sections To Begin Southbound Detour

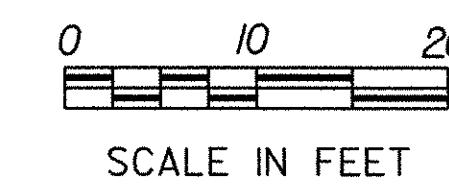

PROJECT:	FAIRFAX-FAIRFIELD-ST. ALBANS	PROJECT NO.:	IM 089-3(27)
DESIGN FILE NAME:	/87A007B/DESIGN/DA007SBC.DGN	PLOT DATE:	19-AUG-2000
IPARM FILE NAME:	DA007SXI	SURVEY DATE:	11/95
SURVEYED BY:	GILMAN	DRAWN BY:	SQUAD_B
SQUAD LEADER:	DELLA SANTA	SHEET:	268 OF 370