



RAMP C DETOUR PROFILE

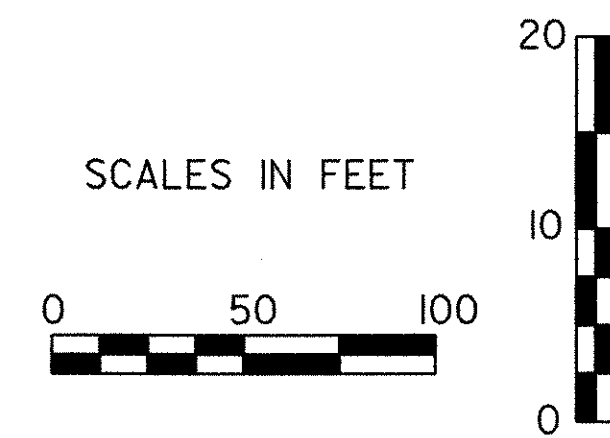


- TEMPORARY TRAFFIC BARRIER
- RAMP C DETOUR 71+70 LT - 86+00 LT
- RAMP C DETOUR 71+70 RT - 87+08 RT
- TEMPORARY 6'' WHITE LINE
- RAMP C DETOUR 70+00 RT - 87+00 RT
- TEMPORARY 6'' YELLOW LINE
- RAMP C DETOUR 70+75 LT - 86+25 LT

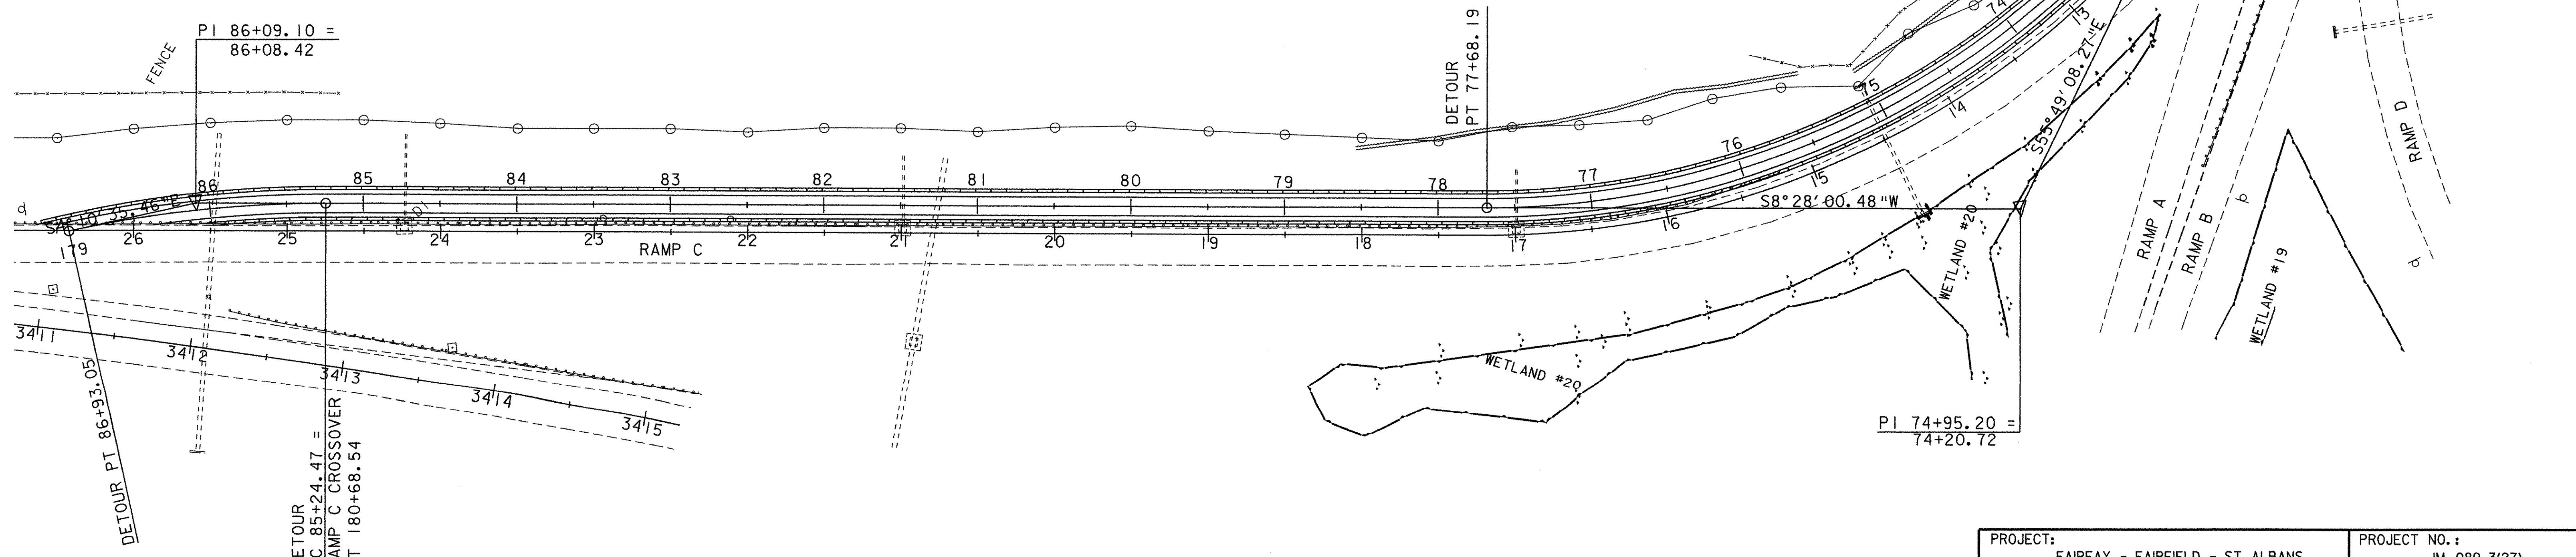

DATUM
 VERTICAL NAVD88
 HORIZONTAL NAD83(92)

DETOUR
 PC 85+24.47 =
 RAMP C CROSSOVER
 PT 180+68.54

RAMP C DETOUR

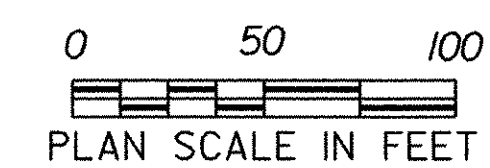

| | |
|---|------------------------------|
| PROJECT: FAIRFAX - FAIRFIELD - ST. ALBANS | PROJECT NO.: IM 089-3(27) |
| DESIGN FILE NAME: /87A007B/DESIGN/DA007RMC.DGN | PLOT DATE: 19-AUG-2000 |
| IPARM FILE NAME: DA007RCD | SURVEY DATE: 6/98 |
| SURVEYED BY: ORVIS | DRAWN BY: SQUAD B |
| SQUAD LEADER: DELLA SANTA | SHEET: 272 OF 370 |