
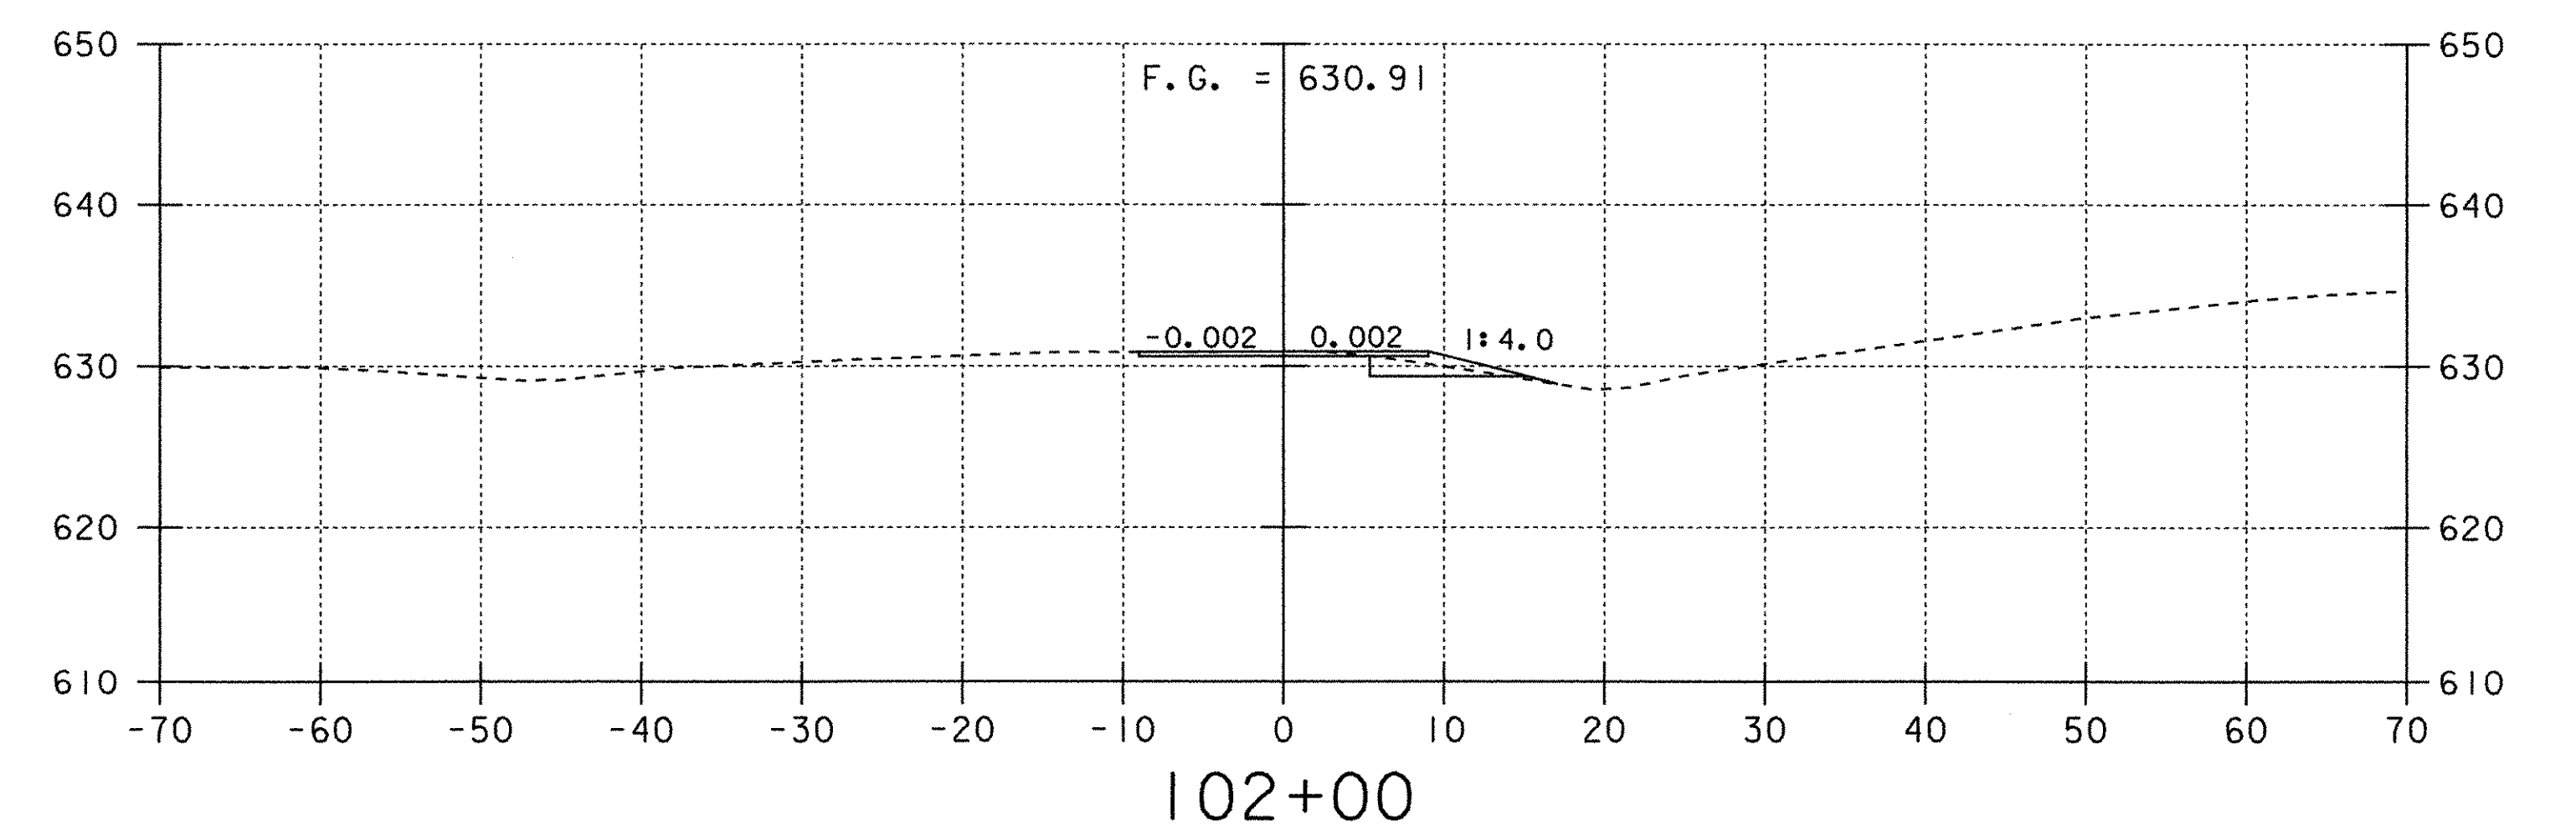
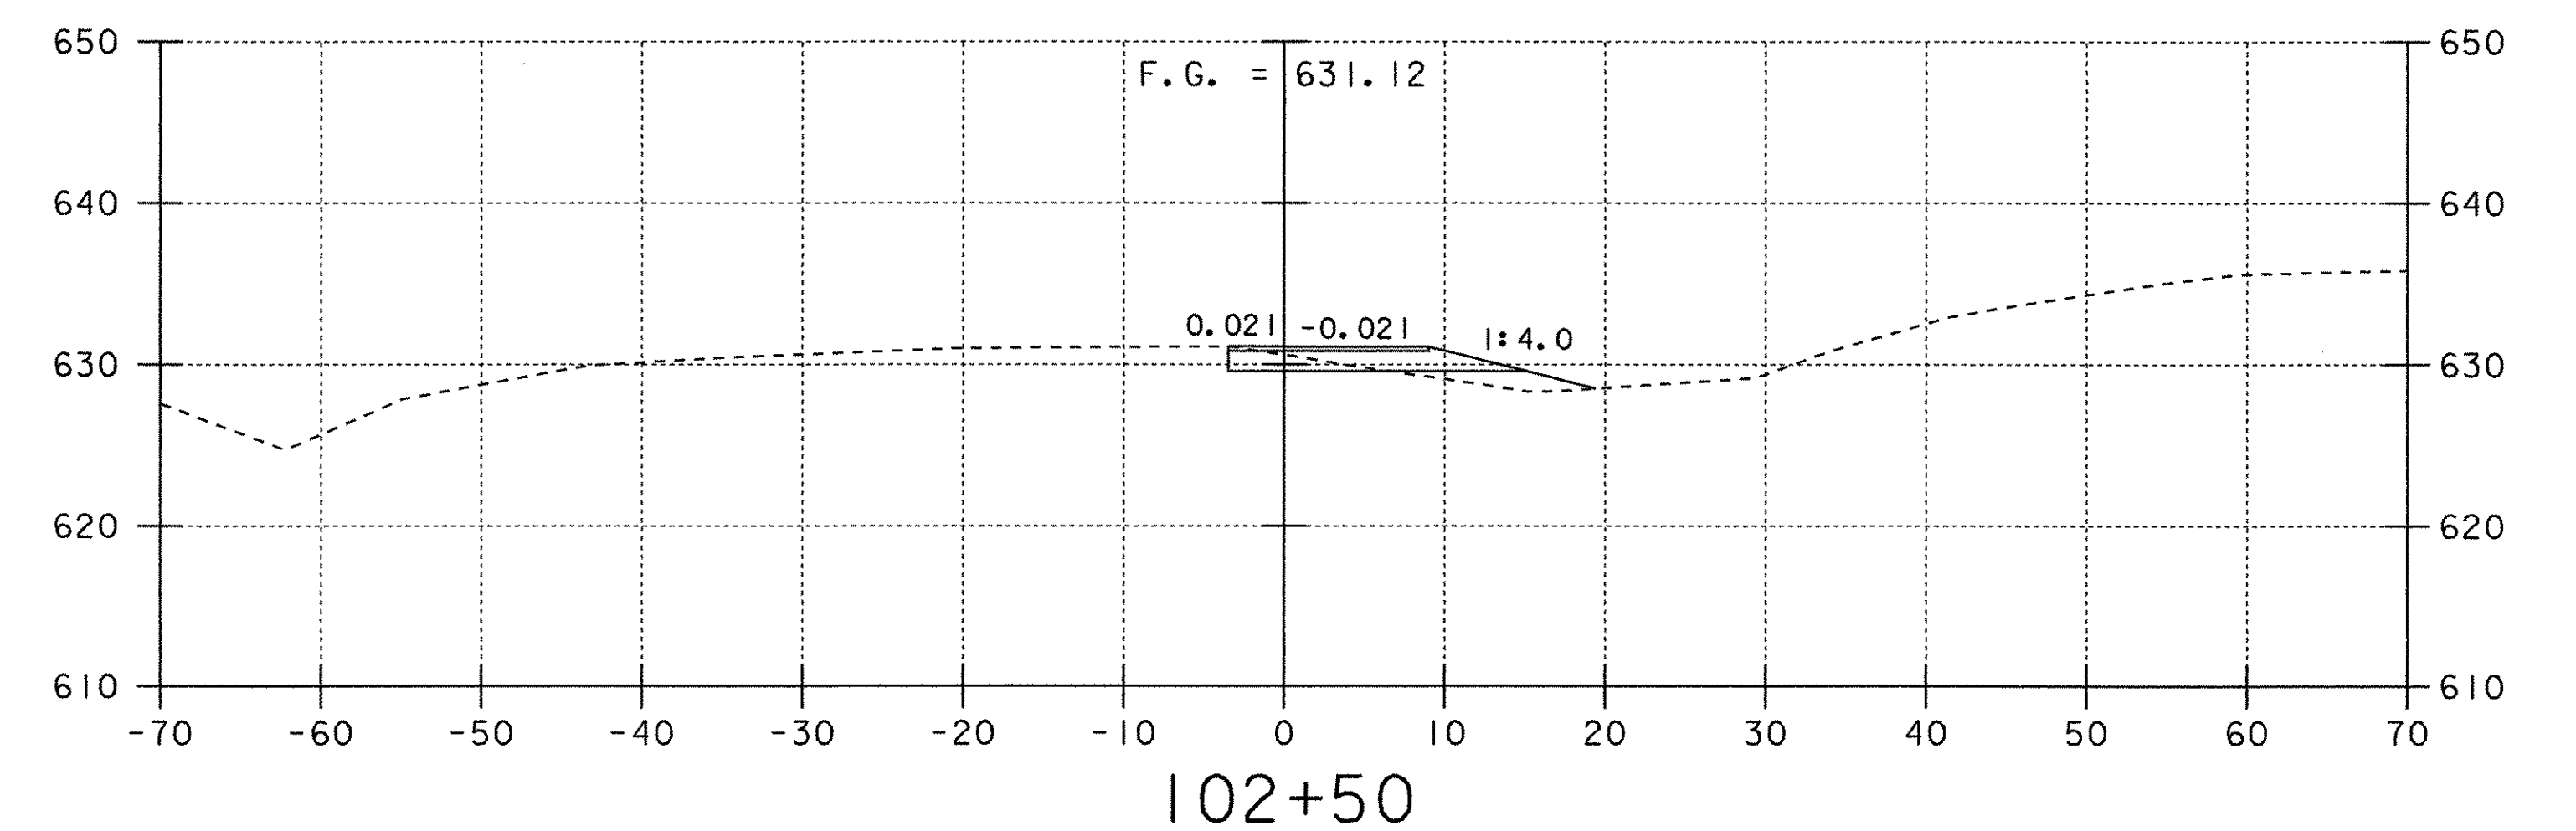
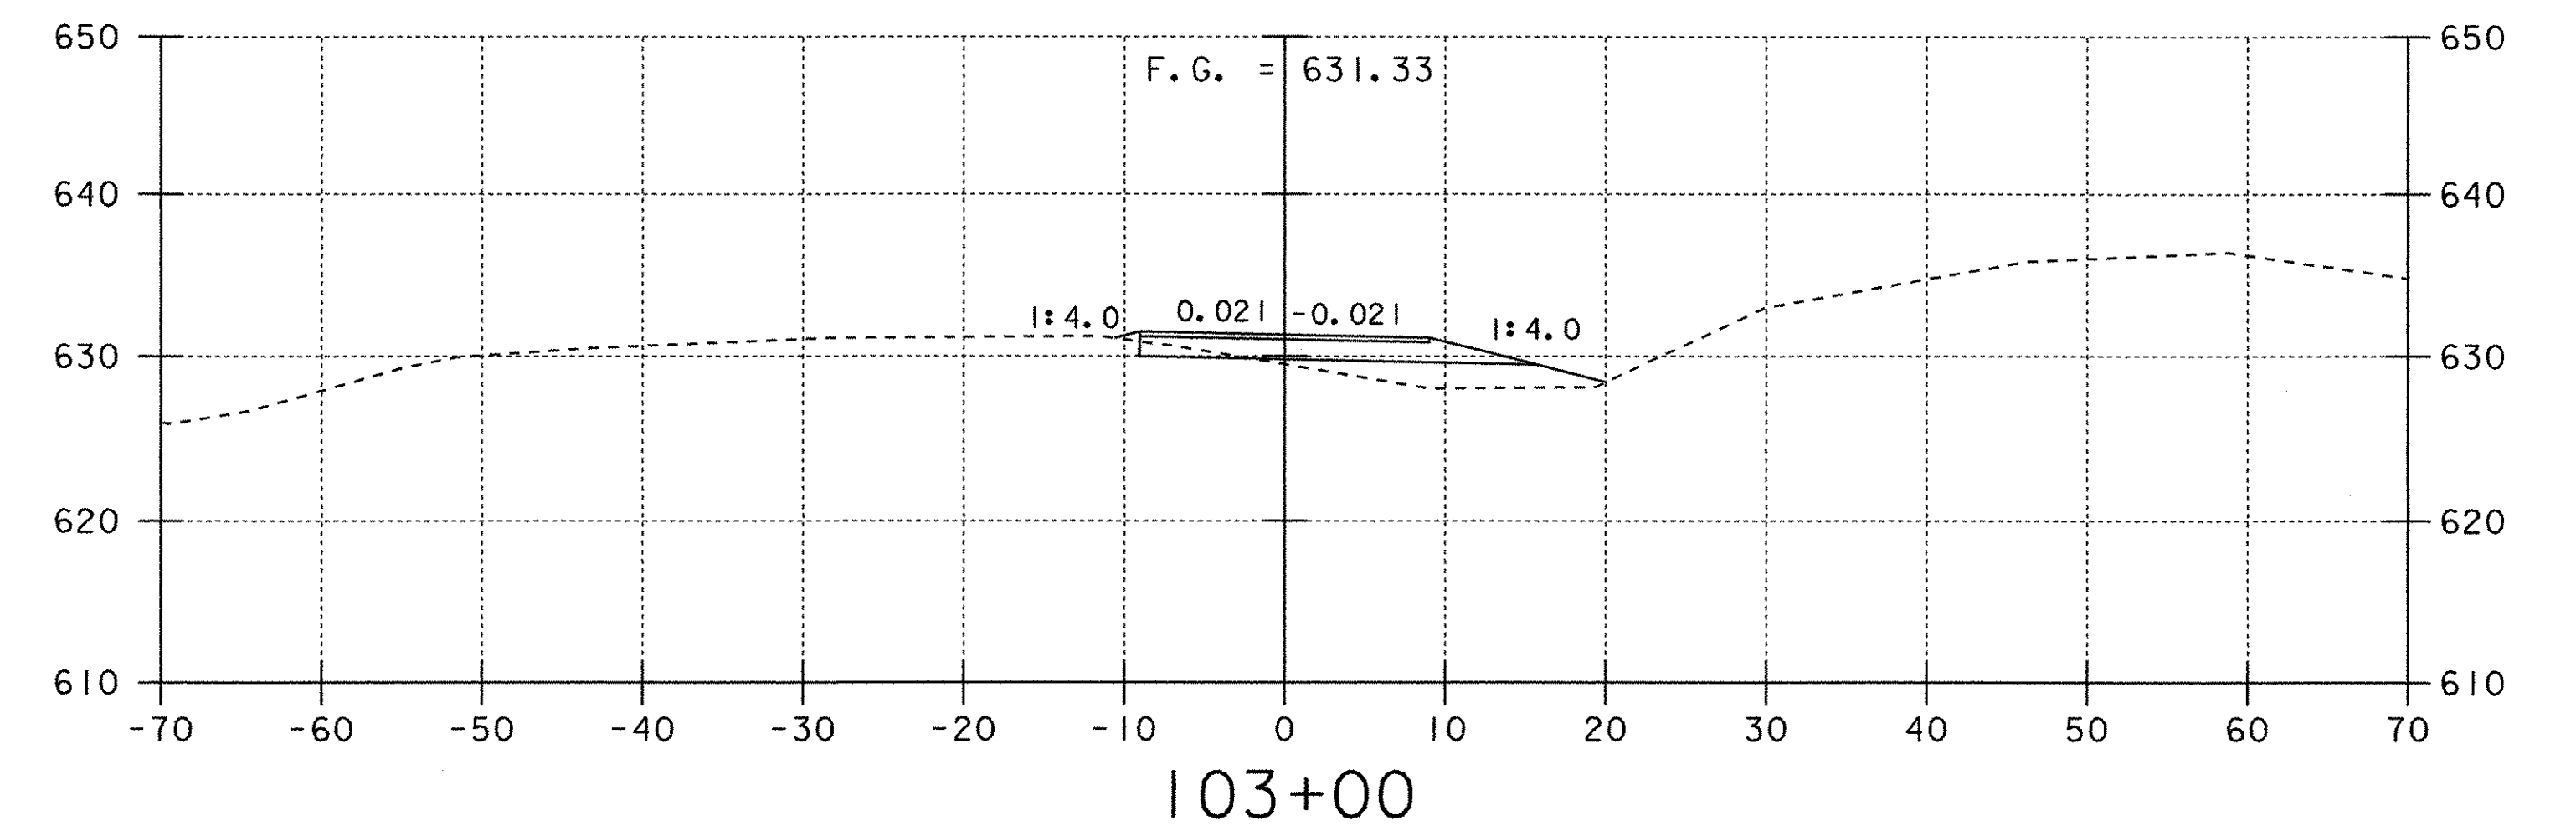
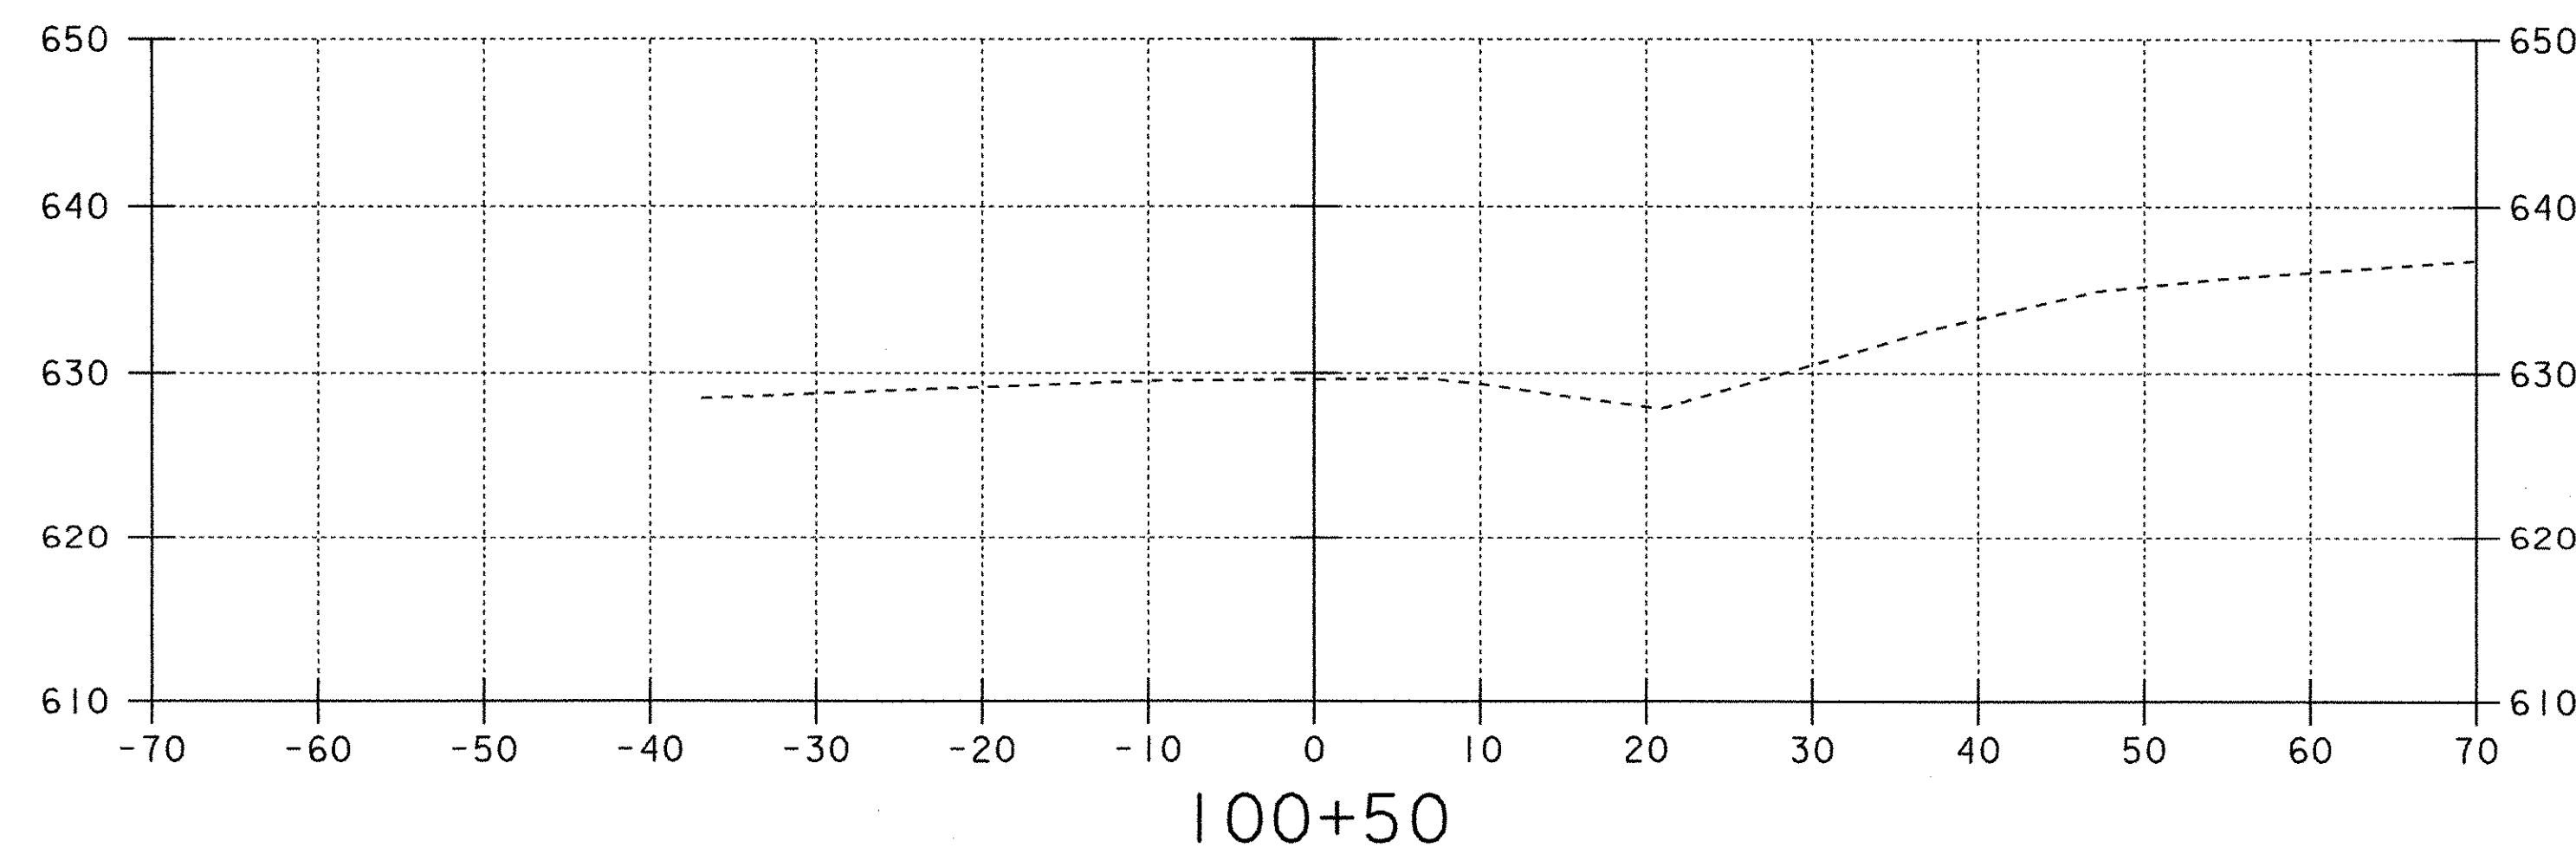
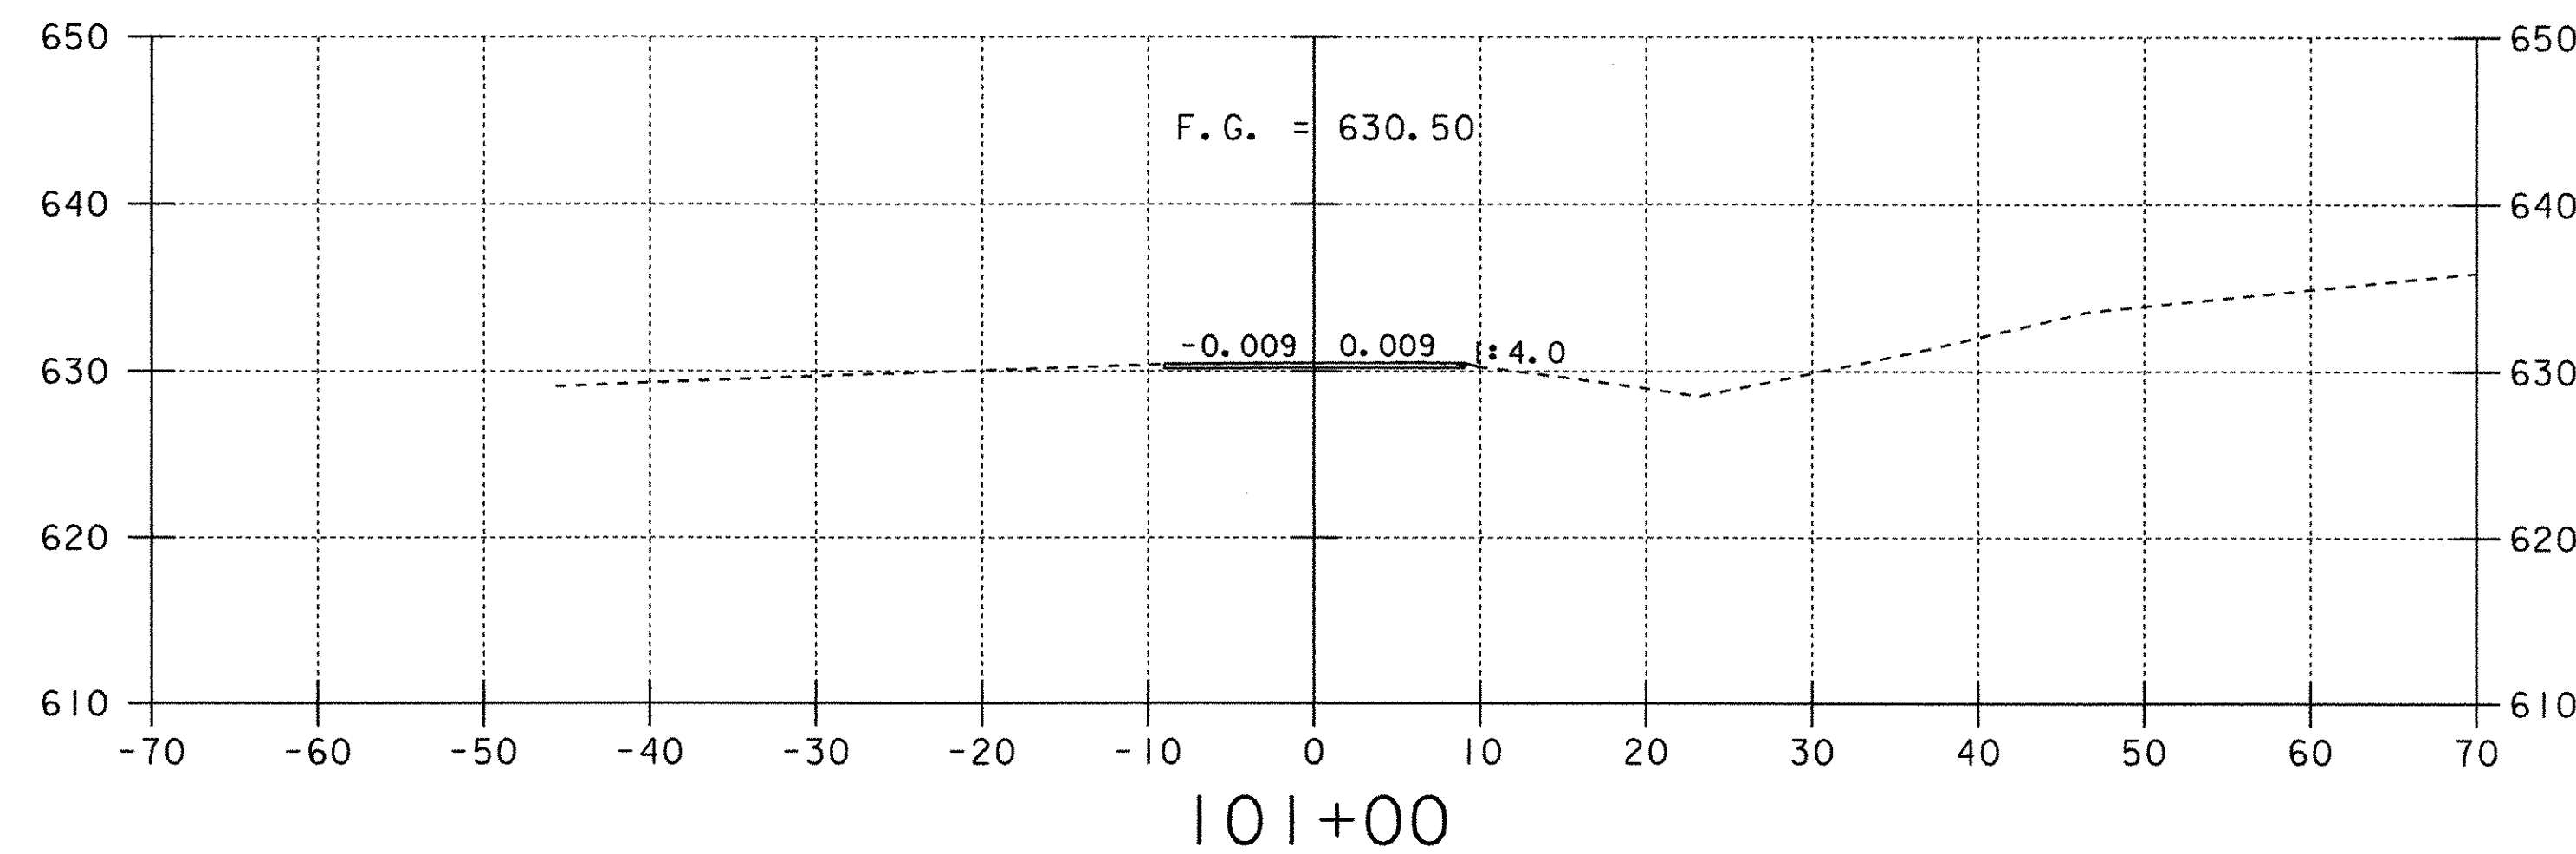


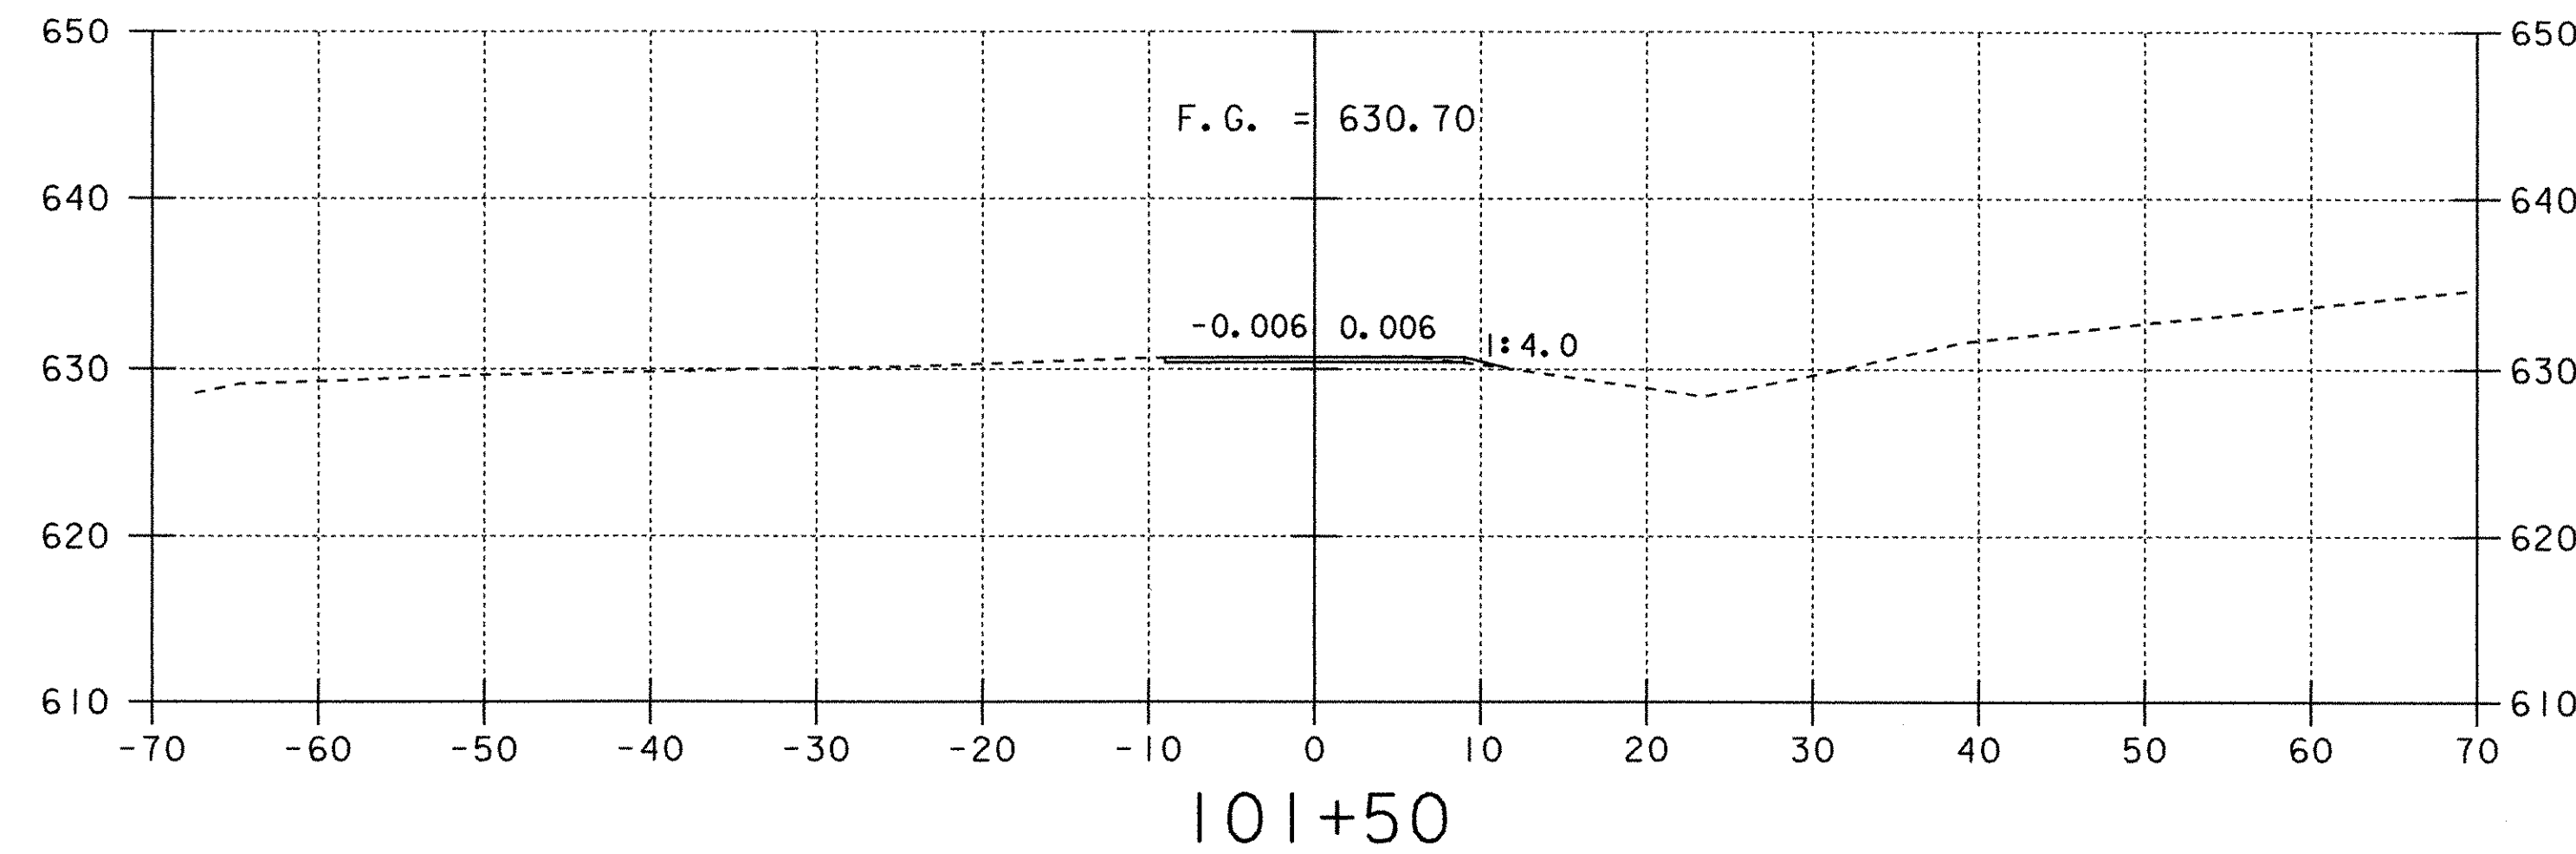

Crossover Sections To End Southbound Detour

0 10 20
SCALE IN FEET

PROJECT:	FAIRFAX-FAIRFIELD-ST. ALBANS	PROJECT NO.:	IM 089-3(27)
DESIGN FILE NAME:	/87A007B/DESIGN/DA007SBA.DGN	PLOT DATE:	13-SEP-2000
IPARM FILE NAME:	DA007SX5	SURVEYED BY:	ORVIS
SURVEYED BY:	ORVIS	SURVEY DATE:	11/95
SQUAD LEADER:	DELLA SANTA	DRAWN BY:	SQUAD B
		SHEET:	279 OF 370