


Crossover Cross Sections To Begin Northbound Detour

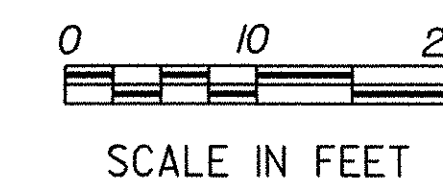

PROJECT:	FAIRFAX-FAIRFIELD-ST. ALBANS	PROJECT NO.:	IM 089-3(27)
DESIGN FILE NAME:	/87A007DESIGN/DA007NBA.DGN	PLOT DATE:	22-AUG-2000
IPARM FILE NAME:	DA007NX2	SURVEY DATE:	11/95
SURVEYED BY:	ORVIS	DRAWN BY:	SQUAD B
SQUAD LEADER:	DELLA SANTA	SHEET:	287 OF 370