




45+50

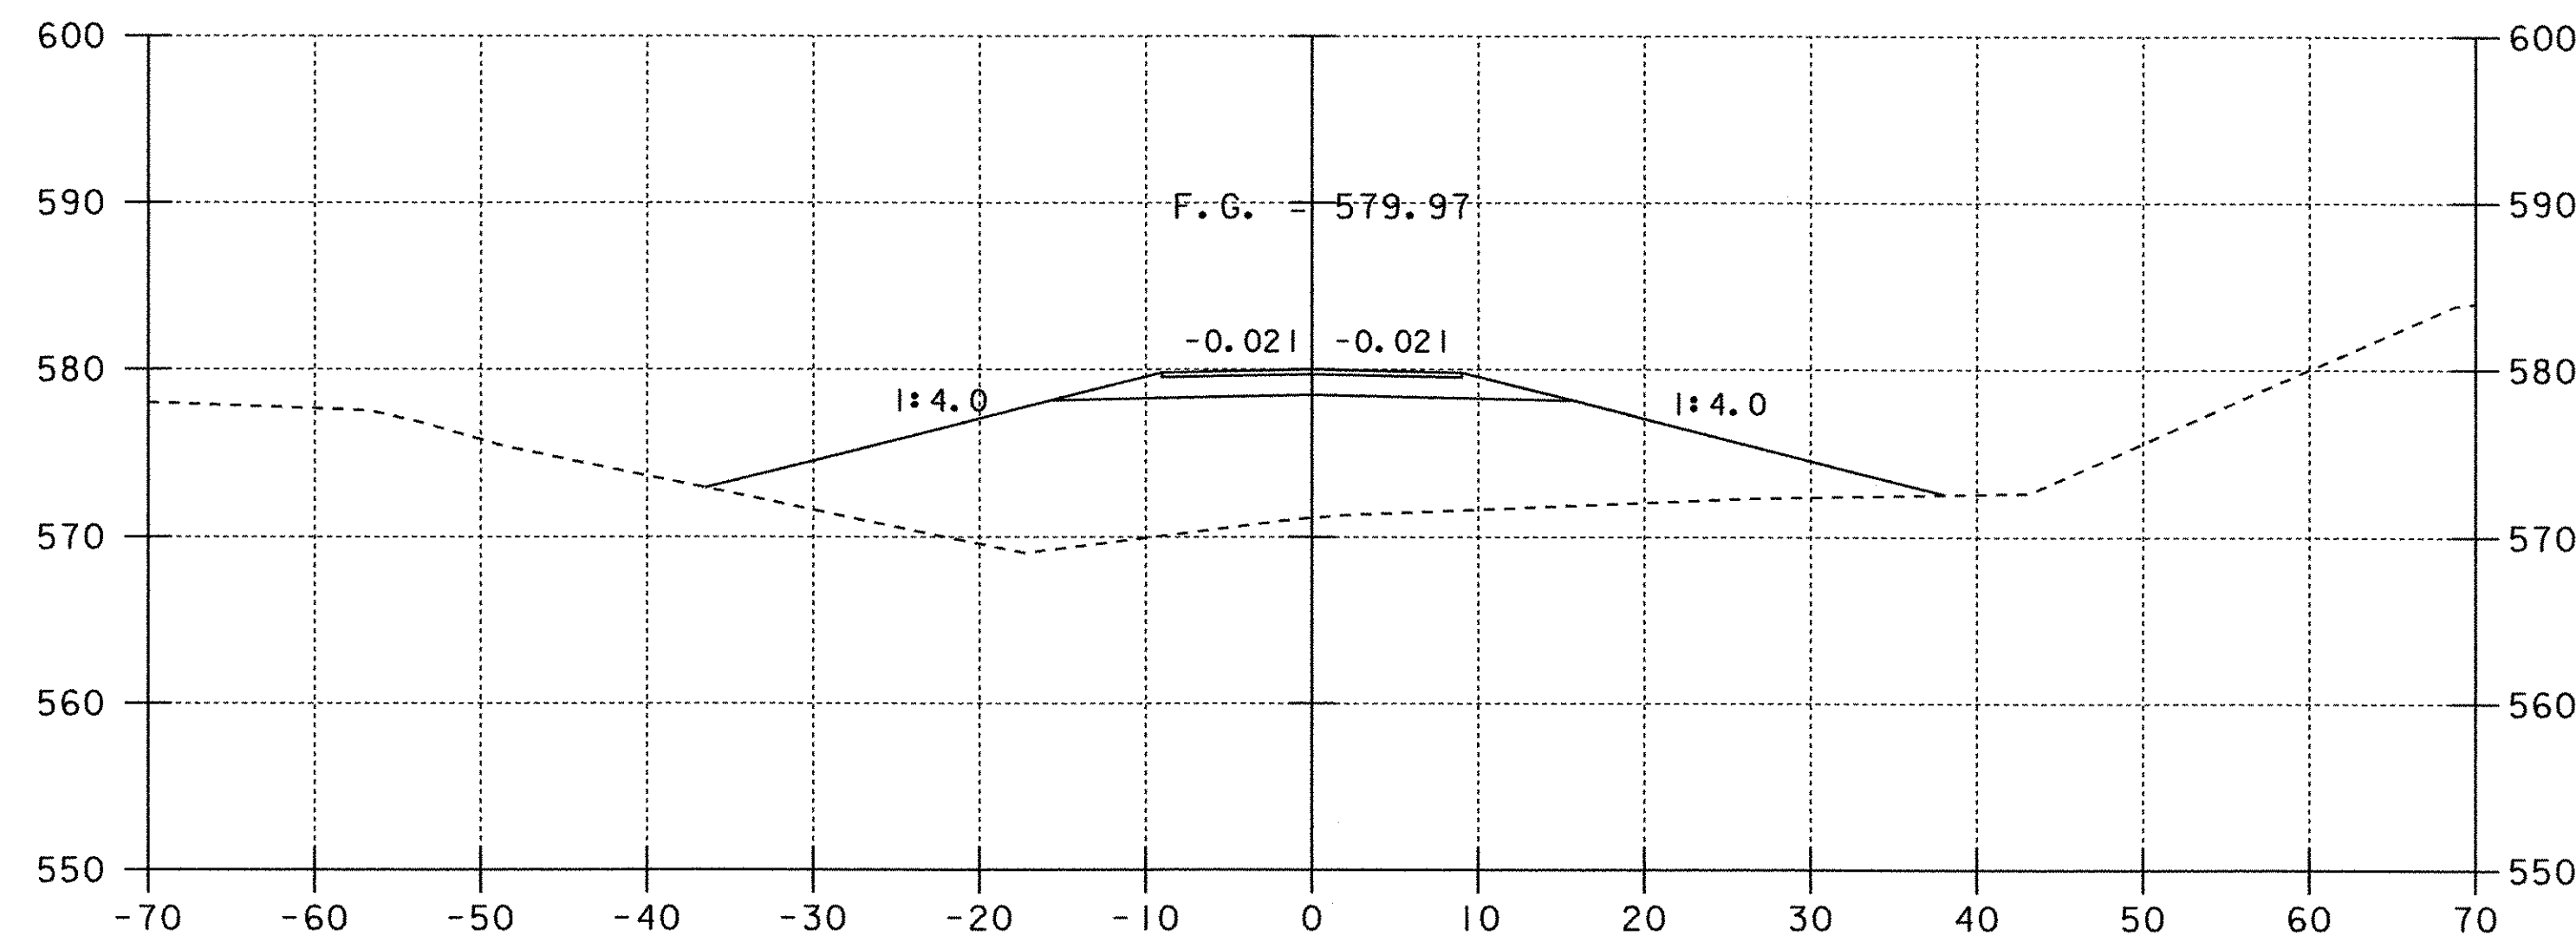


45+00

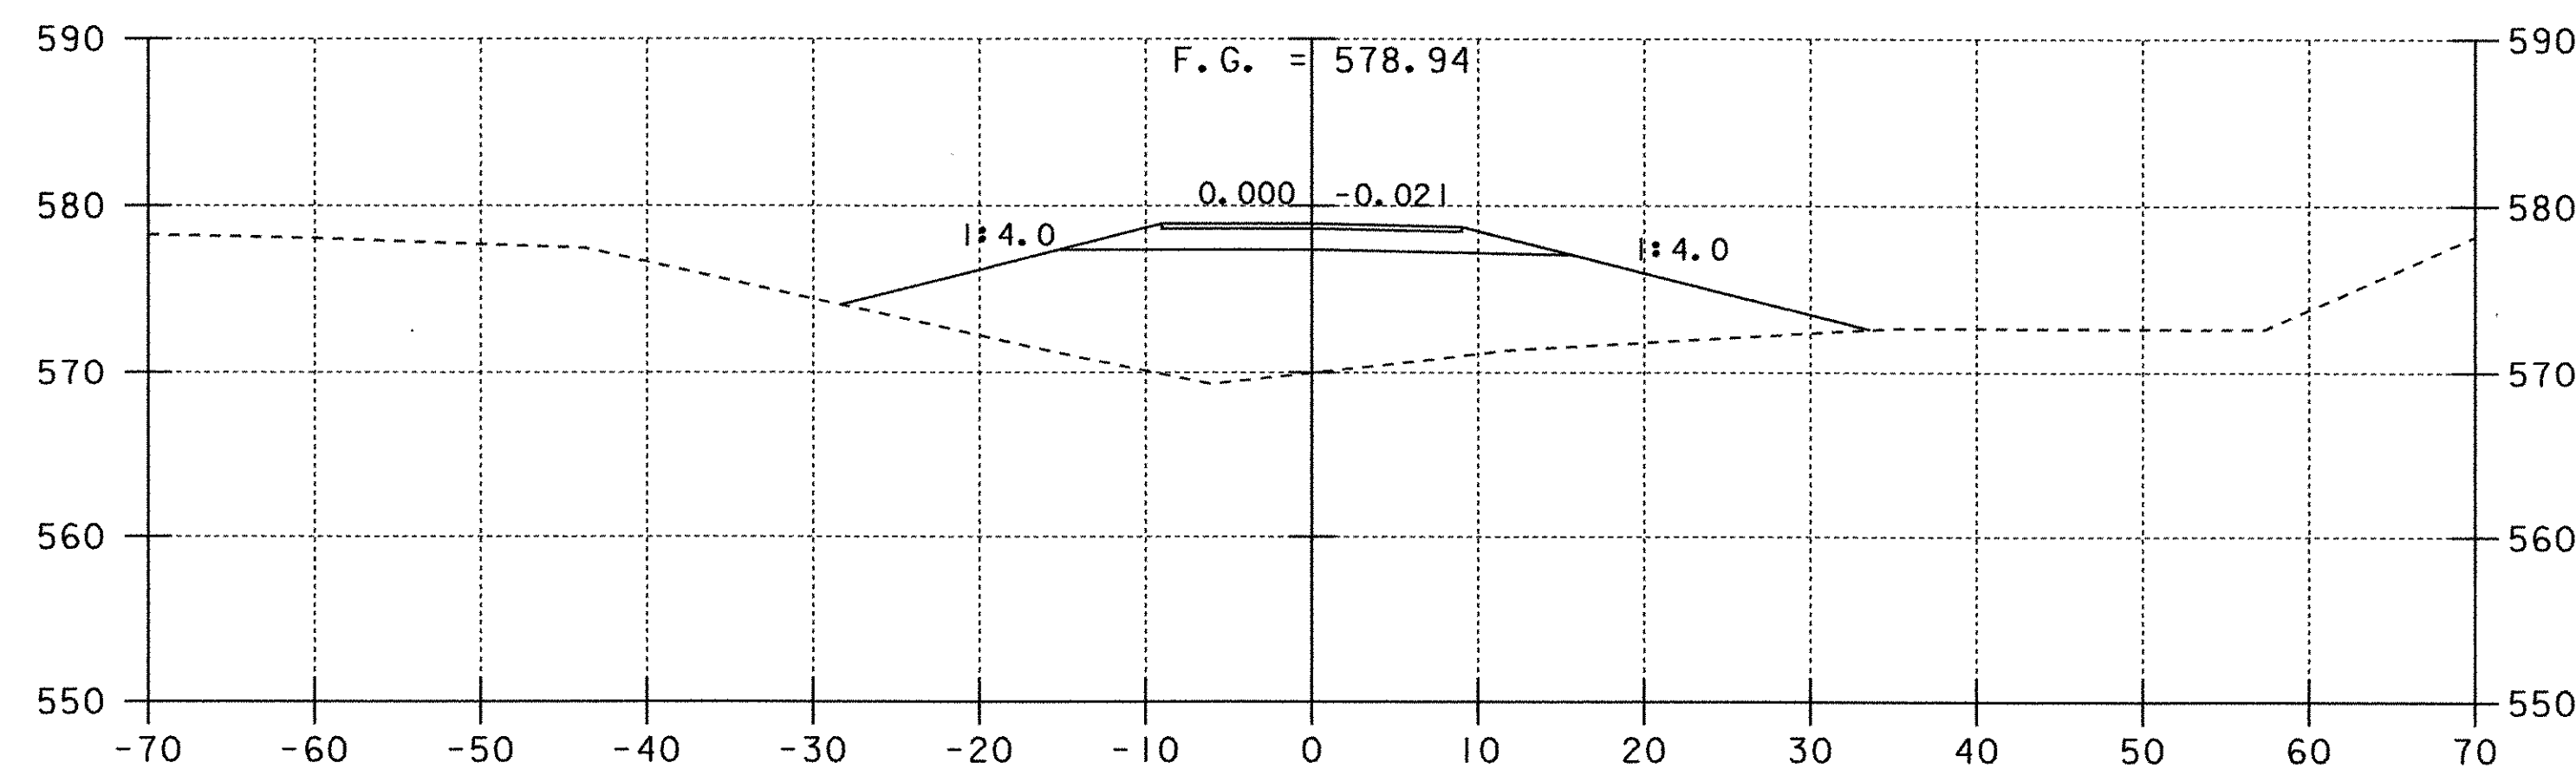


44+50

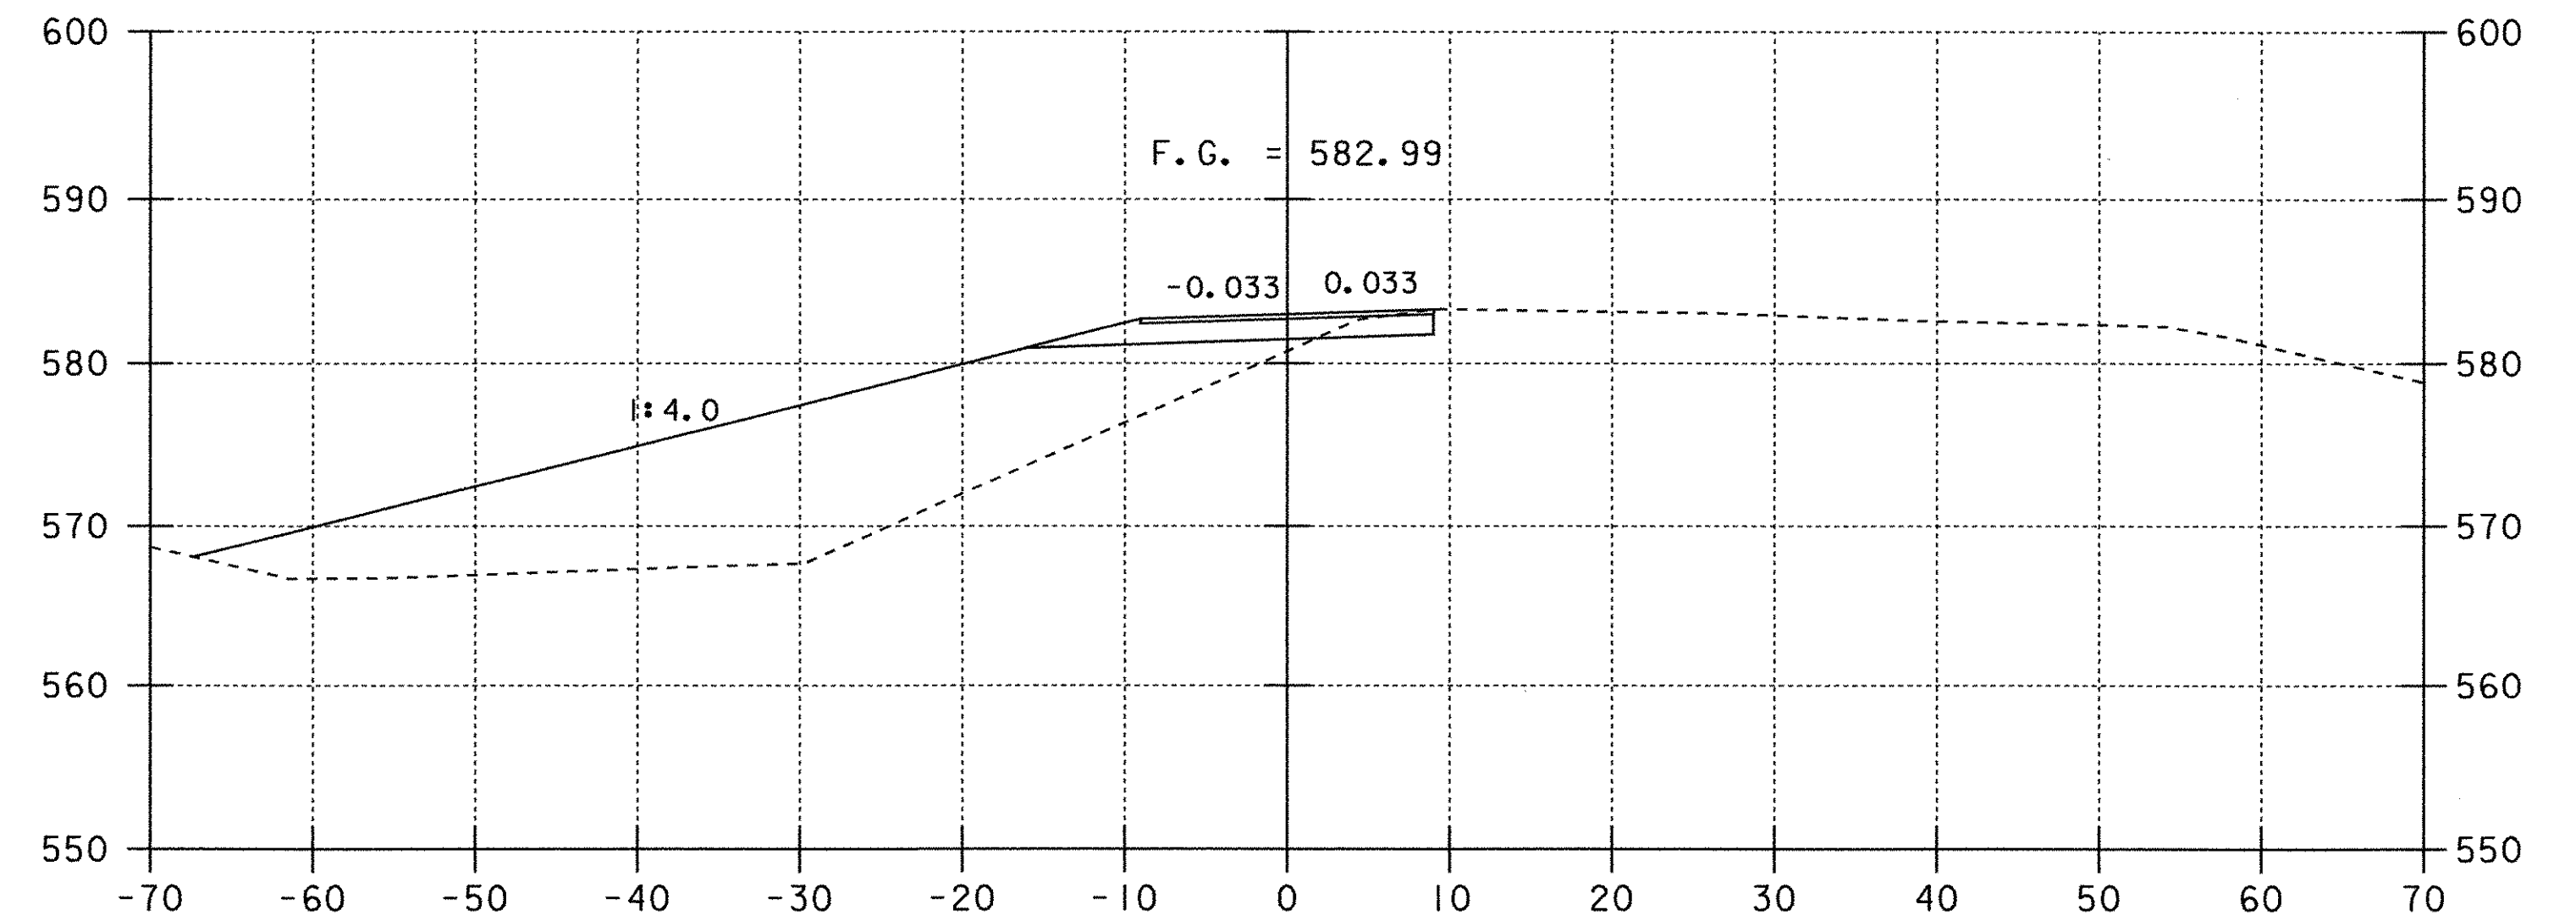


47+00

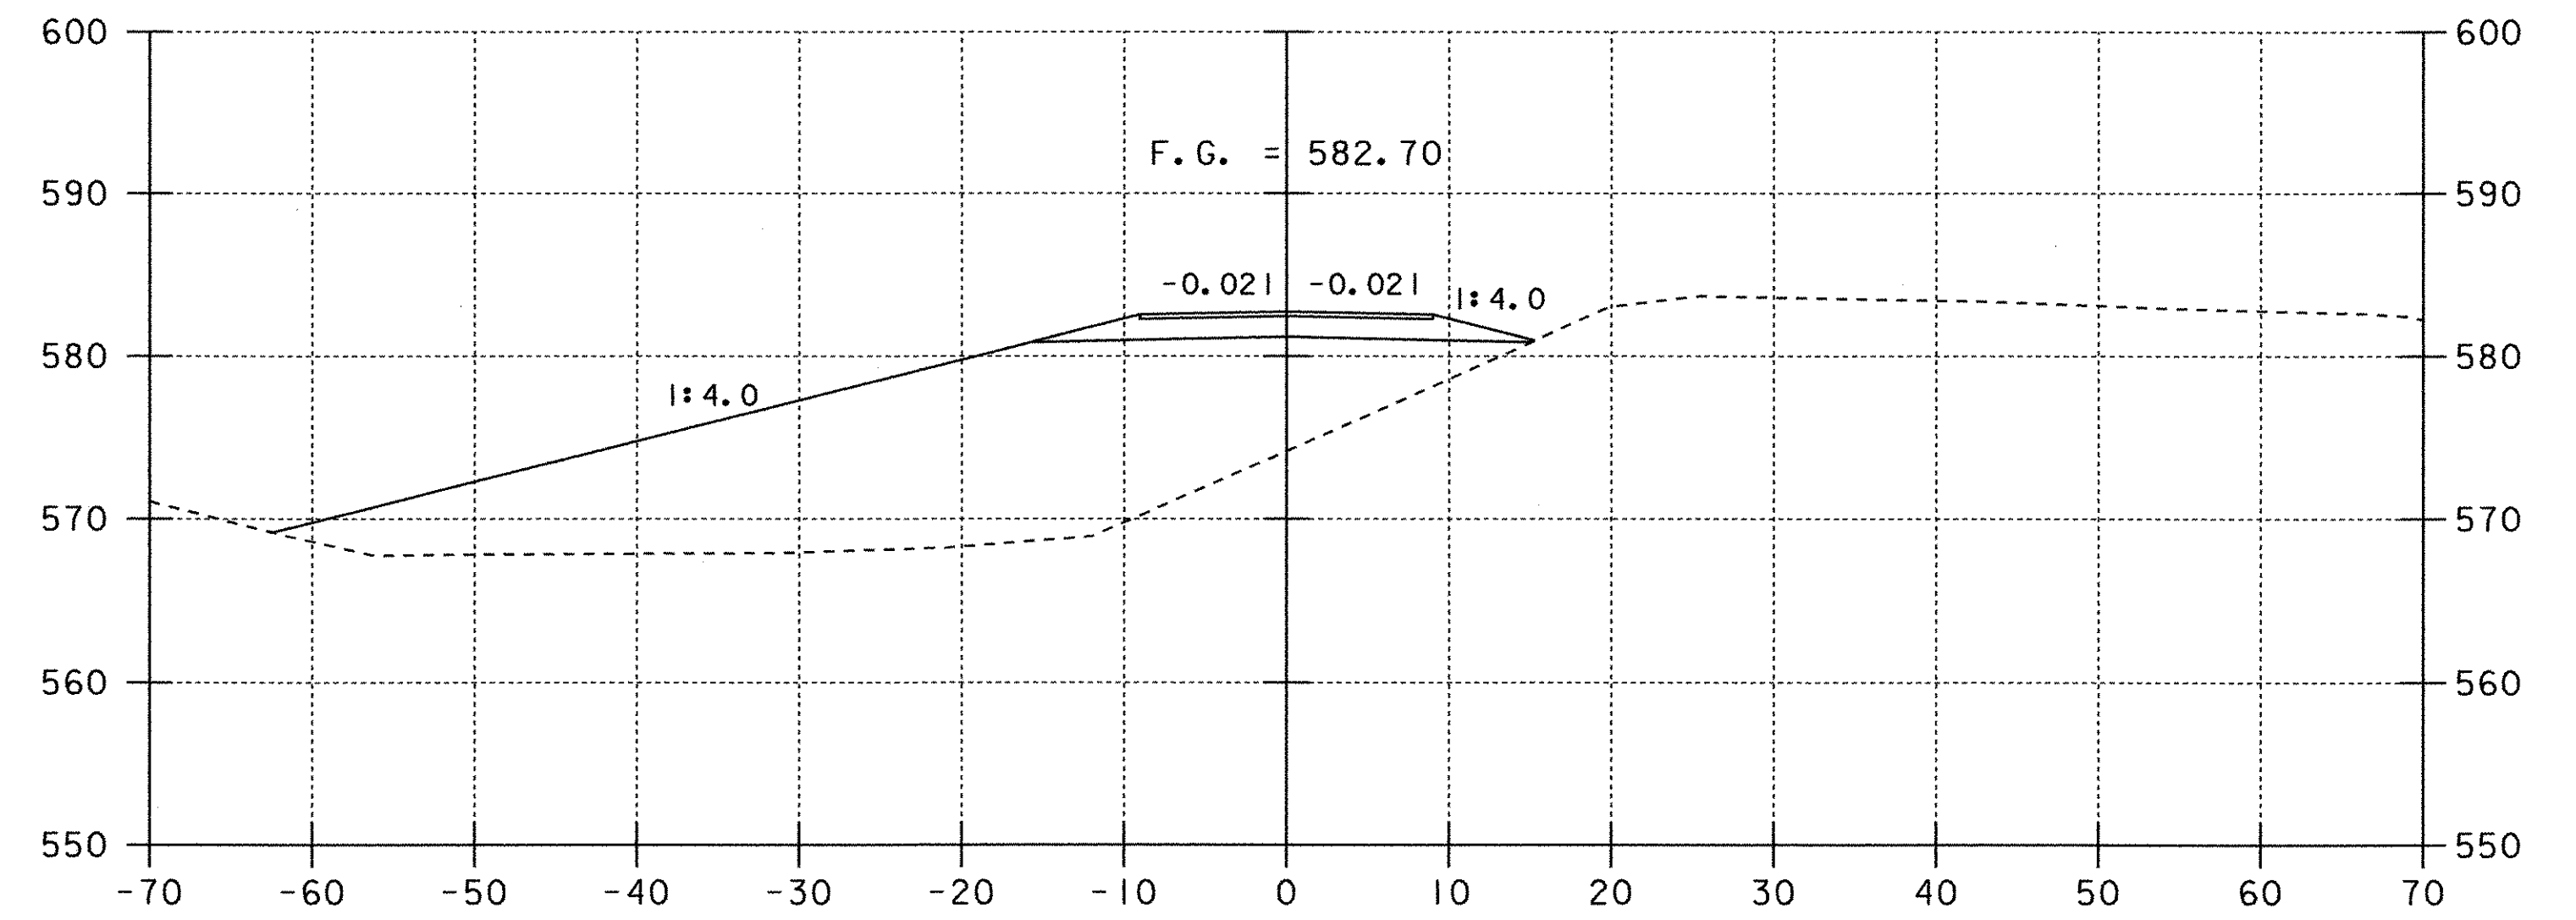

46+50

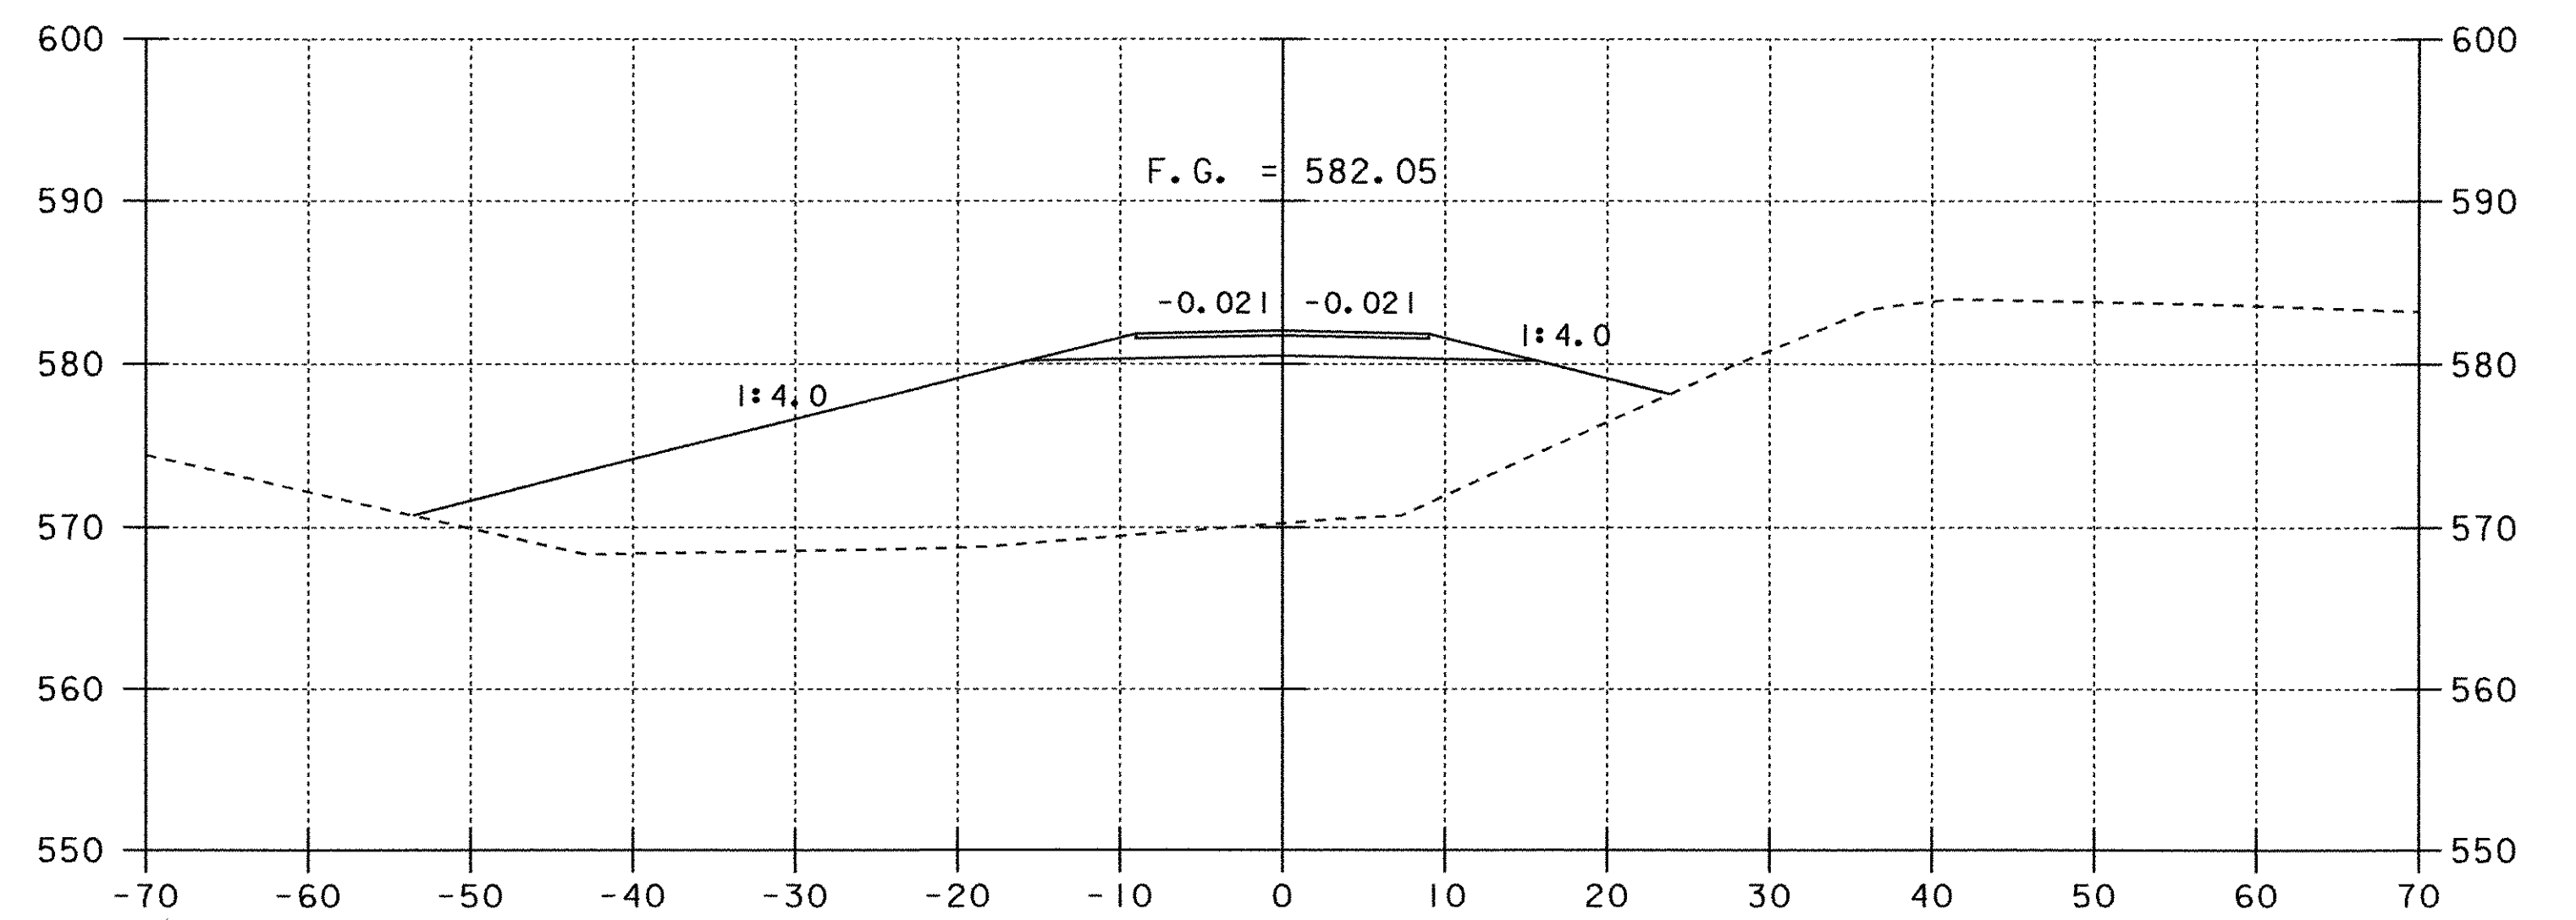

46+00

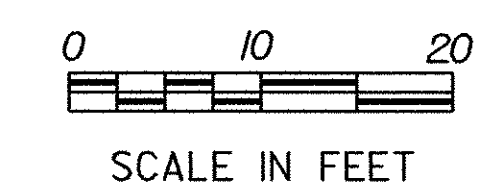

SCALE IN FEET

PROJECT:	FAIRFAX-FAIRFIELD-ST. ALBANS	PROJECT NO.:	IM 089-3(27)
DESIGN FILE NAME:	/87A007B/DESIGN/DA007N9.DGN	PLOT DATE:	22-AUG-2000
IPARM FILE NAME:	DA007BX2	SURVEY DATE:	J/95
SURVEYED BY:	GILMAN	DRAWN BY:	SQUAD B
SQUAD LEADER:	DELLA SANTA	SHEET:	290 OF 370

NORTHBOUND CROSSOVER TO RAMP B