

FOR CROSSOVER DETOUR  
TEMPORARY 6'' YELLOW LINE  
 NB CROSSOVER 52+00 - 57+00 (LT. SOLID EDGE LINE)  
TEMPORARY 6'' WHITE LINE  
 NB CROSSOVER 52+00 - 57+00 (RT. SOLID EDGE LINE)


FOR EXIT TRANSITION FROM CROSSOVER DETOUR  
TEMPORARY 6'' YELLOW LINE (MODIFIED)  
 NB MM 114.23 - 114.30 (LEFT SOLID EDGE LINE) (APPROXIMATE)  
TEMPORARY 6'' WHITE LINE (MODIFIED)  
 NB MM 114.23 - 114.30 (RIGHT SOLID EDGE LINE) (APPROXIMATE)

MATCH LINE MM 114.01

MATCH LINE MM 114.13

DATUM	
VERTICAL	ASSUMED
HORIZONTAL	ASSUMED

CROSSOVER TO END NORTHBOUND DETOUR

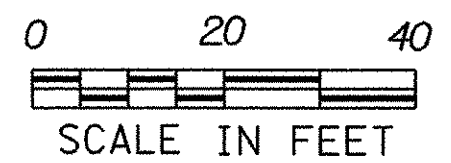

PROJECT: FAIRFAX-FAIRFIELD-ST. ALBANS	PROJECT NO.: IM_089-3(27)
DESIGN FILE NAME: /BTA007B/DESIGN/DA007NBC.DGN	PLOT DATE: 19-AUG-2000
IPARM FILE NAME: DA007NB4	SURVEY DATE: JL/95
SURVEYED BY: GILMAN	DRAWN BY: SQUAD B
SQUAD LEADER: DELLA SANTA	SHEET: 291 OF 370