

END MERGING TAPER  
BEGIN TANGENT SECTION  
BETWEEN TAPER AND BARRIER

BEGIN MERGING TAPER

← SOUTHBOUND TRAFFIC MERGES RIGHT INTO SINGLE LANE

PT 57+82.03

NORTHBOUND TRAFFIC

N26°26'01.00"E

58


TWO LANE NORTHBOUND TRAFFIC RESUMES →

CROSSOVER  
STA 58+50 =  
MM 114.26

MATCH LINE MM 114.24

DATUM  
VERTICAL ASSUMED  
HORIZONTAL ASSUMED

# CROSSOVER TO END NORTHBOUND DETOUR

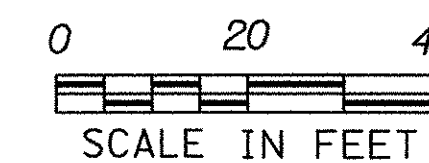

PROJECT: FAIRFAX-FAIRFIELD-ST. ALBANS	PROJECT NO.: IM 089-3(27)
DESIGN FILE NAME: /87A007B/DESIGN/DA007NBC.DGN	PLOT DATE: 19-AUG-2000
IPARM FILE NAME: DA007NB6	SURVEY DATE: 11/95
SURVEYED BY: GILMAN	DRAWN BY: SQUAD B
SQUAD LEADER: DELLA SANTA	SHEET: 293 OF 370