
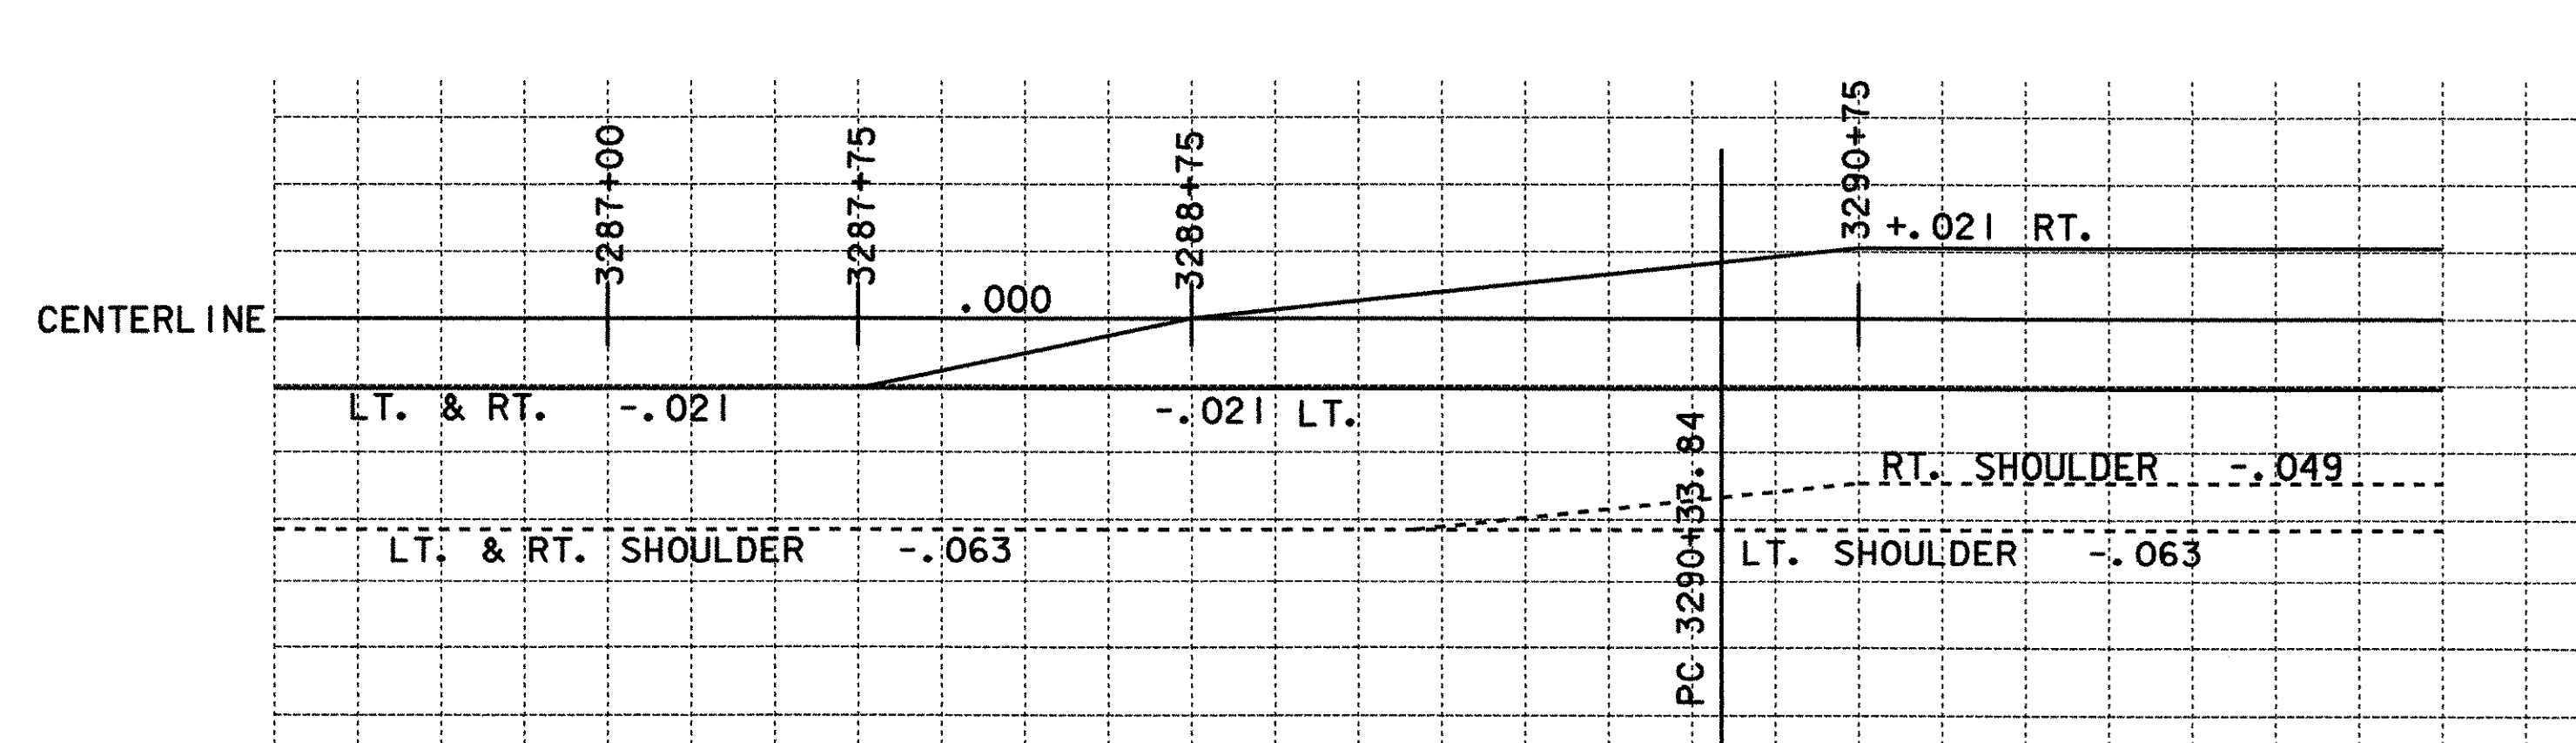


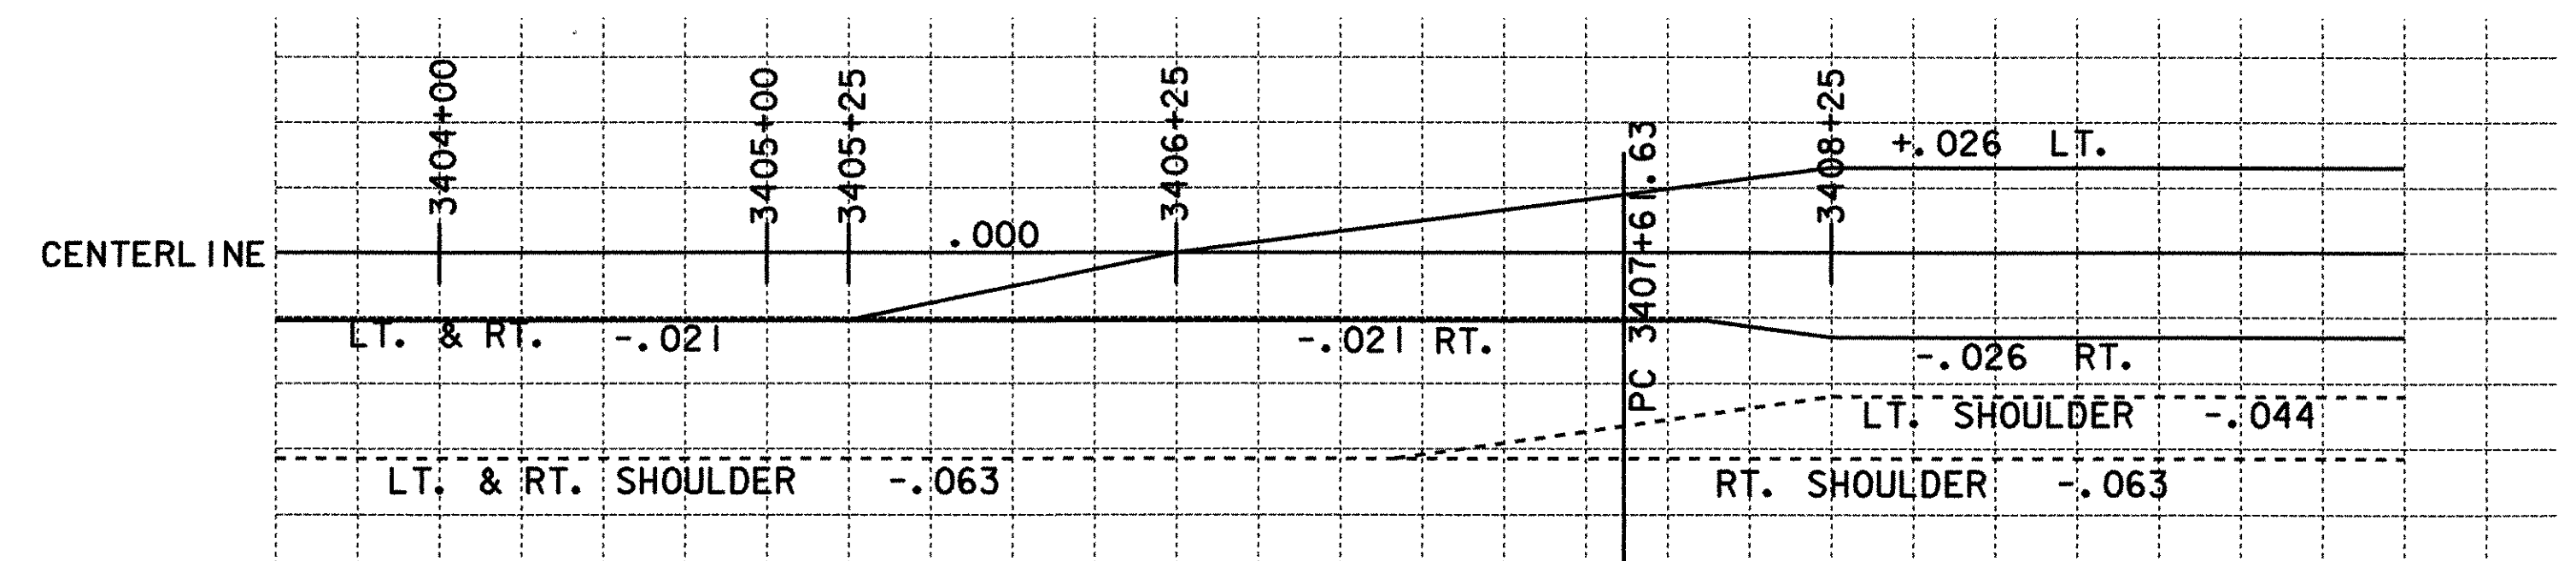

|                                              |                             |                              |             |
|----------------------------------------------|-----------------------------|------------------------------|-------------|
| PROJECT:<br>FAIRFAX - FAIRFIELD - ST. ALBANS |                             | PROJECT NO.:<br>IM 089-3(27) |             |
| DESIGN FILE NAME:                            | /87A007B/DESIGN/DA007XSLDGN | PLOT DATE:                   | 18-AUG-2000 |
| IPARM FILE NAME:                             | DA007BKN                    | SURVEY DATE:                 | 6/98        |
| SURVEYED BY:                                 | ORVIS                       | DRAWN BY:                    | SQUAD 8     |
| SQUAD LEADER:                                | DELLA SANTA                 | SHEET:                       | 297 OF 370  |