


NOTE: OFFSET DISTANCES ARE MEASURED FROM THE GRADE LINE.

RAMP C CROSS SECTIONS

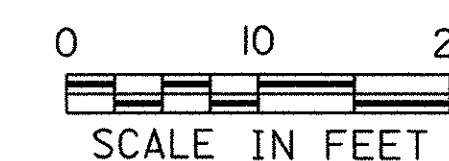

PROJECT: FAIRFAX - FAIRFIELD - ST. ALBANS		PROJECT NO.: IM 089-3(27)
DESIGN FILE NAME:	/87A007B/DESIGN/DA007RMC.DGN	PLOT DATE: 18-AUG-2000
IPARM FILE NAME:	DA007X49	SURVEY DATE: 6/98
SURVEYED BY:	ORVIS	DRAWN BY: SQUAD B
SQUAD LEADER:	DELLA SANTA	SHEET: 326 OF 370