




3329+54  
EXISTING 36'' ACCGMP

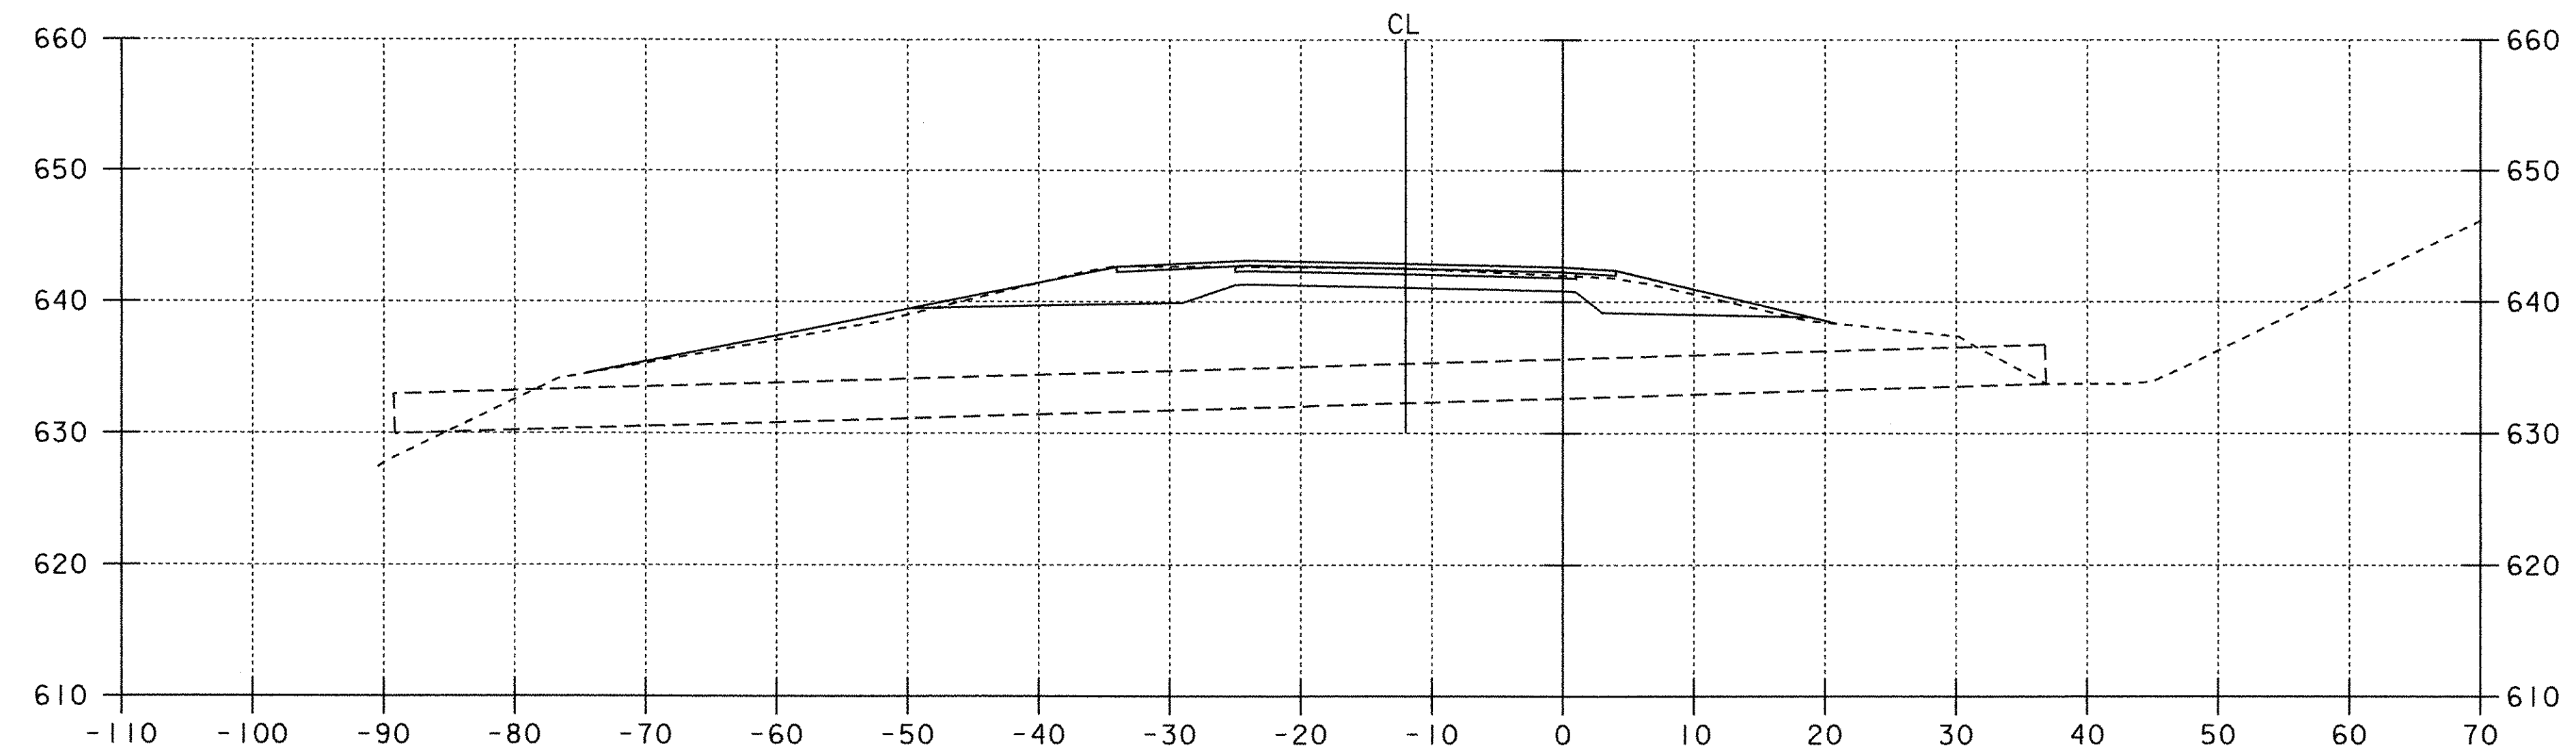

3323+97  
EXISTING 36'' ACCGMP

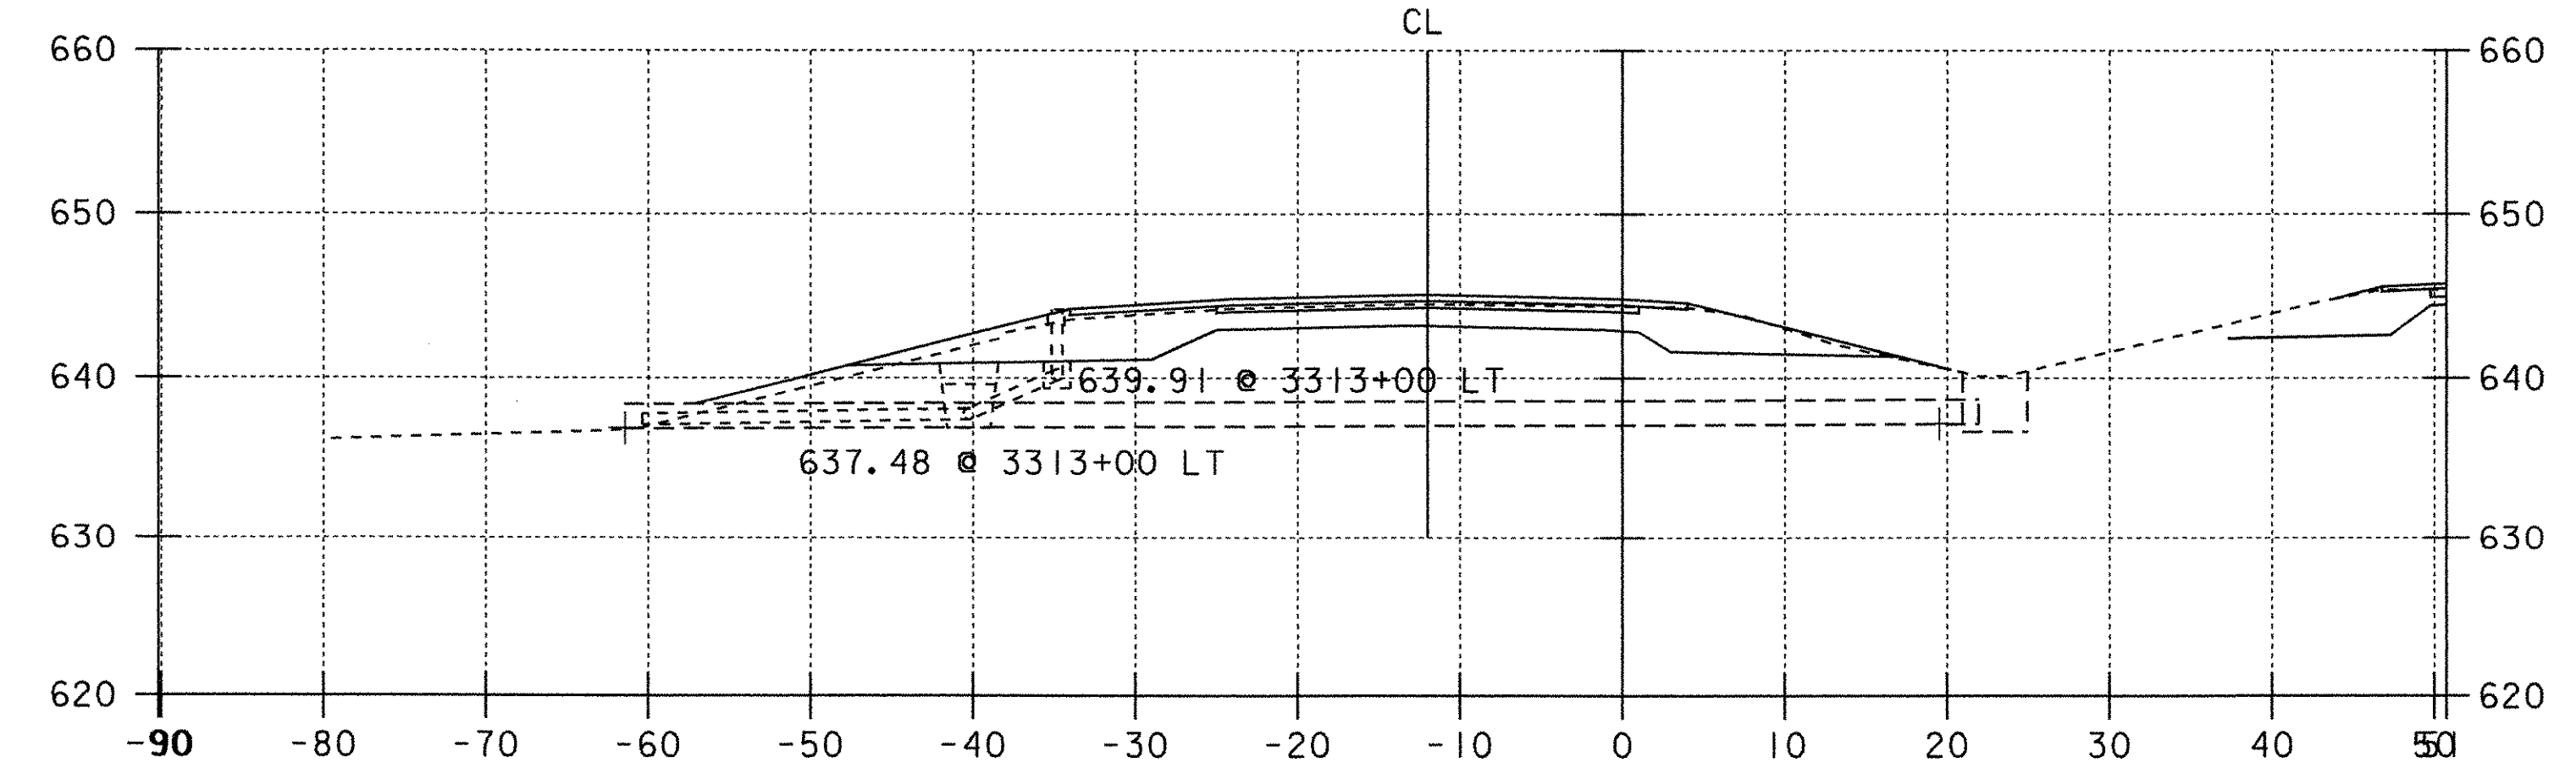

3312+99  
EXISTING 18'' ACCGMP

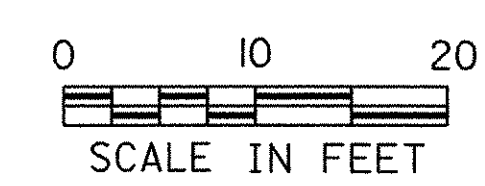

SOUTHBOUND DRAINAGE CROSS SECTIONS

PROJECT:	FAIRFAX - FAIRFIELD - ST. ALBANS	PROJECT NO.:	IM 089-3(27)
DESIGN FILE NAME:	/87A007B/DESIGN/DA007DXS.DGN	PLOT DATE:	18-AUG-2000
IPARM FILE NAME:	DA007X52	SURVEYED BY:	ORVIS
SURVEYED BY:	ORVIS	SURVEY DATE:	6/98
SQUAD LEADER:	DELLA SANTA	DRAWN BY:	SQUAD B
		SHEET:	329 OF 370