


NOTE: OFFSET DISTANCES ARE MEASURED FROM THE GRADE LINE.

# NORTHBOUND CROSS SECTIONS

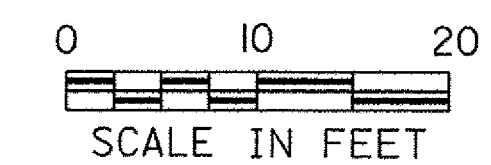

PROJECT: FAIRFAX -- FAIRFIELD -- ST. ALBANS.	PROJECT NO.: IM 089-3(27)
DESIGN FILE NAME: /87A007B/DESIGN/DA007XSLDGN	PLOT DATE: 25-JAN-2002
IPARM FILE NAME: DA007X12	SURVEY DATE: 6/98
SURVEYED BY: ORVIS	DRAWN BY: SQUAD B
SQUAD LEADER: DELLA SANTA	SHEET: 351 OF 370