


NOTE: OFFSET DISTANCES ARE MEASURED FROM THE GRADE LINE.

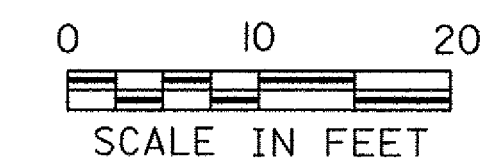

NORTHBOUND CROSS SECTIONS

PROJECT:	FAIRFAX - FAIRFIELD - ST. ALBANS	PROJECT NO.:	IM 089-3(27)
DESIGN FILE NAME:	/87A007B/DESIGN/DA007XSI.DGN	PLOT DATE:	25-JAN-2002
IPARM FILE NAME:	DA007X13	SURVEY DATE:	6/98
SURVEYED BY:	ORVIS	DRAWN BY:	SQUAD B
SQUAD LEADER:	DELLA SANTA	SHEET:	352 OF 370