



3339+01
EXISTING 30' ACCGMP

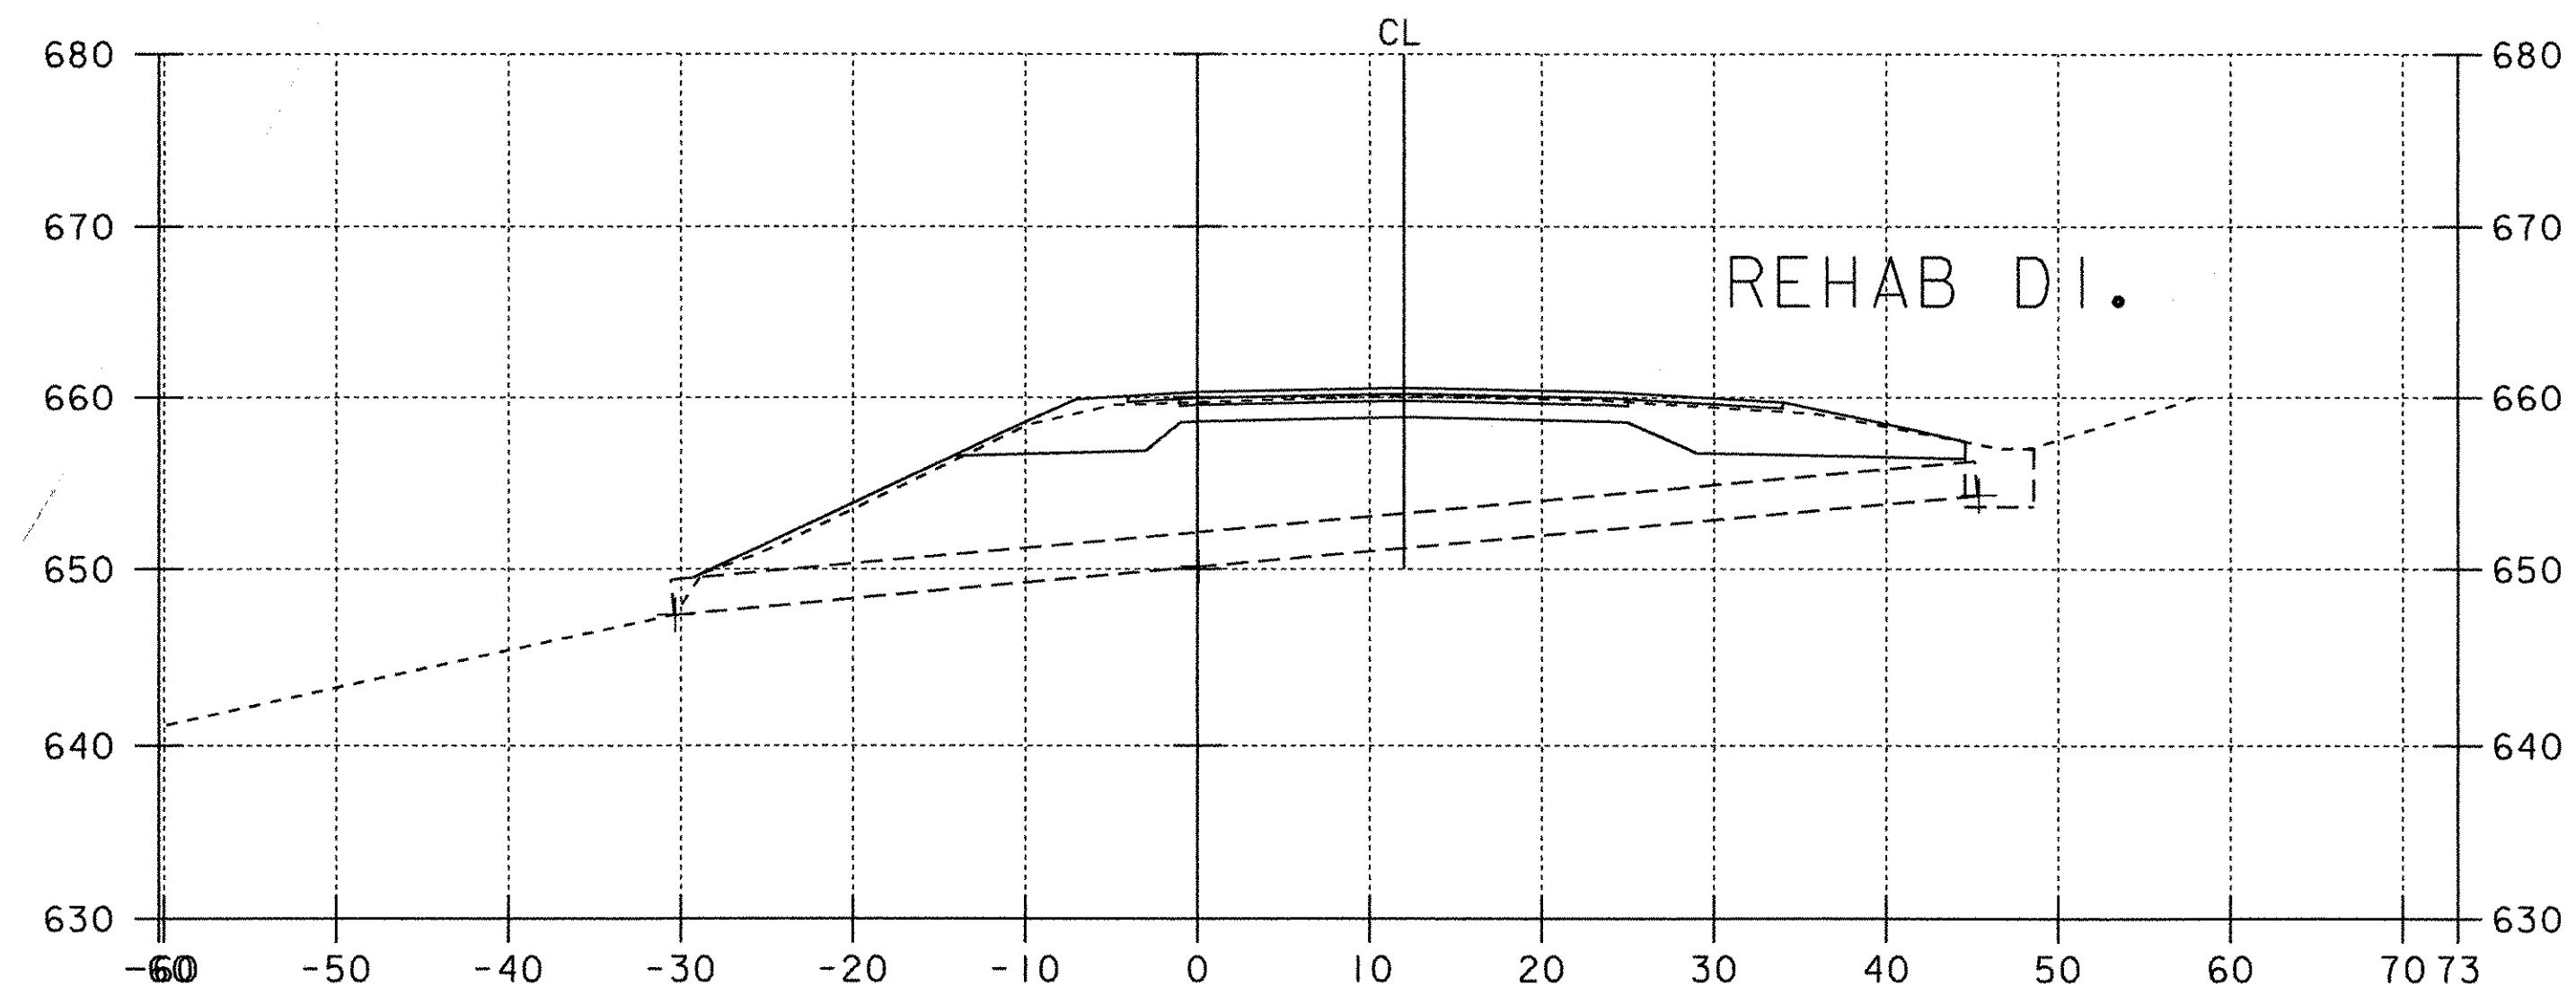


3344+01
EXISTING 24' ACCGMP

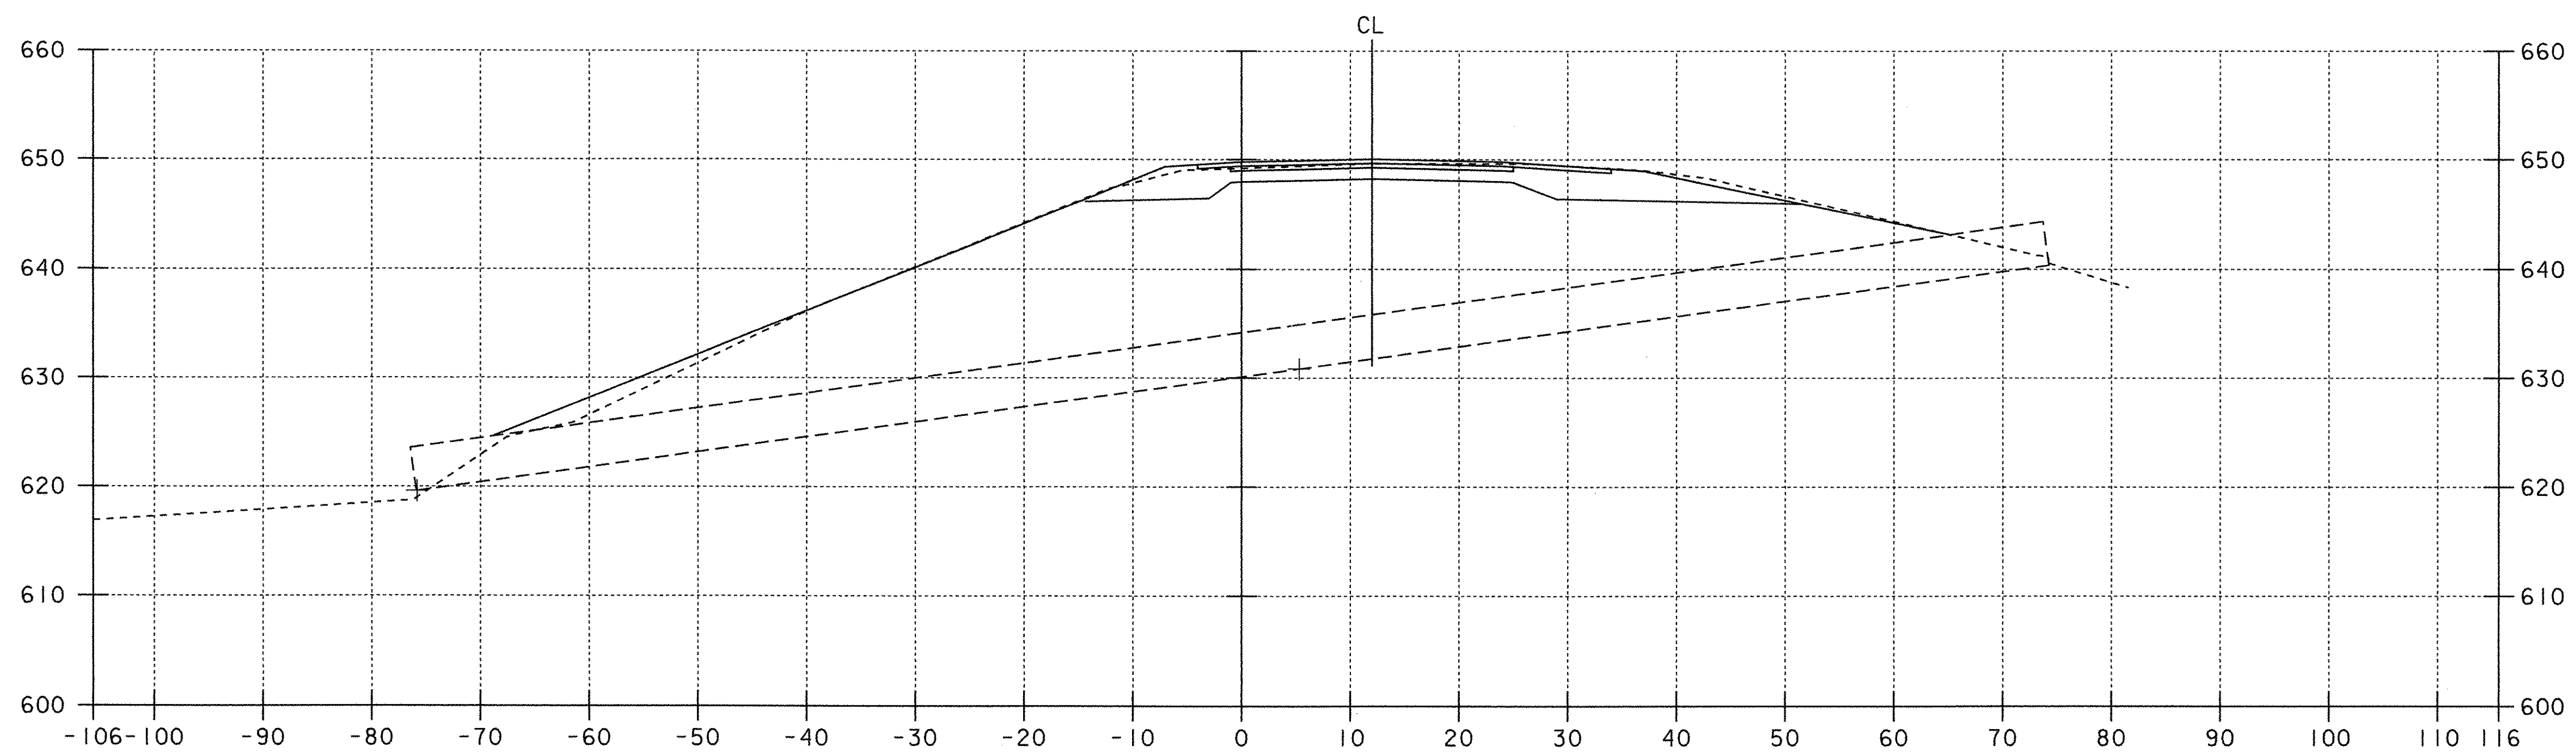

3334+92
EXISTING 48' ACCGMP

NORTHBOUND DRAINAGE CROSS SECTIONS

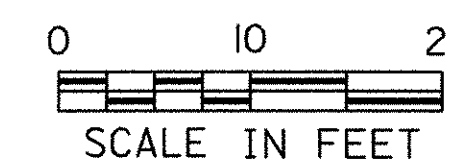

PROJECT: FAIRFAX - FAIRFIELD - ST. ALBANS	PROJECT NO. : IM 089-3(27)
DESIGN FILE NAME: /87A007B/DESIGN/DA007DXS.DGN	PLOT DATE: 17-AUG-2000
IPARM FILE NAME: DA007X65	SURVEY DATE: 6/98
SURVEYED BY: ORVIS	DRAWN BY: SQUAD B
SQUAD LEADER: DELLA SANTA	SHEET: 363 OF 370