

PROPERTY LINE FENCE W/STEEL POSTS, MOD.
Item 583 II
S.B. 3300+00 - 3316+00 Lt.
N.B. 3300+00 - 3316+00 Rt.

*THREE CABLE GUARD RAIL W/
LIGHT STEEL POSTS, ITEM 538
N.B. 3300+00 - 3307+00 Lt.
S.B. 3300+00 - 3311+00 Lt.

*JUTE MATTING - ITEM 623
N.B. 3300+00 - 3313+00 Lt.

INDIVIDUAL WATER SOURCES
DUG WELL S.B.L. 3303± - 1200'± Lt.
DUG SPRING S.B.L. 3303± - 1300'± Lt.

NOTE: * DENOTES ITEMS TO BE
INCLUDED IN STAGE II CONSTRUCTION.

*Bridge Railing for Bridge Approaches
Item 572
SB 3300+00 - 3300+60 Rt.
SB 3300+00 - 3300+70 Lt.

CONTROL OF ACCESS IS COMPLETE ON THIS SHEET.


APPROX. AERIAL UTILITIES RELOC.
ROUTE BY C.K.P.S. CORP. (TRANSMISSION)

APPROX. AERIAL UTILITIES RELOC.
ROUTE BY NET & T CO.

BM #156
ASMD ELEV.
614.843

BM #157
ASMD ELEV.
634.874±

VT. GRID

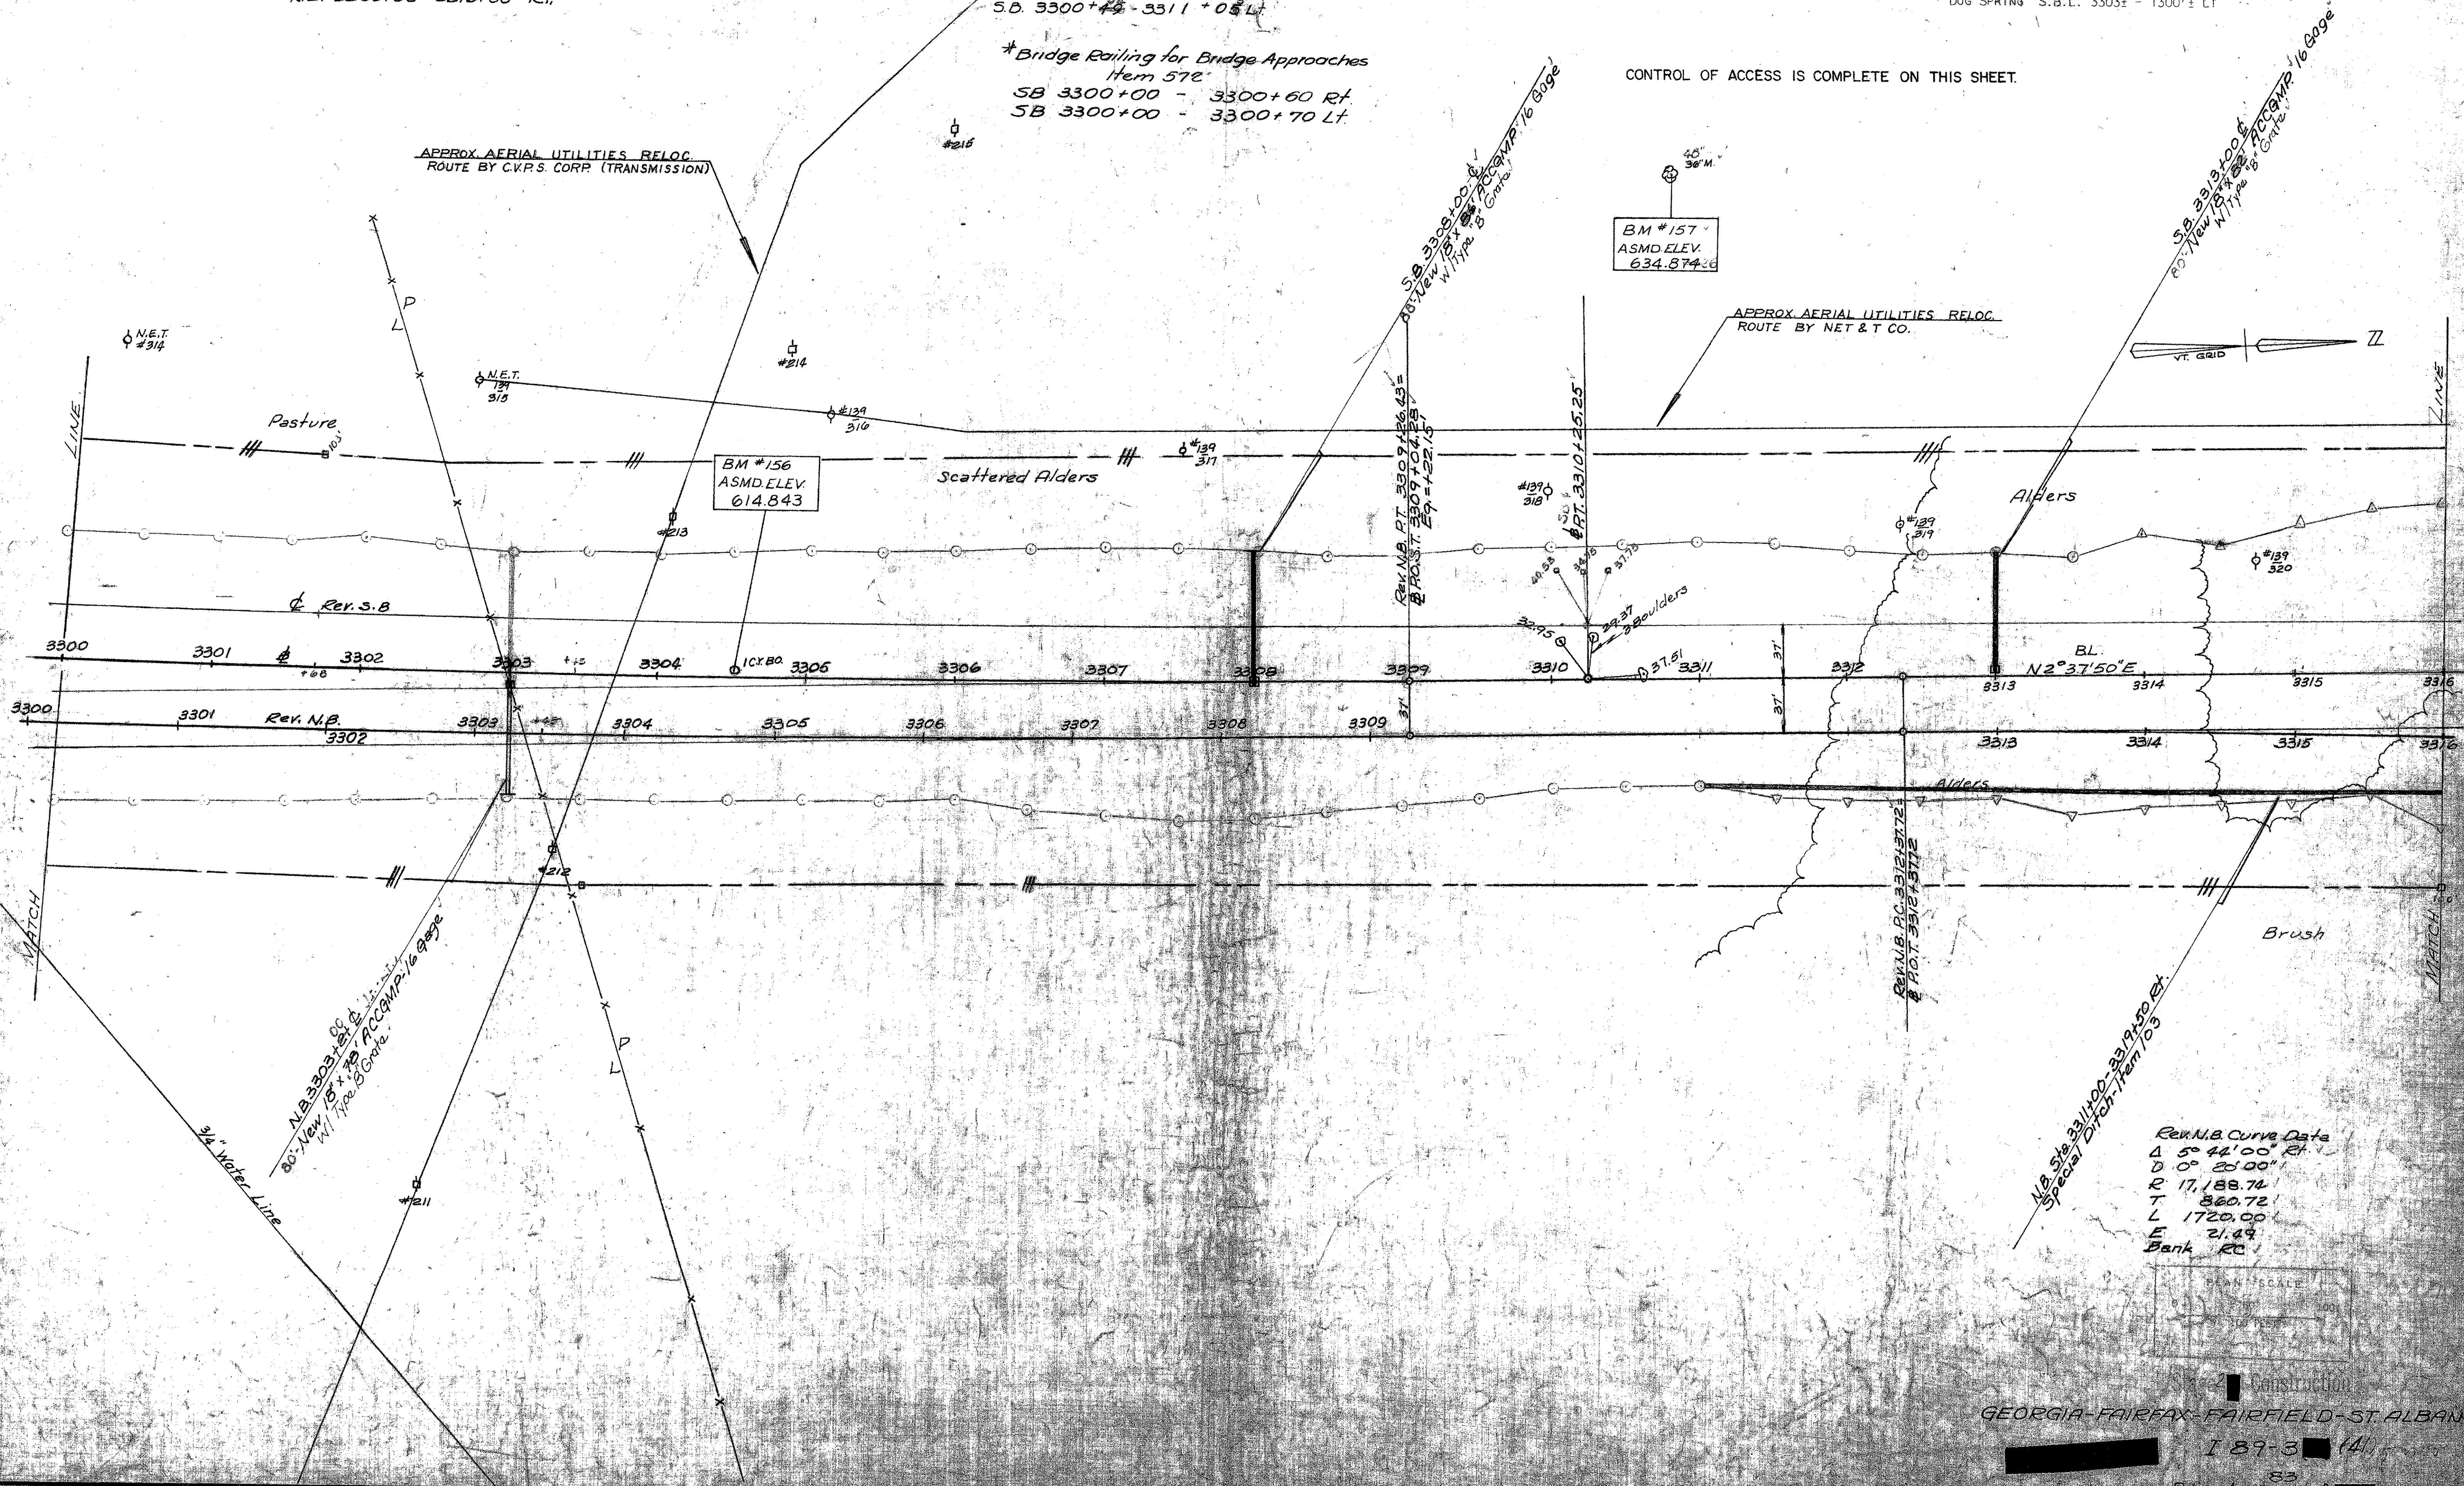

Rev. N.B. Curve Data
Δ 5° 44' 00" Rt.
D 0° 20' 00" Lt.
R 17,188.74
T 860.72
L 1720.00
E 21.49
Bank RC

GEORGIA-FAIRFAX-FAIRFIELD-ST ALBANS

189-3 (4)

Sheet 83 of 113

STA. 3300=MM 11.38