
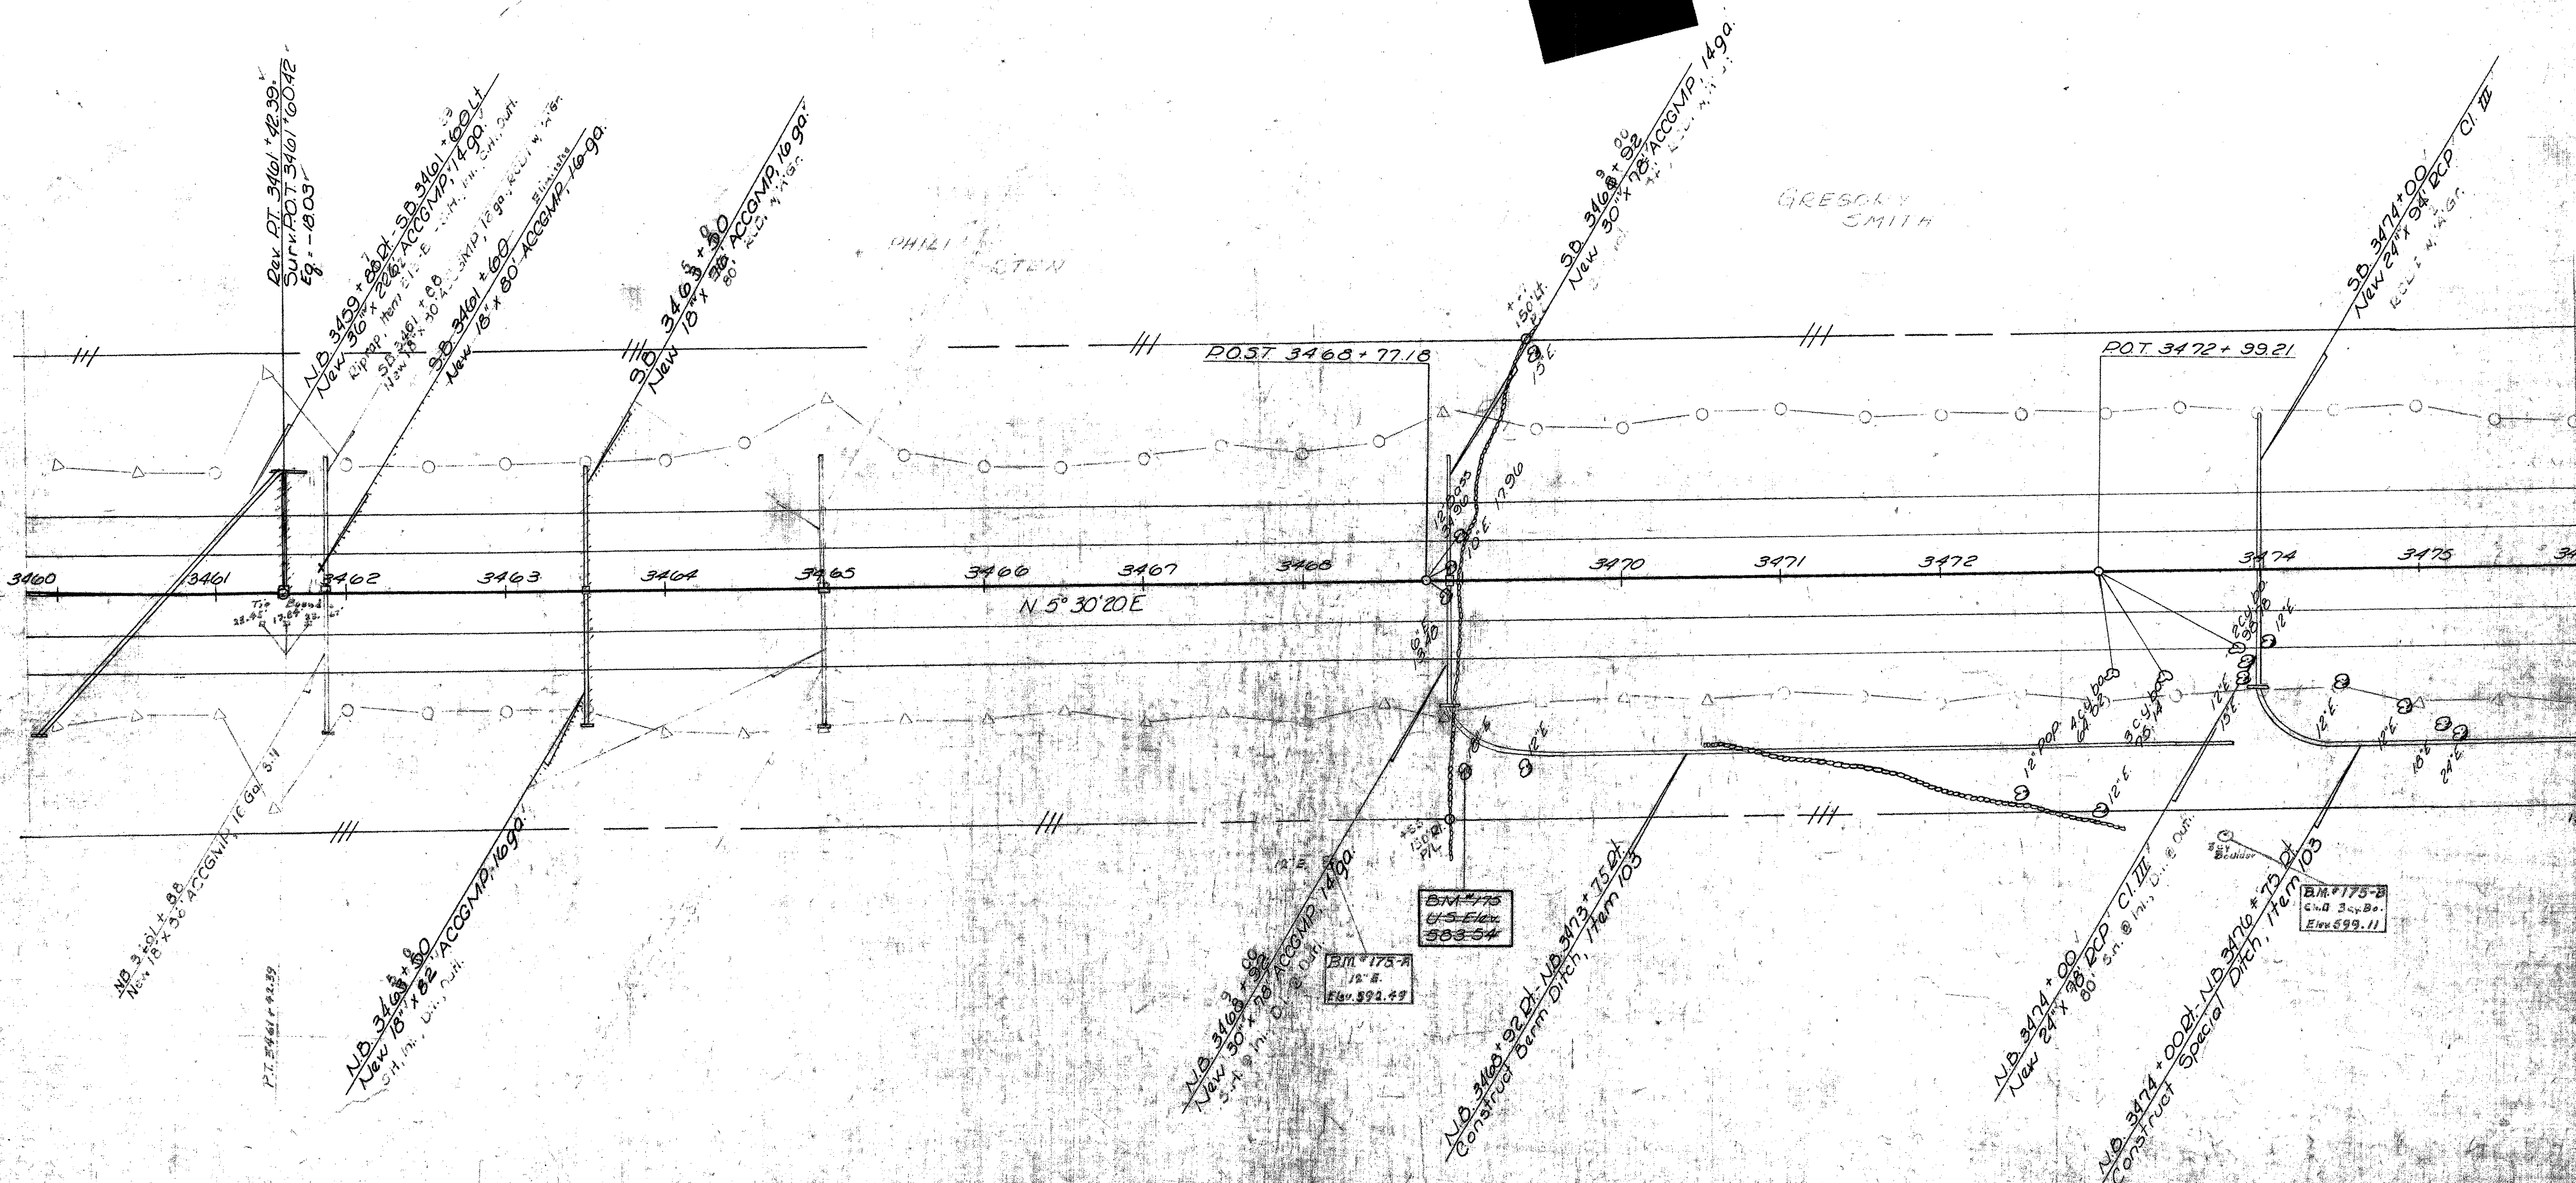


* BITUM CONC SURFACE FOR
GUTTERS & TRAFFIC ISLANDS
ITEM 554
3461+35 - 3461+60 Med
3463+25 - 3463+75 Med
3468+92 - 3469+17 Med
3474+00 - 3474+25 Med

PROPERTY LINE FENCE, ITEM 583-II, MOD.
3460+00 - 3476+00 Lt & Rt

BL	STA	LOC	OFFSET	DESCRIPT
BL	3460+00	LT	900'	DRILLED WELL
BL	3463+00	LT	800'	DRILLED WELL

PLAN
SUPERVISOR
PLANNING
NO. 5000
DATE
NO. 5000
DATE

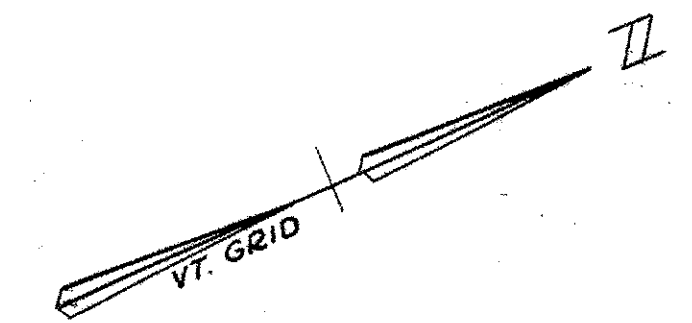

"CONTROL OF ACCESS COMPLETE ON THIS SHEET"

* STAGE II CONSTRUCTION ITEM

STALDANS - SWANTON
I 89 - 30 42