


$\frac{576.31}{10.44} = 55.20$   
 $\frac{576.31}{10.44} = 55.20$   
 05-11-09  
 11:49:38 AM  
 05-11-09  
 12:26:09 PM

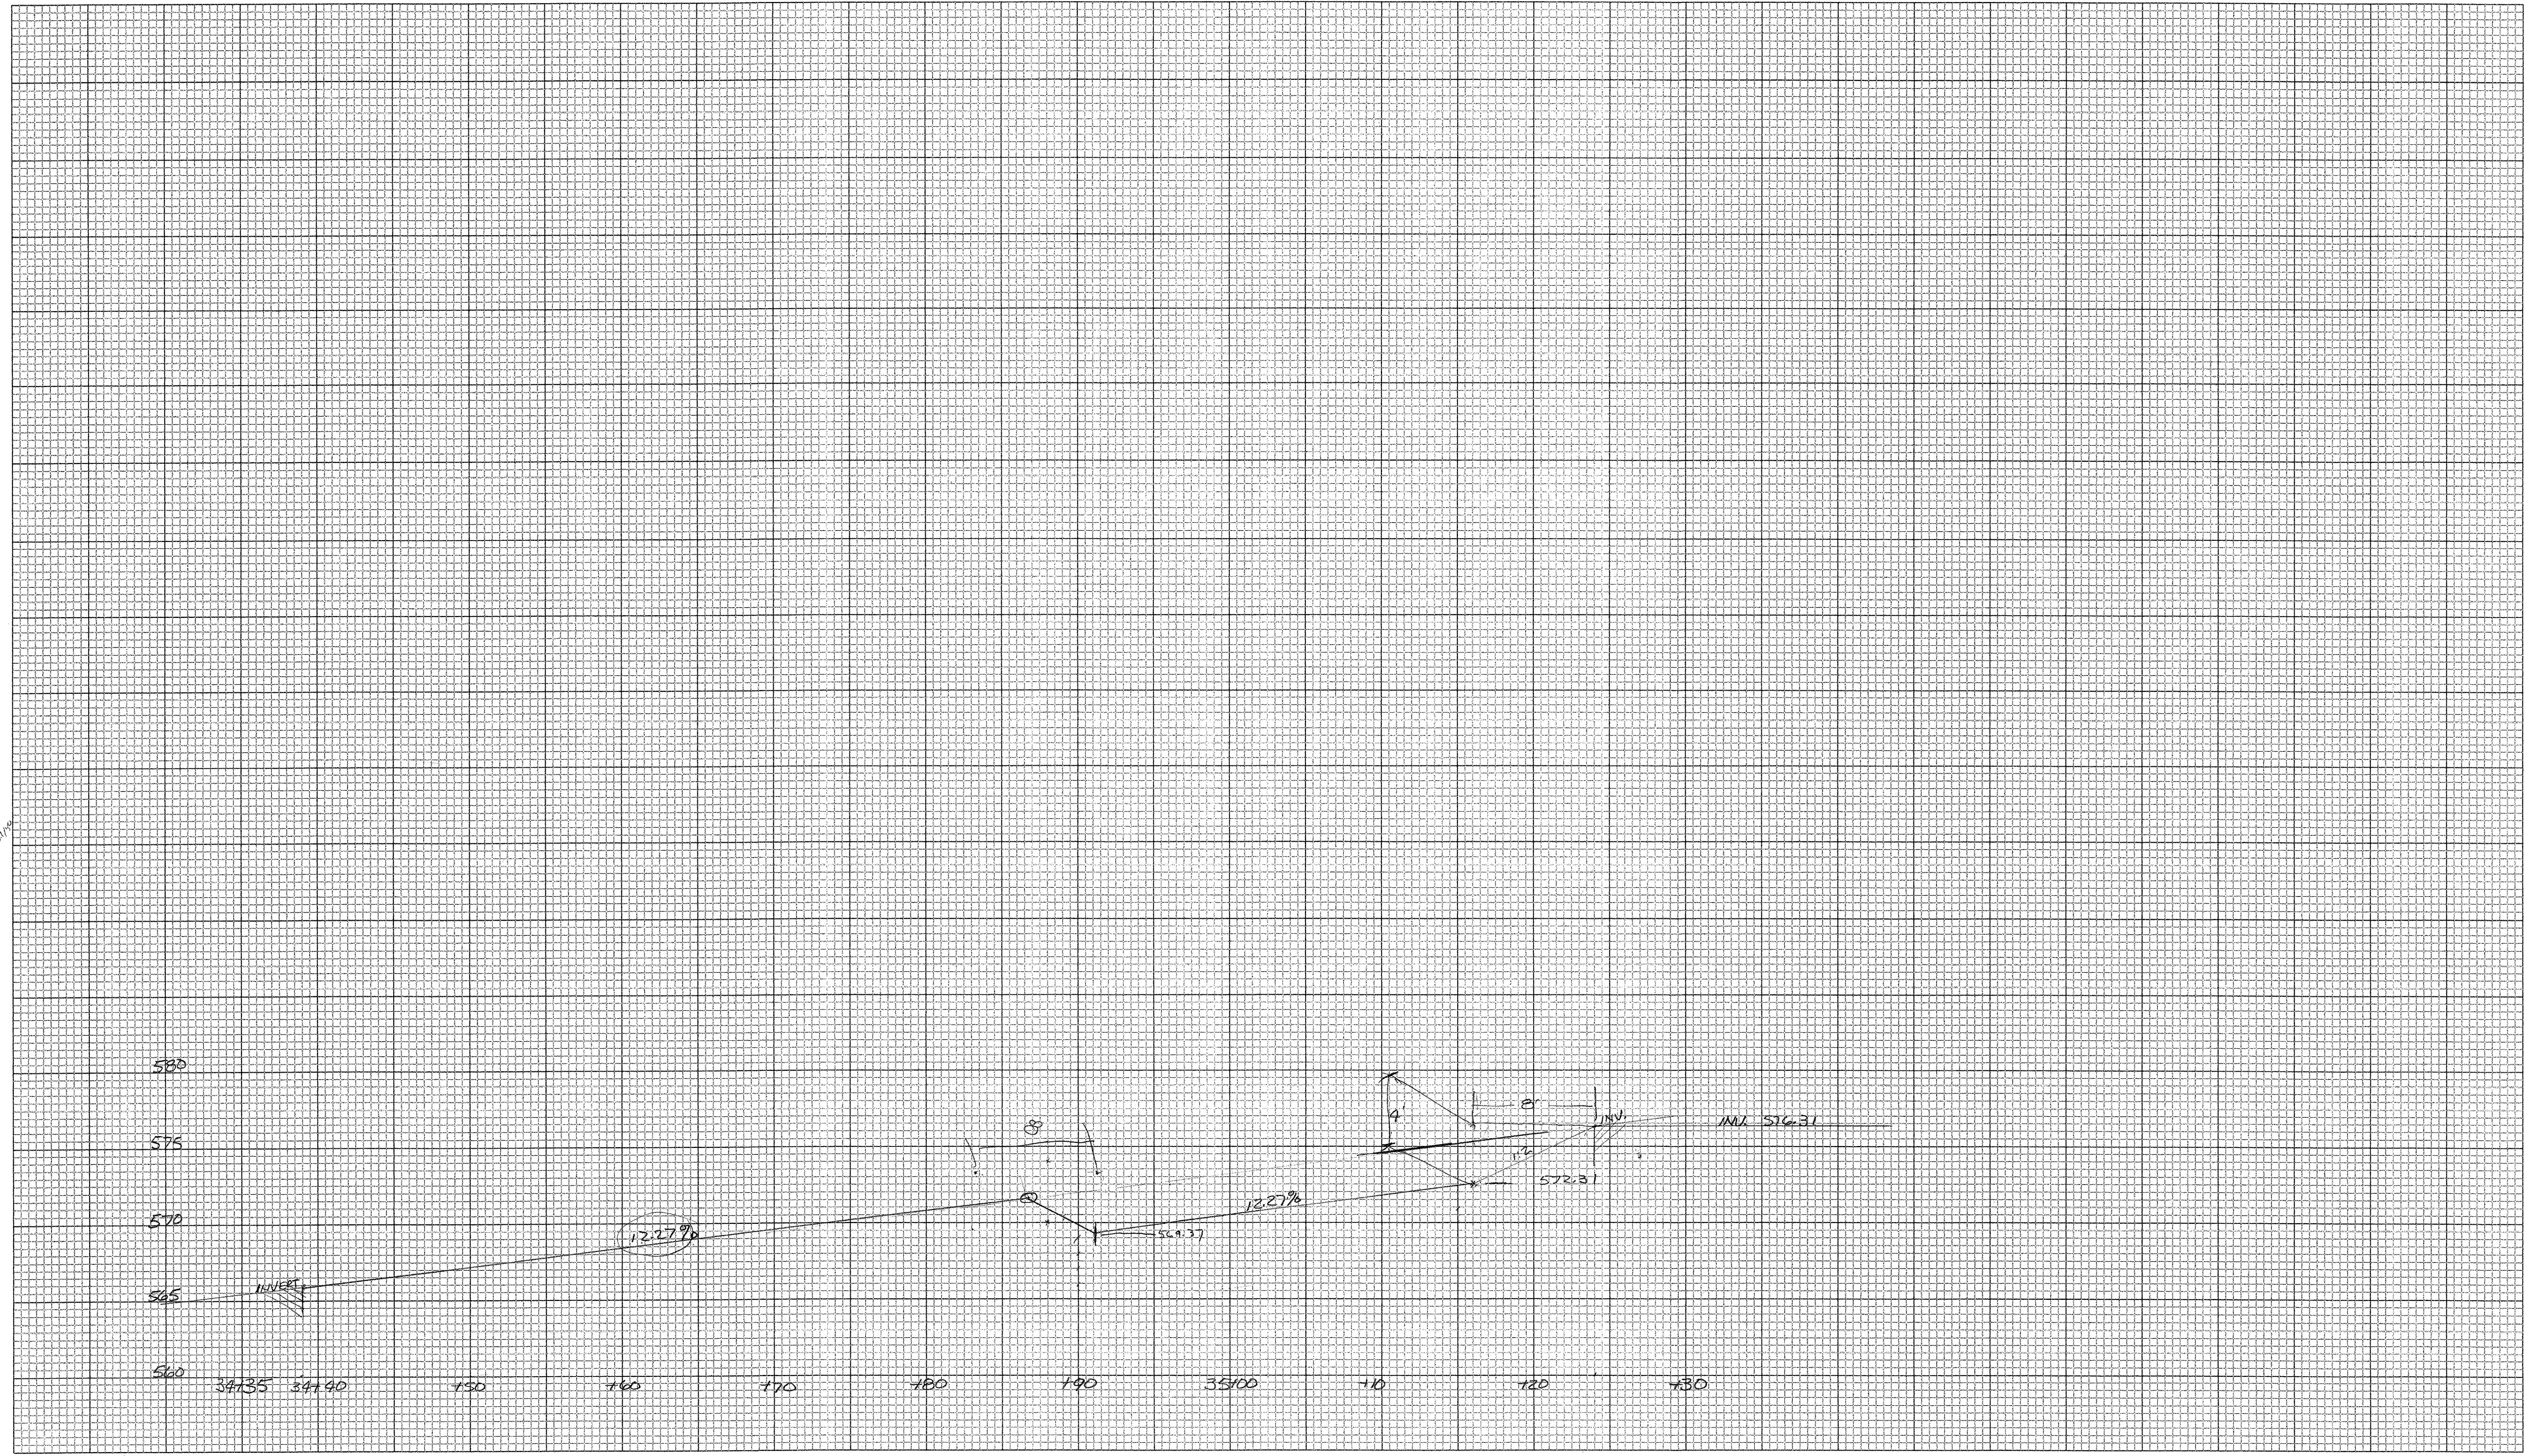

11.5H

# CROSS SECTION SHEET

PROJECT NAME: \_\_\_\_\_  
 PROJECT NUMBER: \_\_\_\_\_  
 FILE NAME: \_\_\_\_\_ PLOT DATE: 05-JUN-2000 09  
 PROJECT LEADER: \_\_\_\_\_ DRAWN BY: \_\_\_\_\_  
 DESIGNED BY: \_\_\_\_\_ CHECKED BY: \_\_\_\_\_  
 const: g:/common/cadd/e-xsection.dgn SHEET 386 OF \_\_\_\_\_