


6+83
But X

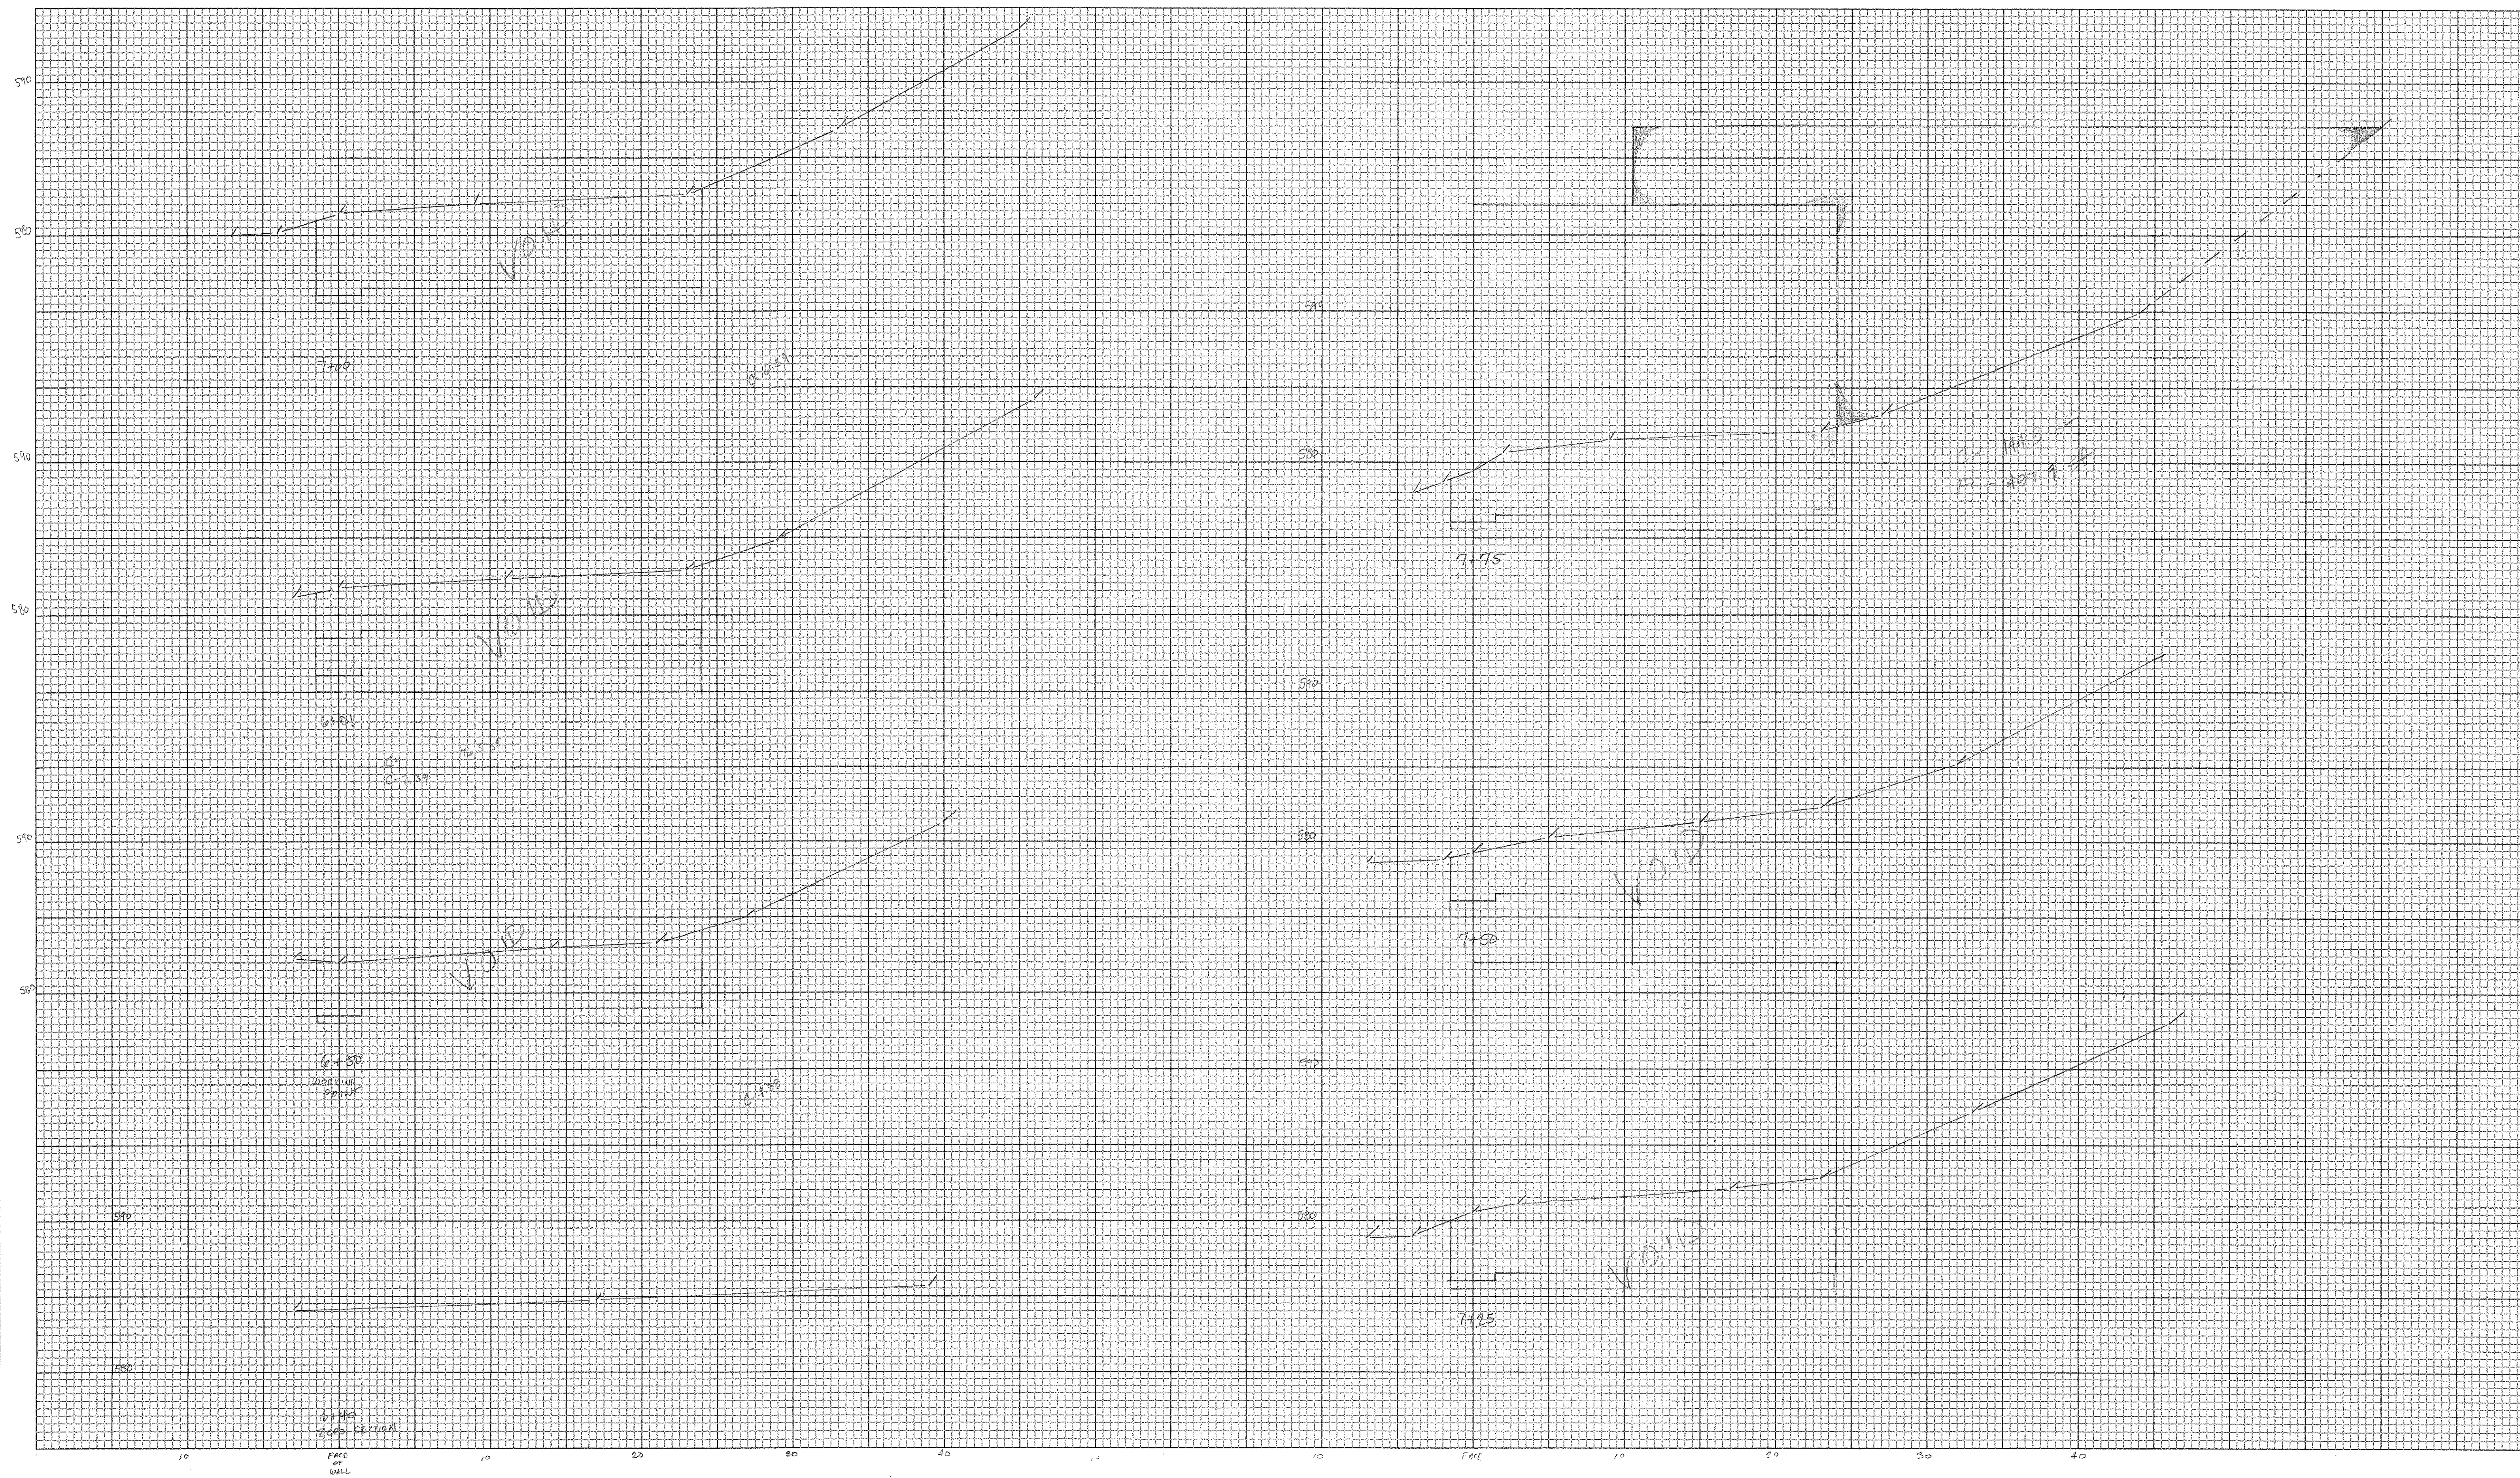

Blue - Greenish Yellow

GREEN - GRASSHOPPER BROWN

CROSS SECTION SHEET

PROJECT NAME: FAIRFAX - ST. ALBANS 2M 009-3 (2)

PROJECT NUMBER: _____

FILE NAME: STRUCTURE EXAMINATION @ MSE WALL #2 PLOT DATE: 05-JUN-2000 09

PROJECT LEADER: _____ DRAWN BY: KNIPAS
DESIGNED BY: _____ CHECKED BY: 391

DESIGNED BY: _____ CHECKED BY: 377
const: g:/common/cadd/e-xsection.dgn SHEET 2 OF 3

$$1'' = 534$$