



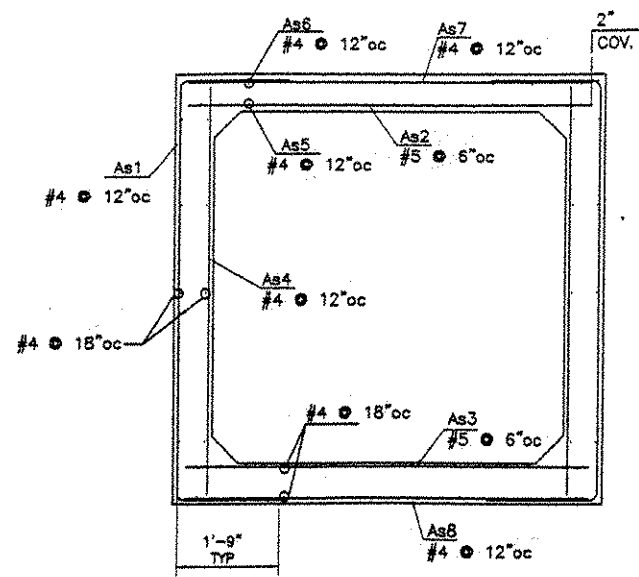


MK	Size	Spced	Len	Type	A	B	C
As1	4	12"	127"	U"	1'-9"	7'-1"	1'-9"
As2	5	6"	86"	Str.	---	7'-2"	---
As3	5	6"	86"	Str.	---	7'-2"	---
As4	4	12"	84"	Str.	---	7'-0"	---
As5	4	12"	85"	Str.	---	7'-1"	---
As6	4	12"	85"	Str.	---	7'-1"	---
As7	4	12"	86"	Str.	---	7'-2"	---
As8	4	12"	86"	Str.	---	7'-2"	---

REBAR REINFORCEMENT TABLE

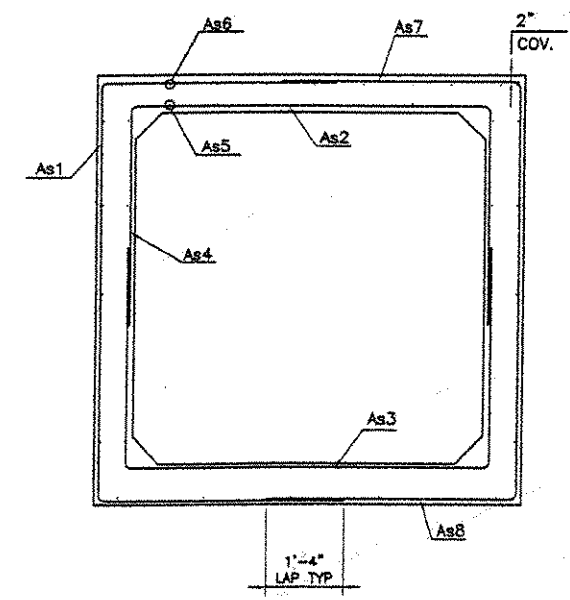


MK	As REQ. in'
As1	0.192
As2	0.432
As3	0.454
As4	0.192
As5	0.192
As6	0.192
As7	0.192
As8	0.192


MESH REINFORCEMENT TABLE

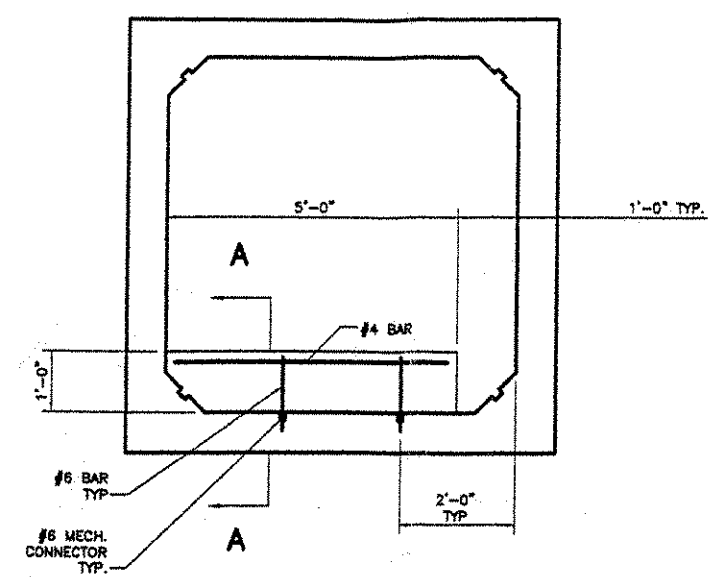


BAFFLE DETAIL

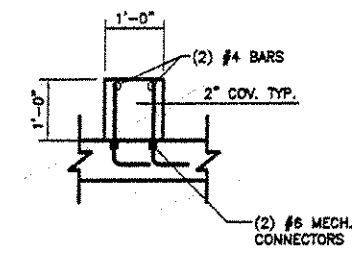


SECTION A-A

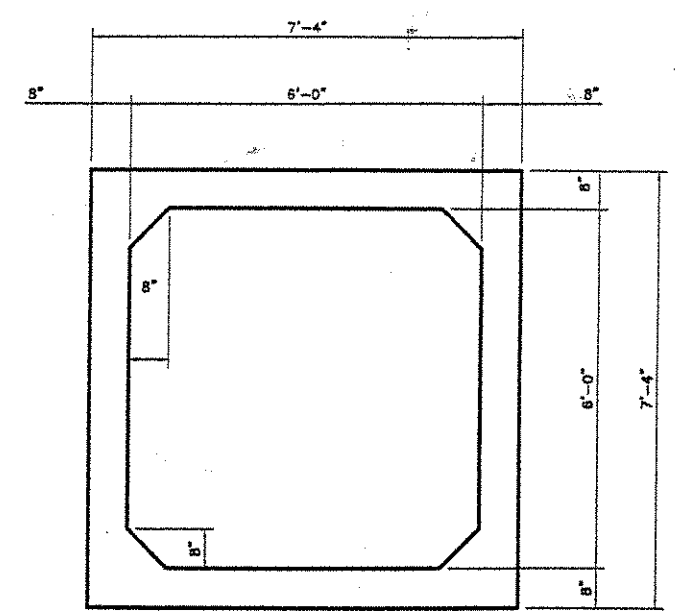


SECTION A-2

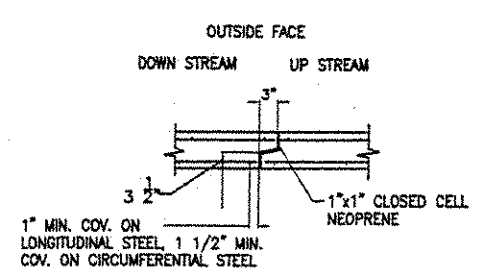


JOINT DETAIL

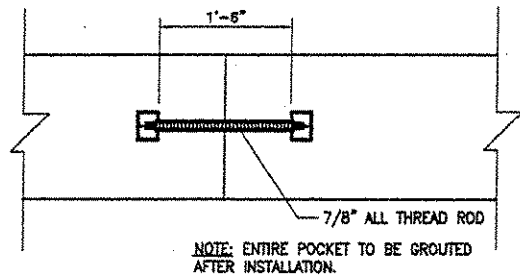

RECESSED DRAW CONNECTOR (4 PER SECTION)

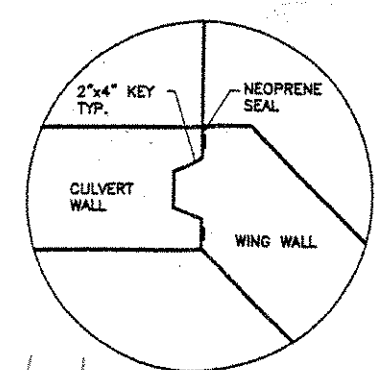

DETAIL B-2

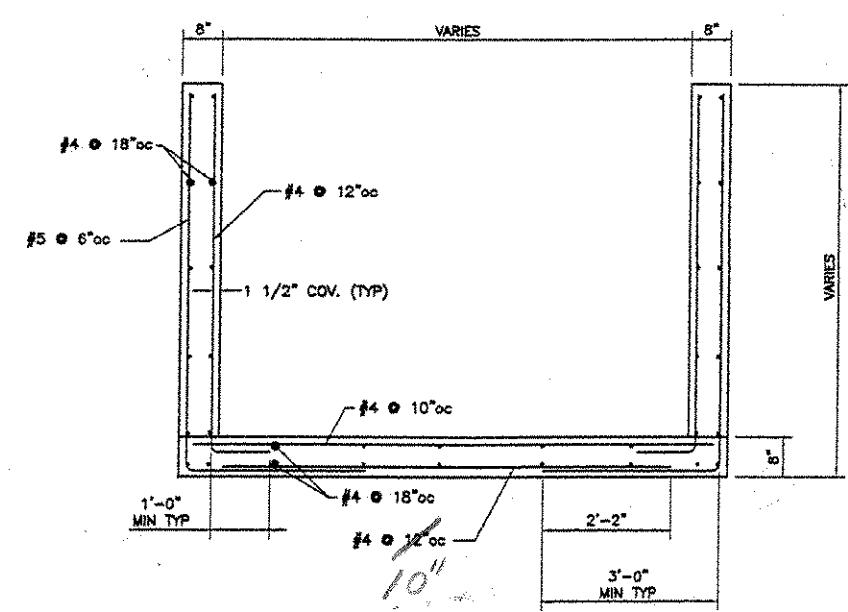

TYPICAL END SECTION

NOT RECEIVED
CK'D BY _____ OK'D BY _____

MAR 01 2002
RESUBMIT _____ APPROVED *As Noted*
BY *RRW* DATE *4-9-02*

STATE OF VERMONT
RALPH VERRASTRO
#18-0006974
REGISTERED PROFESSIONAL ENGINEER
Ralph Verrastro
6-29-01

DELTA ENGINEERS, P.C.
ENGINEERS • ARCHITECTS
84 COURT STREET, BANGOR, ME 05601-3504
TEL: (207) 231-6200 FAX: (207) 231-6200

TOWN OF ST. ALBANS, VT.
6'-0" x 6'-0" x 78'-0"
BR 87-3 NORTHBOUND
CONTRACTOR: *430*
ENGINEER: *430*
DWN BY: GAS CKD BY: RET
SHEET 2 OF 3
CAMP PRECAST CONCRETE PRODUCTS