



VLOT
 RECEIVED
 CK'D BY mjl OK'D BY G. Ray
4.18.01 4.18.01
 MAR 29 2001
 RESUBMIT _____ APPROVED ✓ AS NOTED
 BY mjl DATE 4.18.01

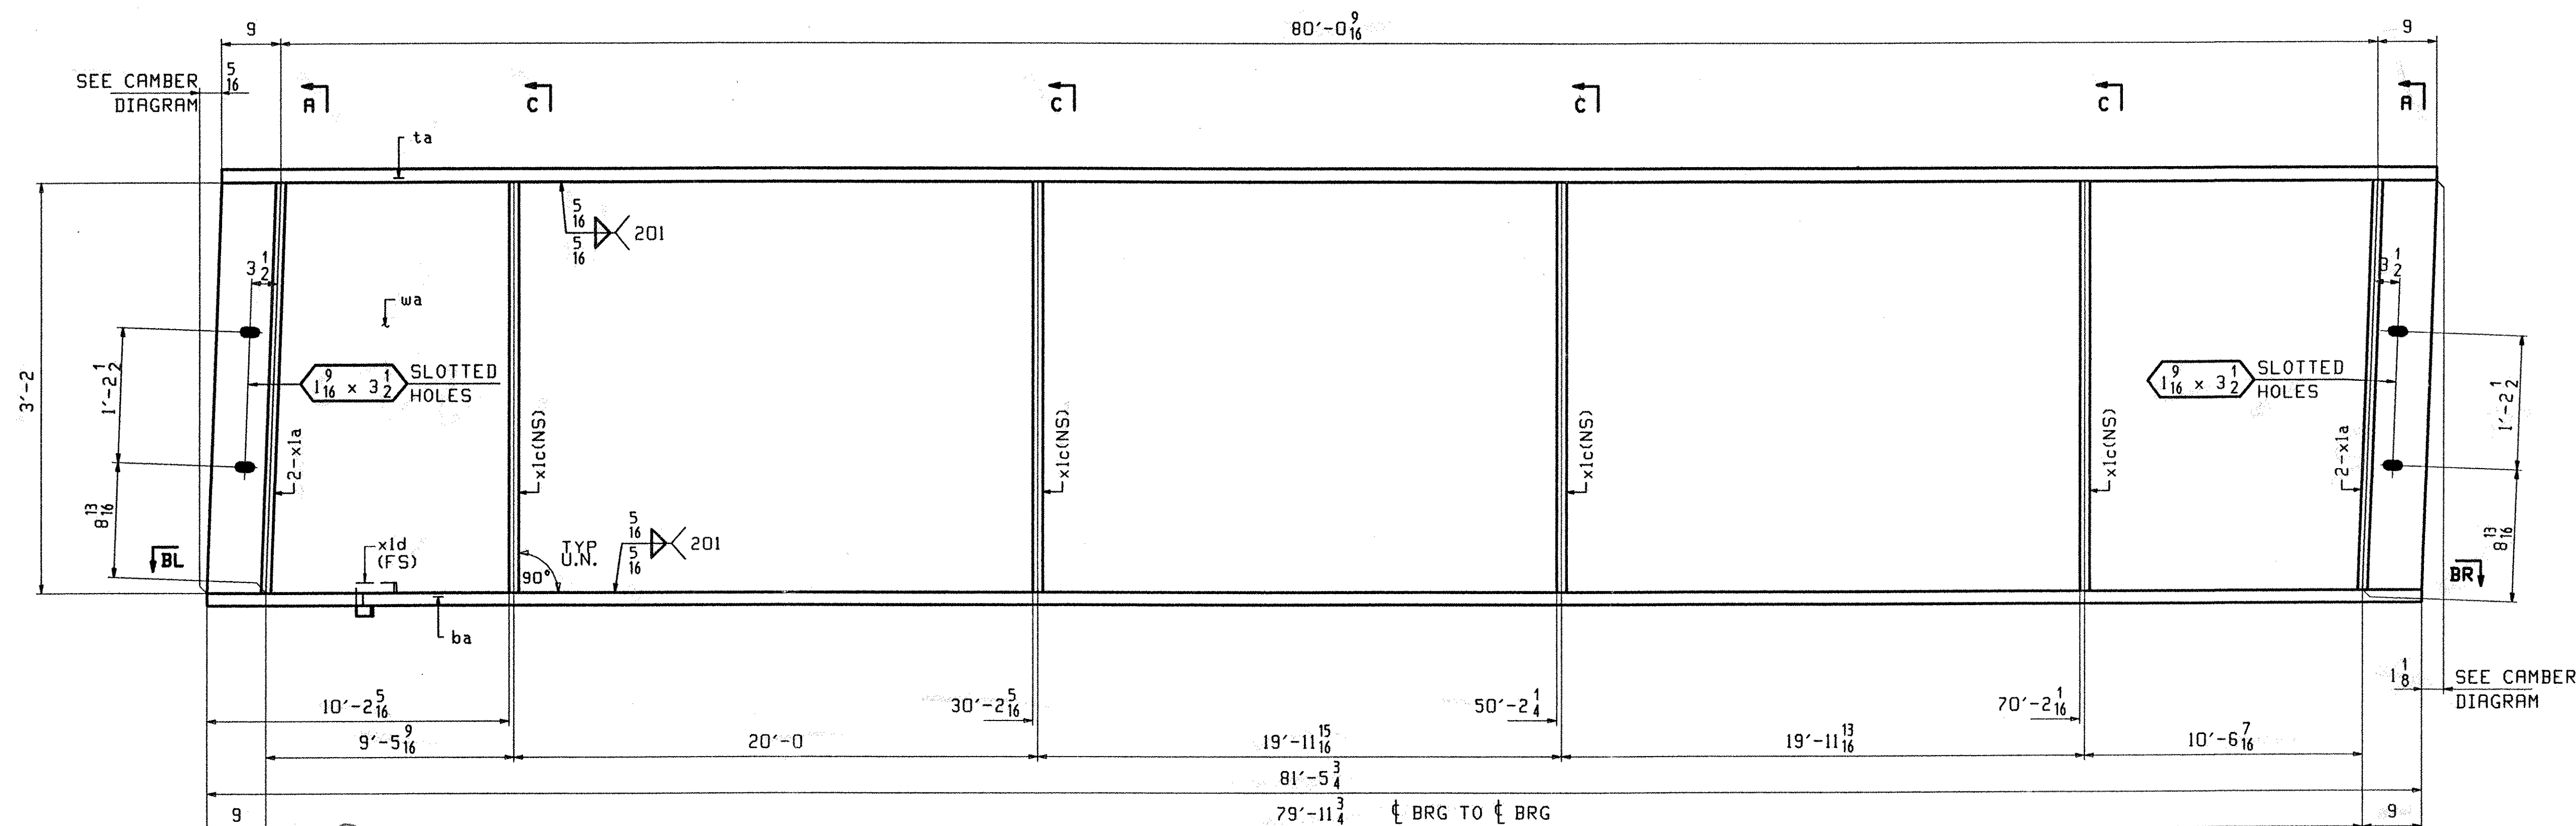


ONE - GIRDER - 4G6


1. FOR GIRDER STANDARD DETAILS SEE DRAWING XI.
2. FOR CAMBER AND FLANGE DIAGRAM SEE DRAWING CI.
3. FOR GENERAL NOTES SEE DRAWING GNI.

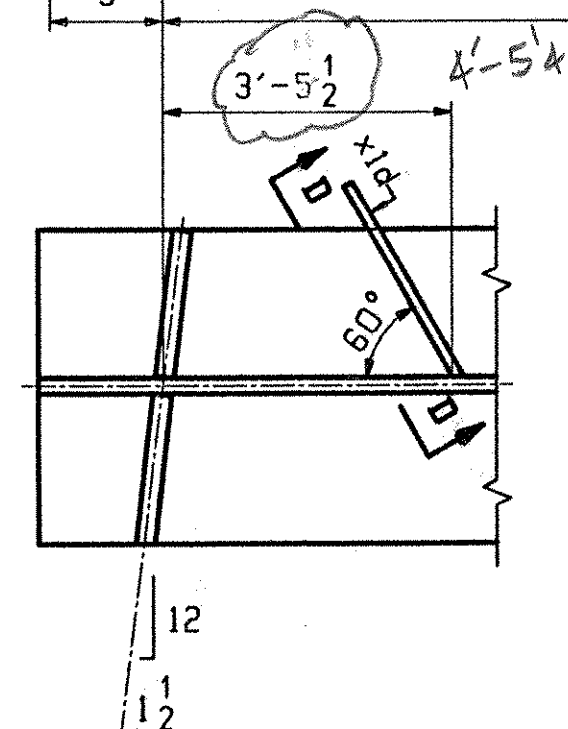


SECTION-BL

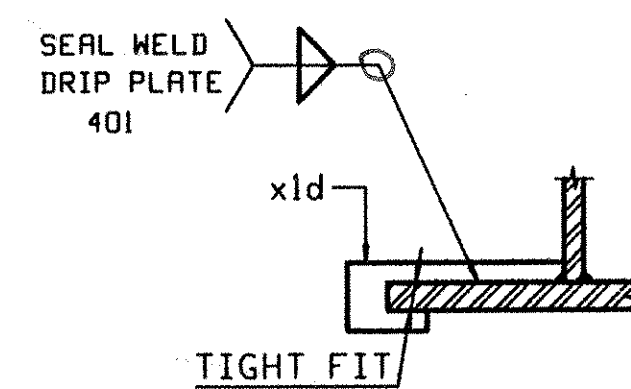


SECTION-D

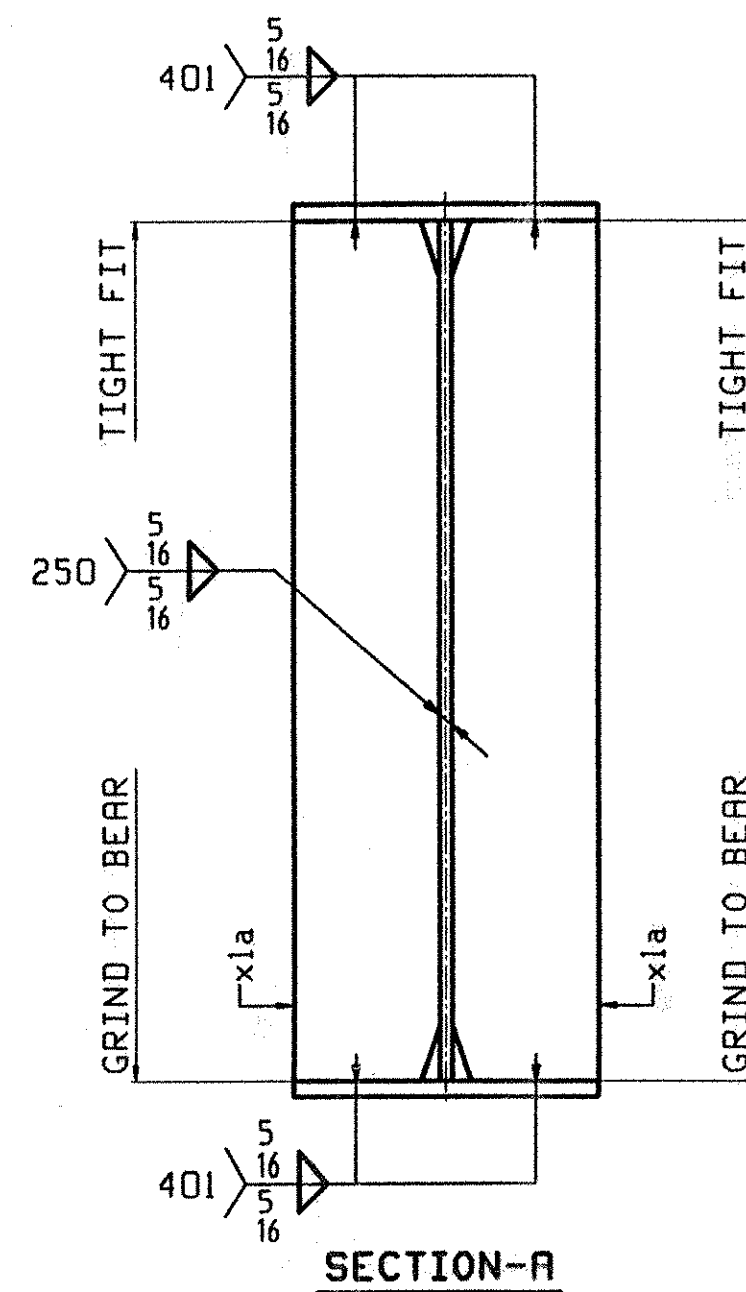


SECTION-A

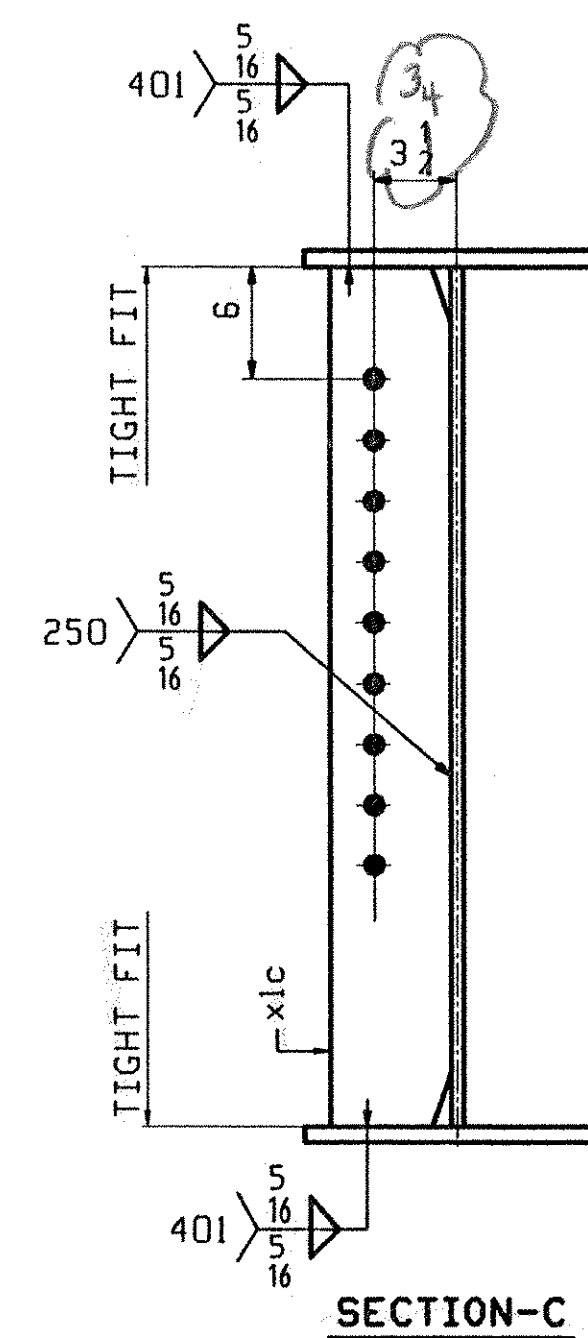

SECTION-C

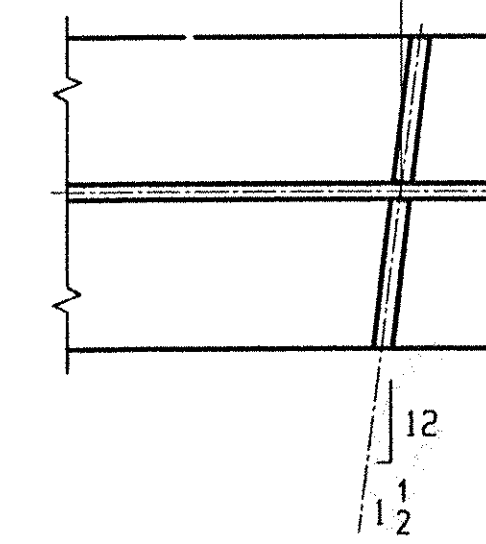

SECTION-BR

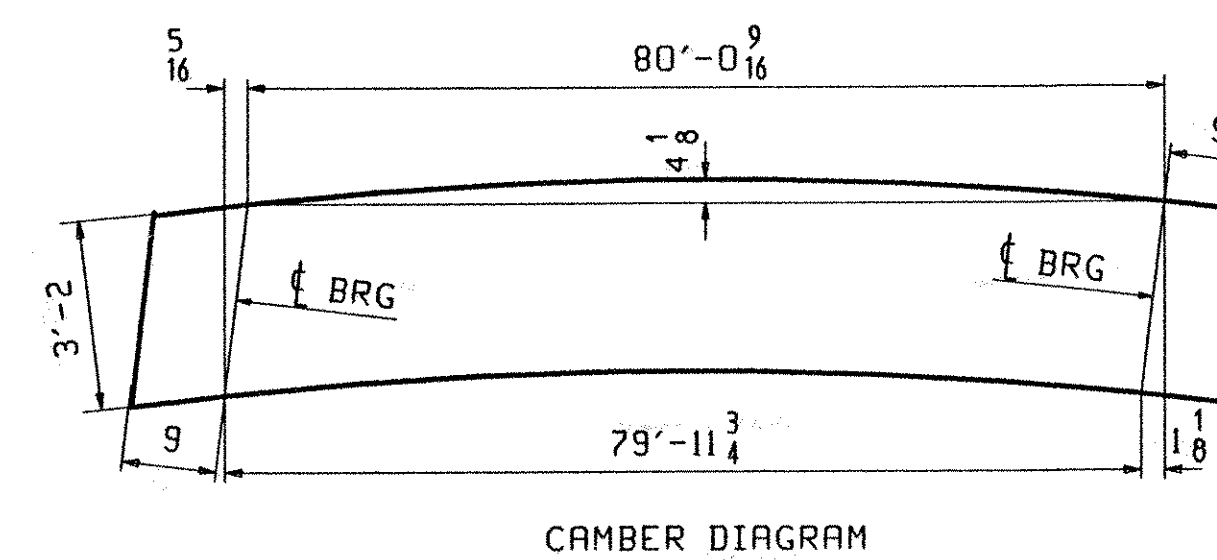

CAMBER DIAGRAM

[illegible]