



1AOT  
RECEIVED  
CK'D BY mgf OK'D BY C. Roy  
4-18-01 4-18-01  
MAR 29 2001  
RESUBMIT \_\_\_\_\_ APPROVED ✓ AS NOTED  
BY mgf DATE 4-18-01

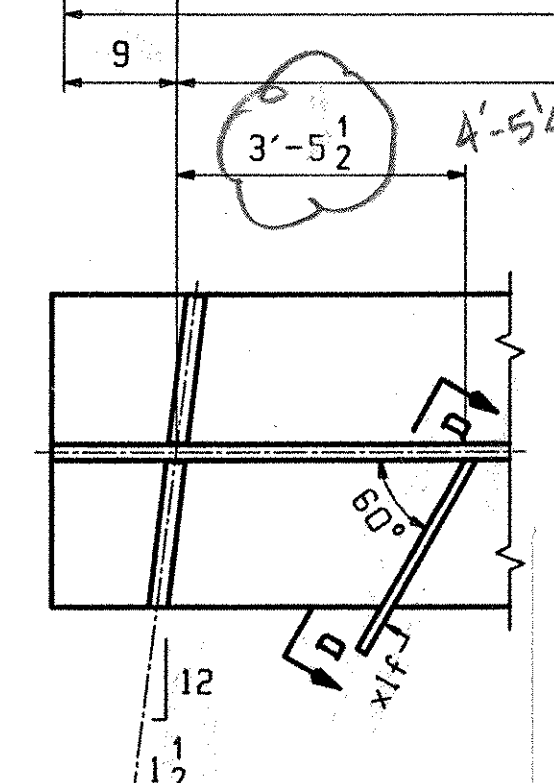

1. FOR GIRDER STANDARD DETAILS SEE DRAWING XI.
2. FOR CAMBER AND FLANGE DIAGRAMS SEE DRAWING CI.
3. FOR GENERAL NOTES SEE DRAWING GNI.

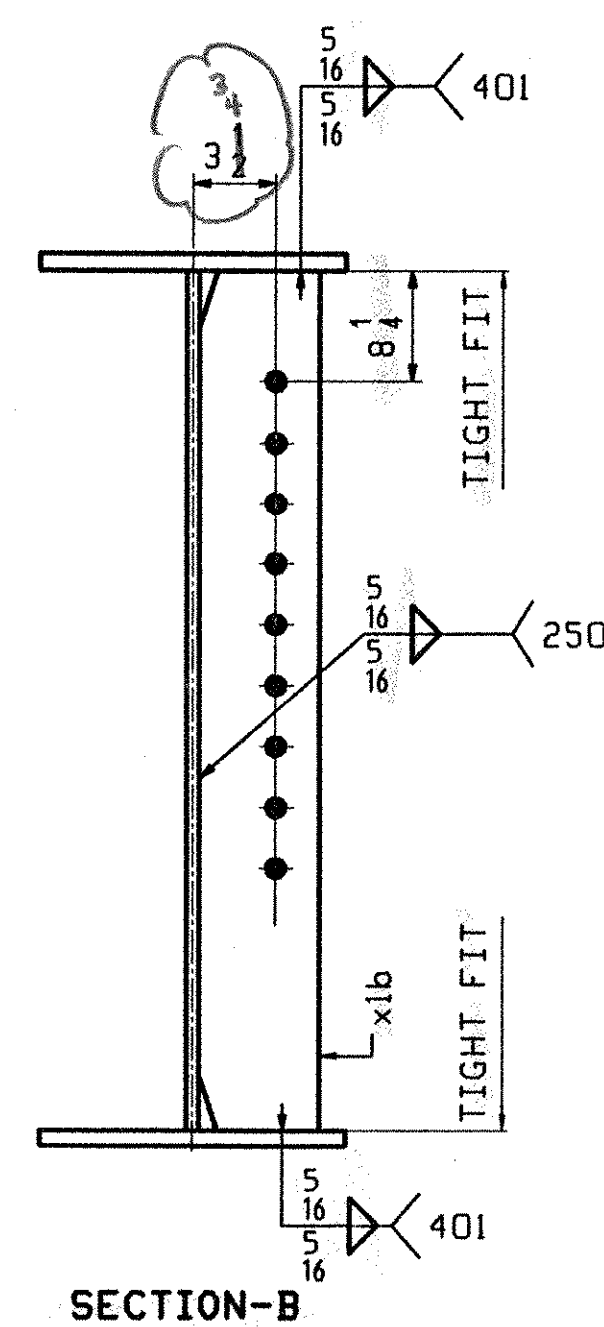

Thu Mar 22 09:20:59 EST 2001 /users/jobs/2126/6 : Rev0