




HEADWALL H1 PLAN VIEW

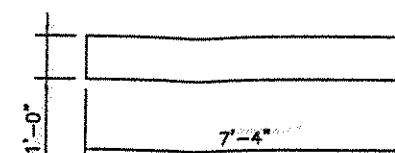


HEADWALL H2 PLAN VIEW

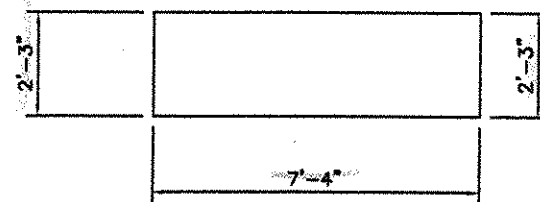


HEADWALL H1 ELEVATION VIEW

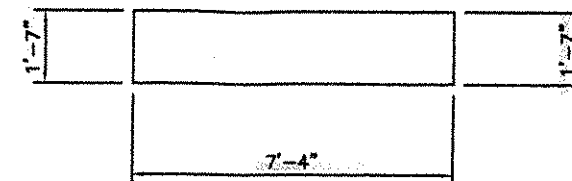


HEADWALL H2 ELEVATION VIEW

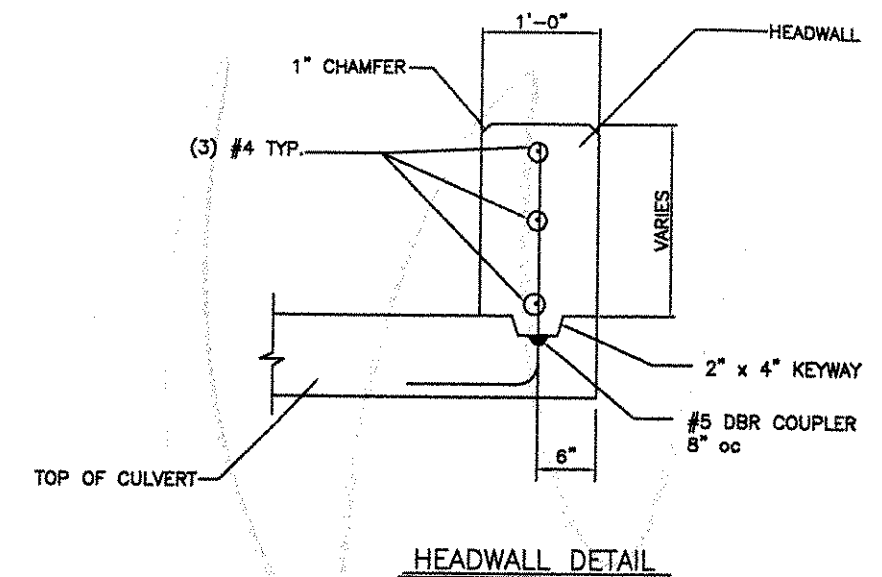


HEADWALL DETAIL

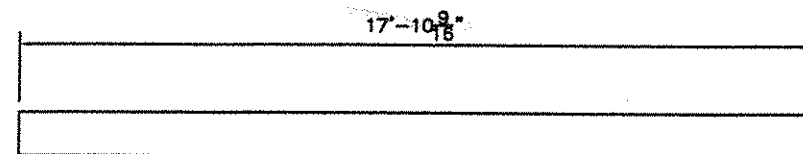


CUTOFF WALL C1 PLAN VIEW

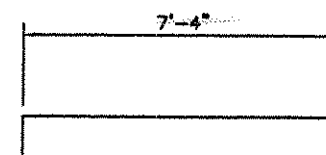

CUTOFF WALL C2 PLAN VIEW

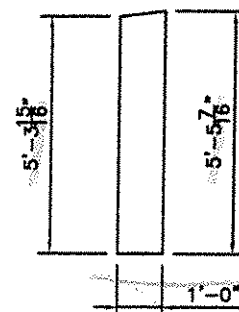


CUTOFF WALL C1 END VIEW

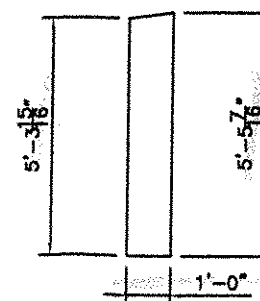

CUTOFF WALL C2 END VIEW

V.A.O.T.
RECEIVED
CKD BY C. Poy CKD BY mgl
3-21-01 3-29-01
MAR 21 2001
RESUBMIT APPROVED ✓
BY mgl DATE 3-29-01

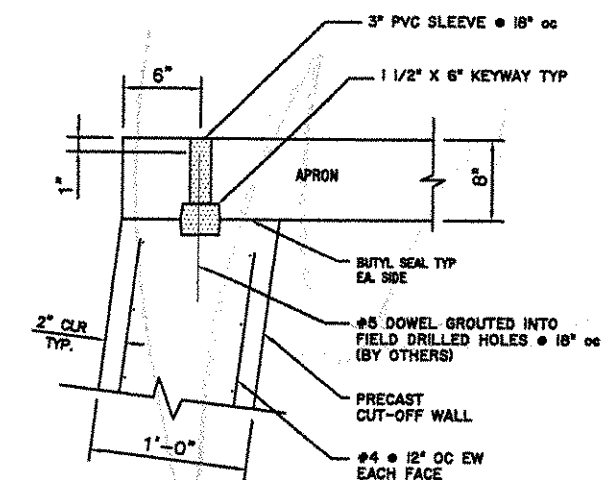

CUTOFF WALL DETAIL



Ralph Verrastro
2/21/01

 DELTA ENGINEERS, P.C. ENGINEERS • ARCHITECTS 184 COURT STREET, BIRMINGHAM, NY 13603-3344 TEL: 518/733-6900 FAX: 518/733-6900 E-MAIL: delta@delta-engineers.com	TOWN OF ST. ALBANS, VT. 6'-0" x 6'-0" x 104'-0" BR 87-3 SOUTHBOUND CONTRACTOR: ENGINEER: DWN BY: GAS CKD BY: RET DWG ID: 1004-01 SCALE: NONE REV: 0 DATE: 2/12/01	SHEET 2 OF 3 CAMP PRECAST CONCRETE PRODUCTS
--	---	---