




138"
VD 367
 WHITE SYMBOLS, BORDER & TEXT
 WITH BLUE BACKGROUND
MM 113.21 NB.

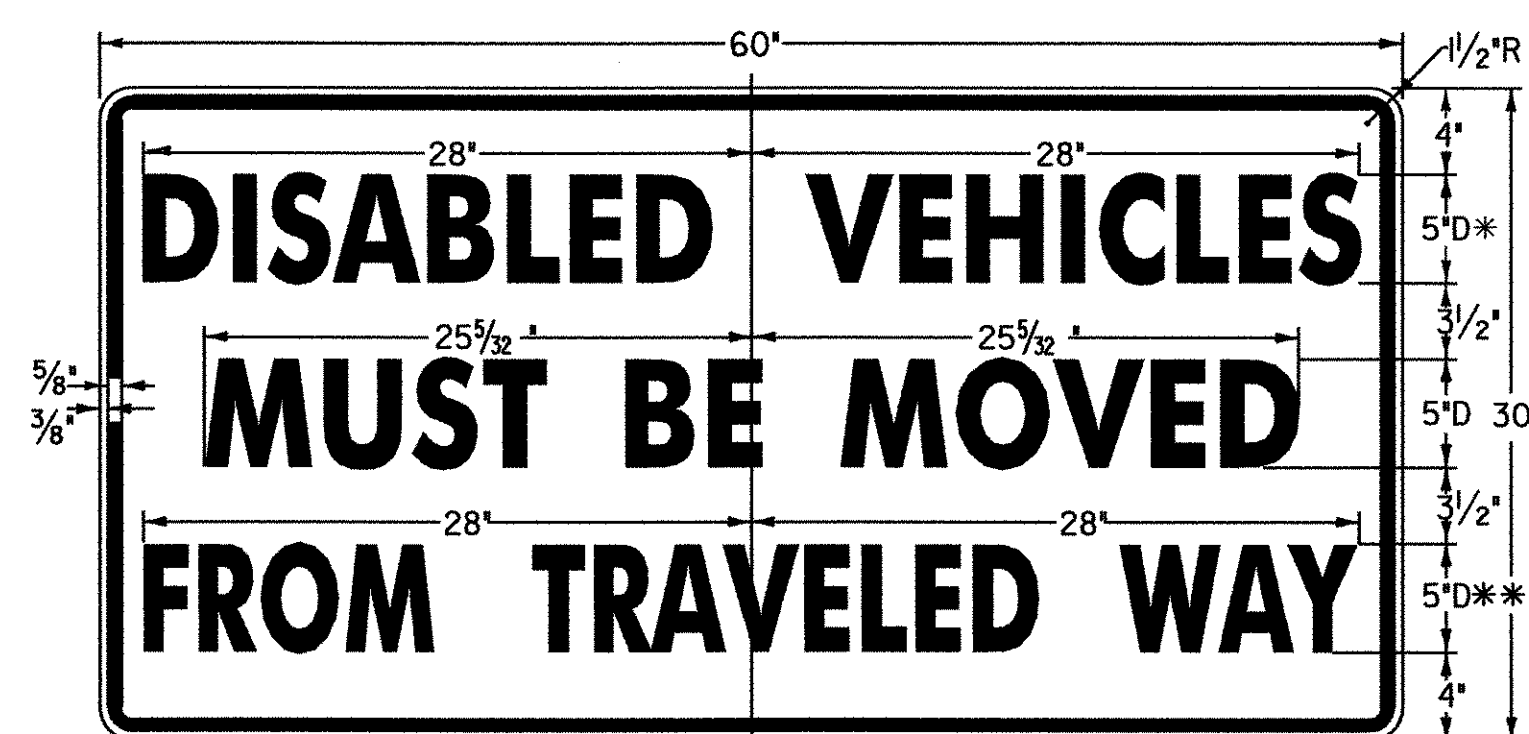

VC-838
 • REDUCE SPACING BY 5%
 •• REDUCE SPACING BY 13%
 COLORS: BLACK TEXT AND BORDER
 WITH REFLECTORIZED ORANGE BACKGROUND

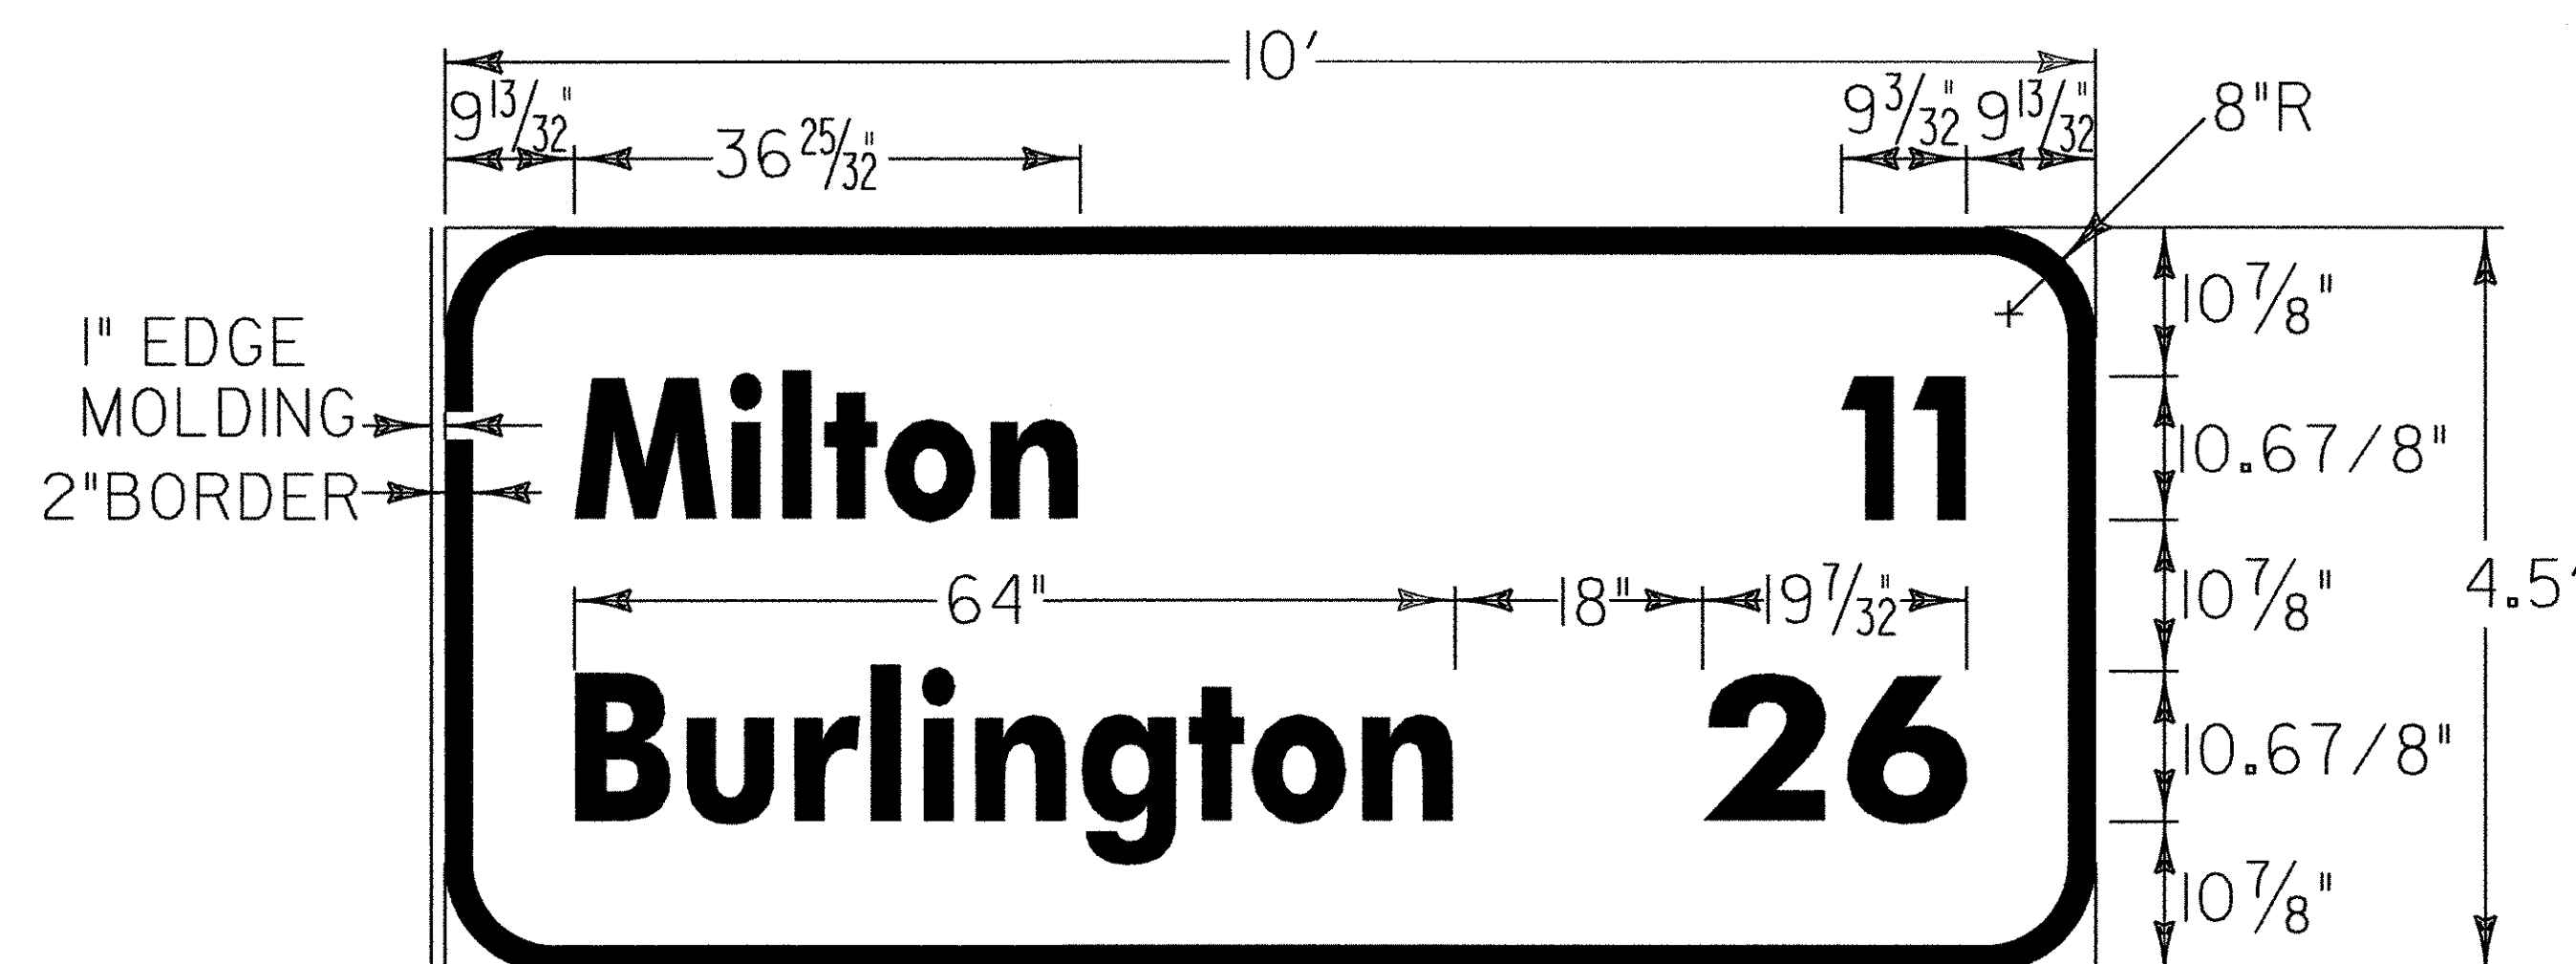

MM 112.522 SB.
 REFLECTORIZED WHITE TEXT, BORDER
 WITH REFLECTORIZED GREEN BACKGROUND

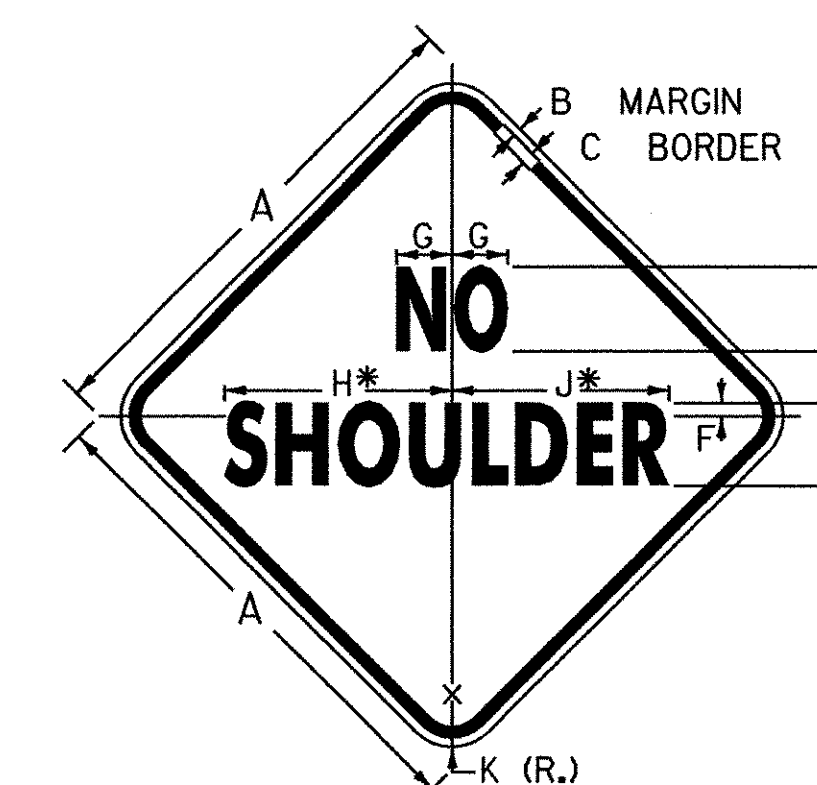

* REDUCE SPACING 25% **VC-827**

SIGN	DIMENSIONS (INCHES)										
	A	B	C	D	E	F	G	H	J	K	
STD.	30	1/2	3/4	5C	3	3/4	3 1/2	13 1/8	13 1/8	1 1/8	
EXPWY.	36	5/8	1 1/8	6C	3 1/2	1	4	16 1/2	15 3/4	2 1/4	
FWY.	48	3/4	1 1/4	8C	5	1 1/4	5 1/2	21 1/8	20 1/8	3	

COLORS
 LEGEND & BORDER- BLACK (NON-REFL)
 BACKGROUND - ORANGE (REFL)

SIGN DETAILS

/87A007B/DESIGN/DA007FRM.DGN
 /87A007B/DESIGN/DA007SDI.I

PREPARED BY JHK DATE 12/98
 CHECKED BY _____ DATE _____
 DESIGN SUPERVISOR ABK DATE 12/98
 PROJ. FAIRFAX-FAIRFIELD-ST.ALBANS
 IM 089-3 (27)

PLOTTED: 17-NOV-2000
 SHEET 34 OF 370 SHEETS