

SB CURVE#1 DATA
Δ = 3°18'-43.38" LT.
D = 0°15'
R = 22918.32'
T = 662.59'
L = 1324.82'
E = 9.58'
BANK = 0.021 FT / FT


SOUTHBOUND: 8" UNDERDRAIN (MODIFICATION #1)
② 3282+50 LT - 3285+00 LT W/FB @ 3282+50 LT
SOUTHBOUND: 8" UNDERDRAIN (MODIFICATION #2)
① 3282+50 LT - 3285+00 LT W/FB @ 3282+50 LT



SB STA. 3269+00
BEGIN APPROACH CONSTRUCTION

SB MM 111.00 =
SB STA. 3281+00
END APPROACH CONSTRUCTION
END PROJECT IM 089-3 (26)
BEGIN PROJECT IM 089-3 (27)

SB STA. 3282+50
BEGIN RECONSTRUCTION

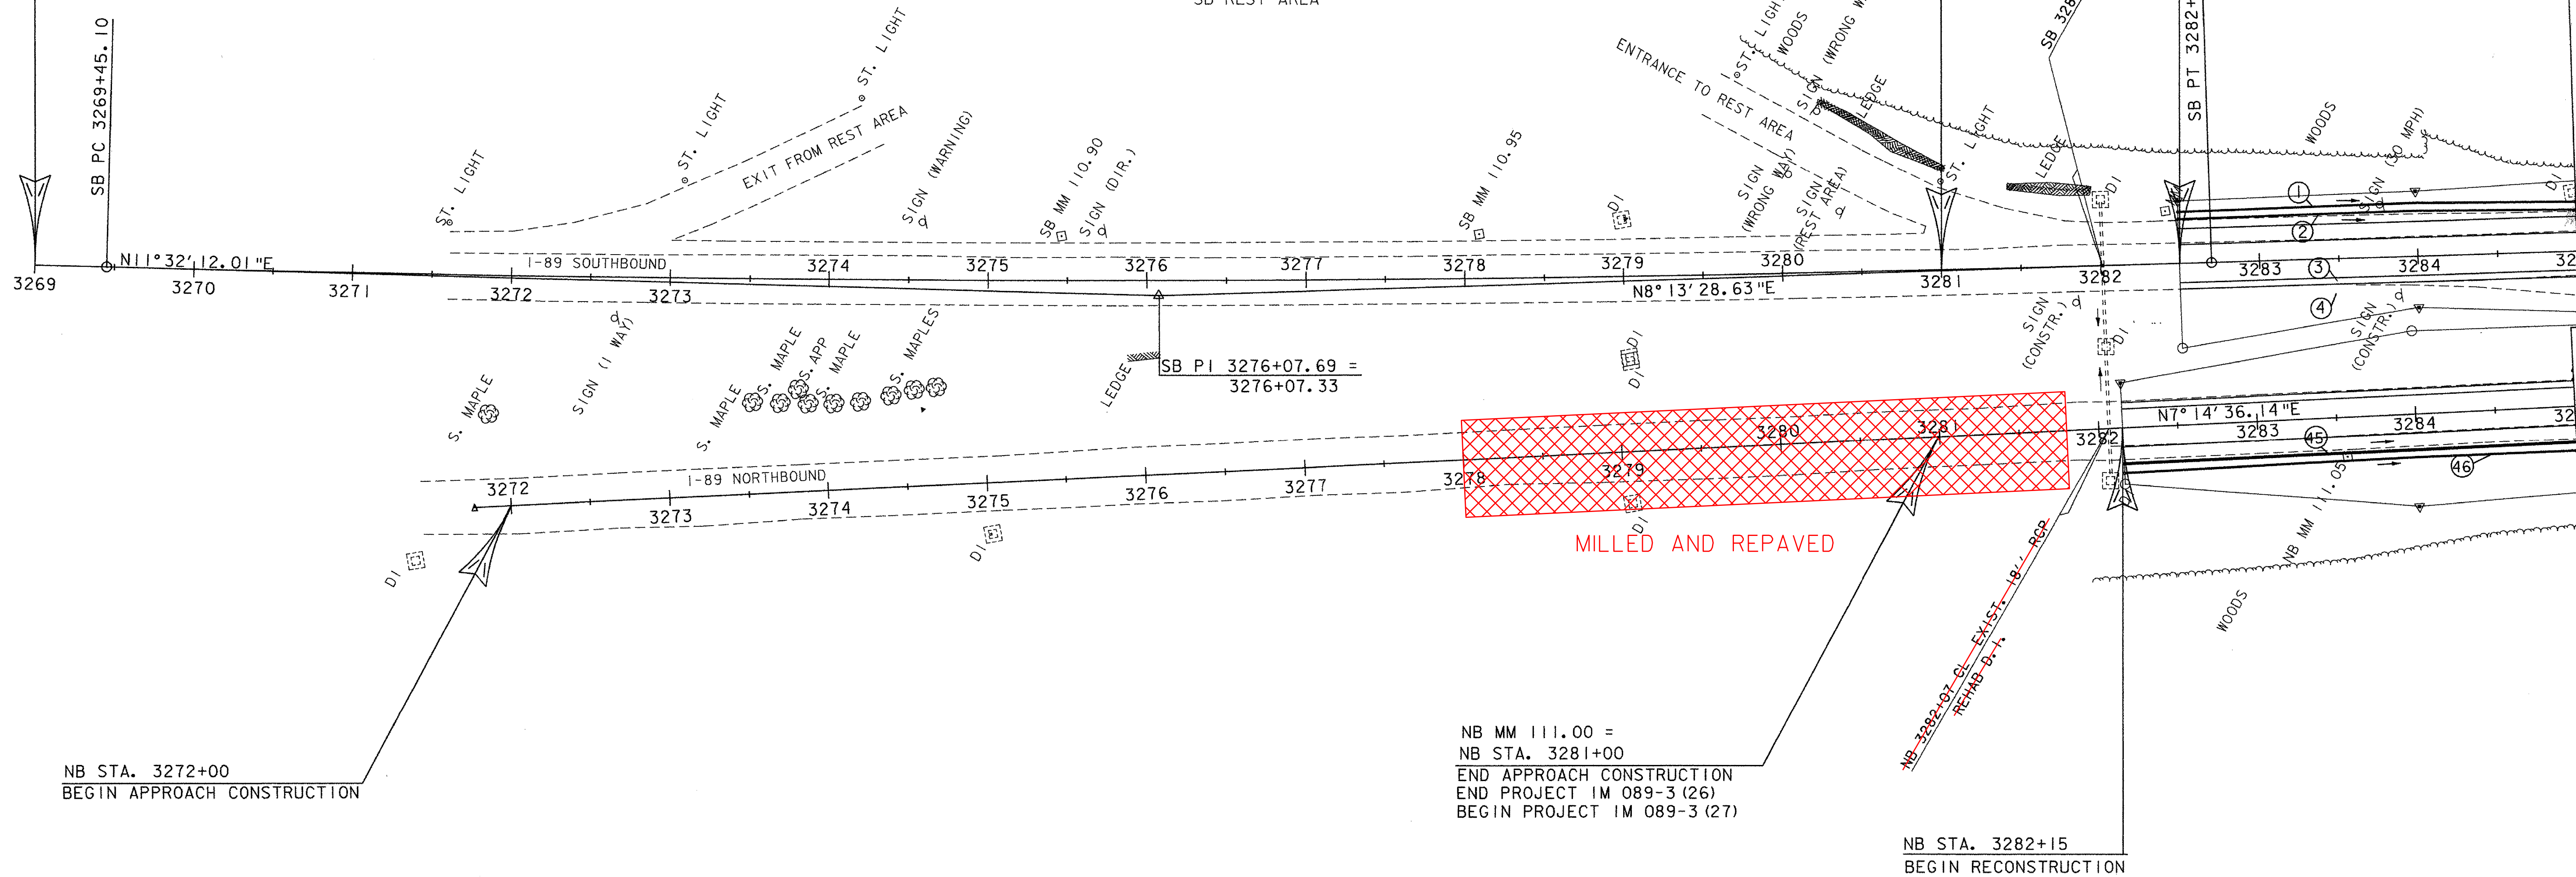

REMOVAL OF EXISTING FENCE (MOD.)

STA. 3284+60 NB RT
STA. 3284+90 NB RT

WOVEN WIRE FENCE W/STEEL POSTS

STA. 3284+60 NB RT
STA. 3284+90 NB RT

NORTHBOUND: 8" UNDERDRAIN (MODIFICATION #1)

④5 3282+15 RT - 3285+00 RT W/FB @ 3282+15 RT
3289 21

NORTHBOUND: 8" UNDERDRAIN (MODIFICATION #2)

④6 3282+15 RT - 3285+00 RT W/FB @ 3282+15 RT
20 3284+95

SB 3269+00 - 3285+00
NB 3272+00 - 3285+00

PROJECT: FAIRFAX - FAIRFIELD - ST. ALBANS

PROJECT NO.: IM 089-3(27)

DESIGN FILE NAME: /87A007B/DESIGN/DA007NUL.DGN

IPARM FILE NAME: DA007LOI

SURVEYED BY: ORVIS


SQUAD LEADER: DELLA SANTA

PLOT DATE: 18-AUG-2000

SURVEY DATE: 6/98

DRAWN BY: SQUAD B

SHEET: 49 OF 370

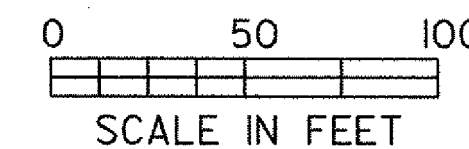

DATUM

VERTICAL NAVD88

HORIZONTAL NAD83(92)