



**SOUTHBOUND GRADE PROFILE ALONG MEDIAN SIDE (REFER TO TYPICAL SHEET)**  
**STA. 3317+00 - 3333+00**

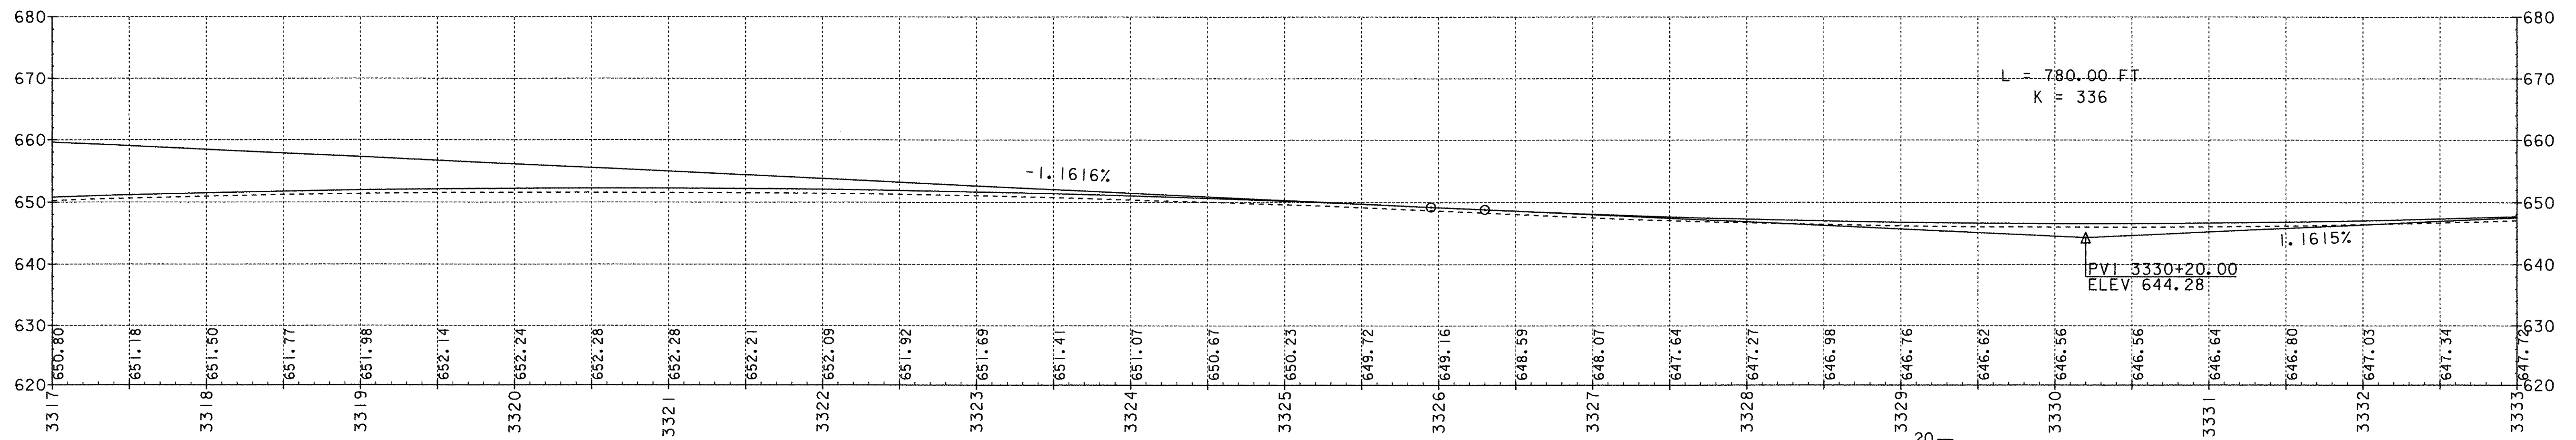

**NORTHBOUND GRADE PROFILE ALONG MEDIAN SIDE (REFER TO TYPICAL SHEET)**  
**STA. 3317+00 - 3333+00**

**DATUM**  
 VERTICAL NAVD88  
 HORIZONTAL NAD83(92)

SCALES IN FEET

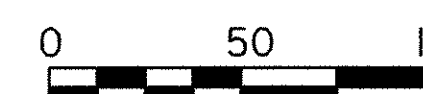

PROJECT: FAIRFAX - FAIRFIELD - ST. ALBANS	PROJECT NO.: IM 089-3(27)
DESIGN FILE NAME: /87A007B/DESIGN/DA007XSI.DGN	PLOT DATE: 04-OCT-2000
IPARM FILE NAME: DA007P04	SURVEY DATE: 6/98
SURVEYED BY: ORVIS	DRAWN BY: SQUAD_B
SQUAD LEADER: DELLA SANTA	SHEET: 56 OF 370