



SOUTHBOUND GRADE PROFILE ALONG MEDIAN SIDE (REFER TO TYPICAL SHEET)
STA. 3333+00 - 3349+00

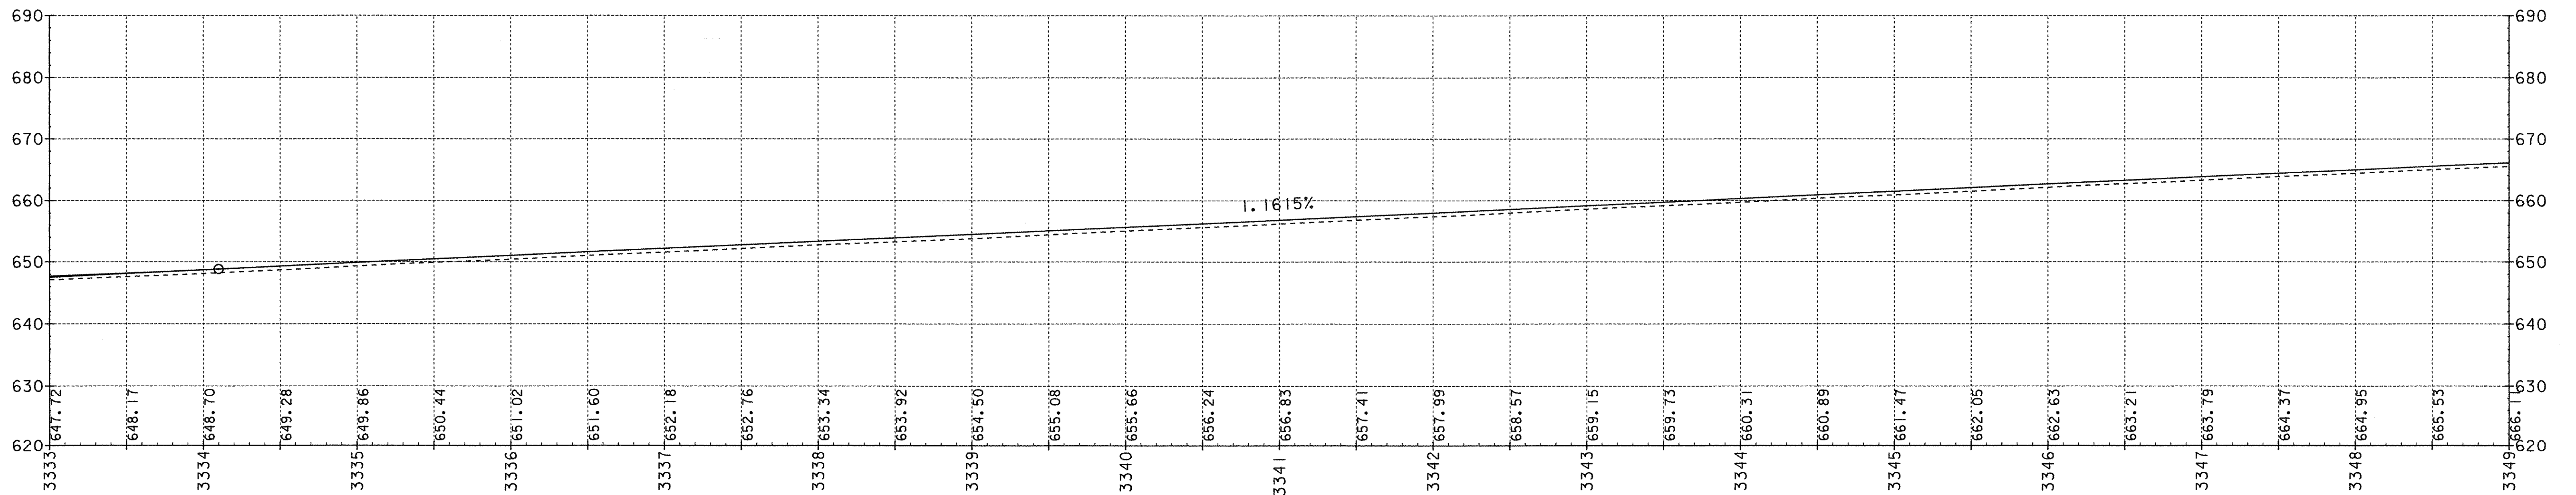

NORTHBOUND GRADE PROFILE ALONG MEDIAN SIDE (REFER TO TYPICAL SHEET)
STA. 3333+00 - 3349+00

DATUM
 VERTICAL NAVD88
 HORIZONTAL NAD83(92)

SCALES IN FEET

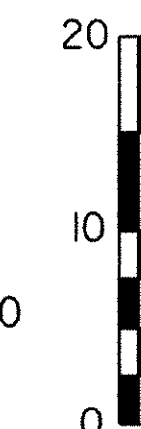

PROJECT:	FAIRFAX - FAIRFIELD - ST. ALBANS	PROJECT NO.:	IM 089-3(27)
DESIGN FILE NAME:	/87A007B/DESIGN/DA007XSI.DGN	IPARM FILE NAME:	DA007P05
SURVEYED BY:	ORVIS	PLOT DATE:	04-OCT-2000
SQUAD LEADER:	DELLA SANTA	SURVEY DATE:	6/98
		DRAWN BY:	SQUAD B
		SHEET:	58 OF 370