



SOUTHBOUND GRADE PROFILE ALONG MEDIAN SIDE (REFER TO TYPICAL SHEET)
STA. 3365+00 - 3381+00

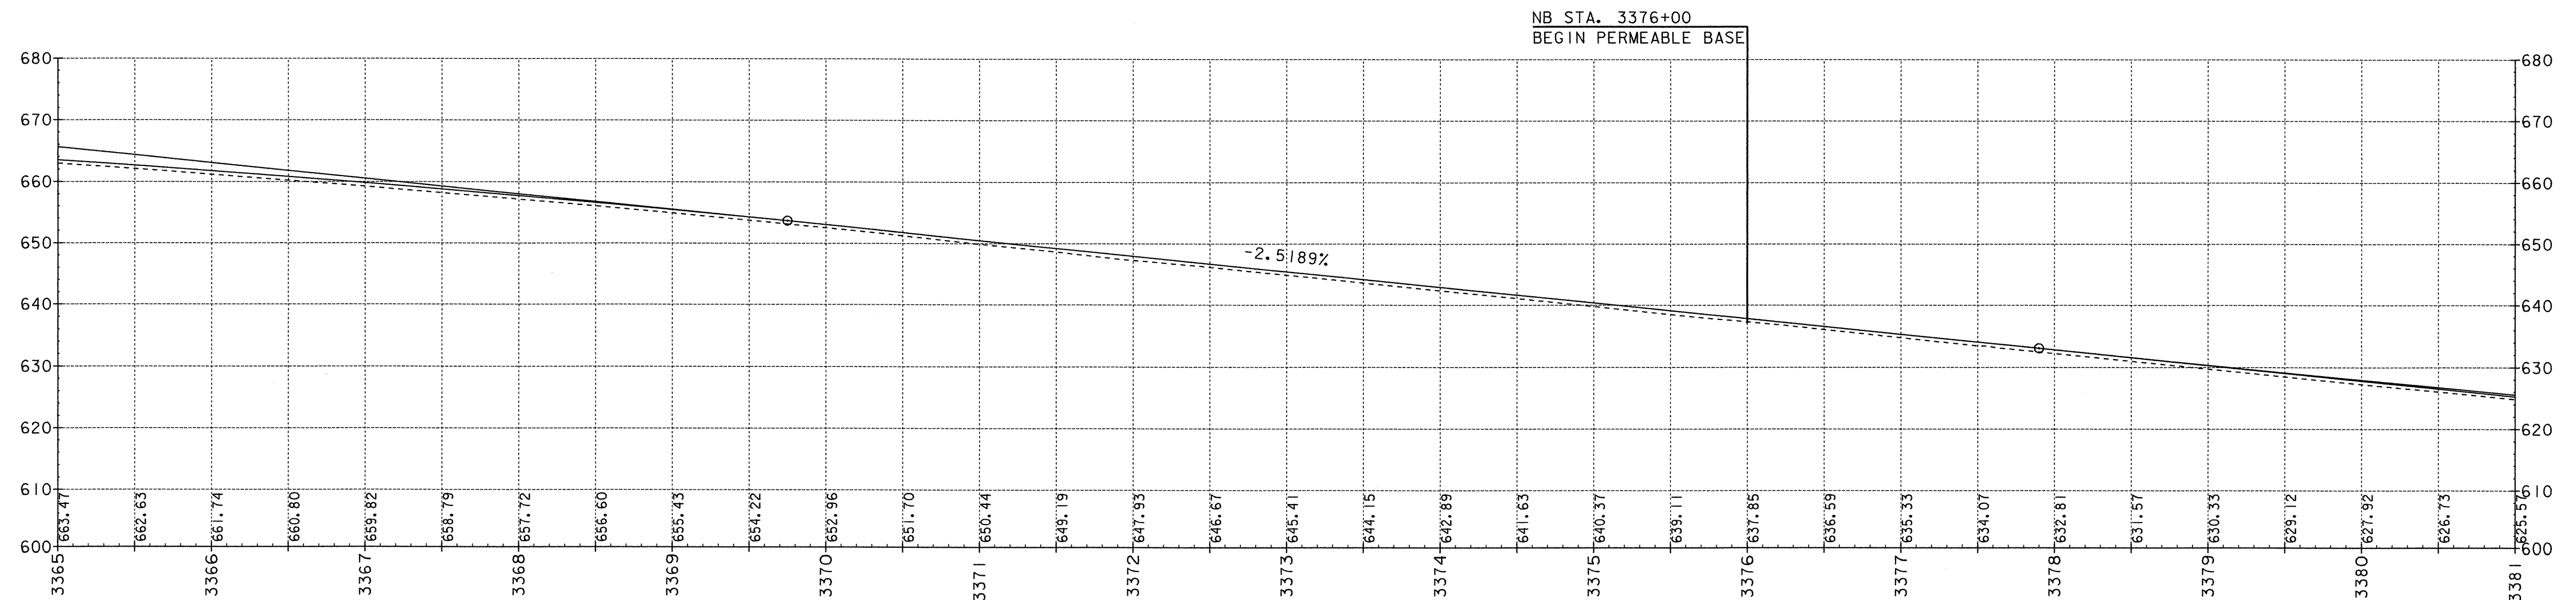

NORTHBOUND GRADE PROFILE ALONG MEDIAN SIDE (REFER TO TYPICAL SHEET)
STA. 3365+00 - 3381+00

DATUM
 VERTICAL NAVD88
 HORIZONTAL NAD83(92)

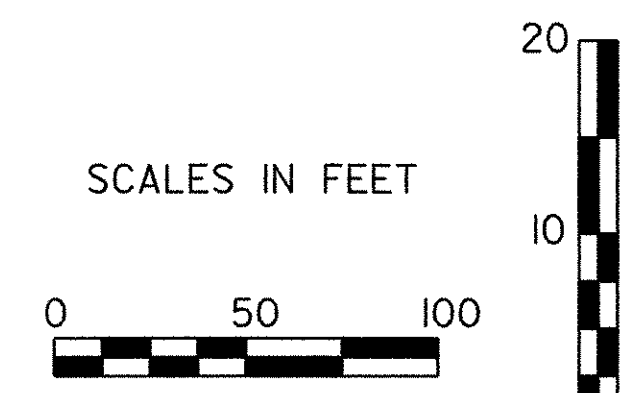

PROJECT: FAIRFAX - FAIRFIELD - ST. ALBANS	PROJECT NO. : IM 089-3(27)
DESIGN FILE NAME: /87A007B/DESIGN/DA007XSI.DGN	PLOT DATE: 04-OCT-2000
IPARM FILE NAME: DA007P07	SURVEY DATE: 6/98
SURVEYED BY: ORVIS	DRAWN BY: SQUAD_B
SQUAD LEADER: DELLA SANTA	SHEET: 62 OF 370