


RAMP C PROFILE

DATUM
VERTICAL NAVD88
HORIZONTAL NAD83(92)

SCALES IN FEET

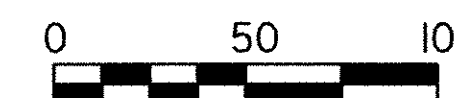

PROJECT: FAIRFAX - FAIRFIELD - ST. ALBANS	PROJECT NO.: IM 089-3(27)
DESIGN FILE NAME: /87A007B/DESIGN/DA007RMC.DGN	PLOT DATE: 22-AUG-2000
IPARM FILE NAME: DA007RCP	SURVEY DATE: 6/98
SURVEYED BY: ORVIS	DRAWN BY: SQUAD B
SQUAD LEADER: DELLA SANTA	SHEET: 73 OF 370