


INLET HEADWALL NOTES


1. NO HEADWALL CONCRETE REPAIRS ARE ANTICIPATED AT THE INLET END. ANY REPAIRS NECESSITATED DUE TO CONTRACTOR NEGLIGENCE SHALL BE PERFORMED AT NO EXPENSE TO THE STATE. ANY REPAIRS DIRECTED BY THE RESIDENT ENGINEER SHALL BE PAID FOR AS EXTRA WORK.
2. ANCHOR BOLTS SHALL BE INSTALLED TO THE SPECIFICATIONS OF THE MANUFACTURER.
3. INSTALL ANCHOR BOLTS IN ALTERNATE CIRCUMFERENTIAL SEAM HOLES TO THE ORIGINAL INSTALLATION. GROUT REMAINING VOID WITH NON-SHRINK GROUT.
4. MATERIAL FOR GROUTING SHALL MEET THE REQUIREMENTS OF SUBSECTION 707.03 OF THE STANDARD SPECIFICATIONS FOR CONSTRUCTION.
5. PAYMENT FOR THE BOLTS AND GROUT MATERIAL AND ALL MATERIALS, LABOR, AND INCIDENTALS ASSOCIATED WITH THEIR INSTALLATION AND APPLICATION, RESPECTIVELY, SHALL BE MADE SUBSIDIARY TO ITEM 501.58, "MORTAR, TYPE IV (MOD)".
6. WATER REPELLENT SHALL BE APPLIED TO ALL EXPOSED CONCRETE SURFACES.

NEW $\frac{3}{4}$ " DIA. X 7" MECHANICAL ANCHOR BOLTS
(HILTI KWIK-BOLT 34-7 OR SIMILAR) WITH SINGLE
NUT WITH 1" SPHERICAL RADIUS (ASTM-A563)

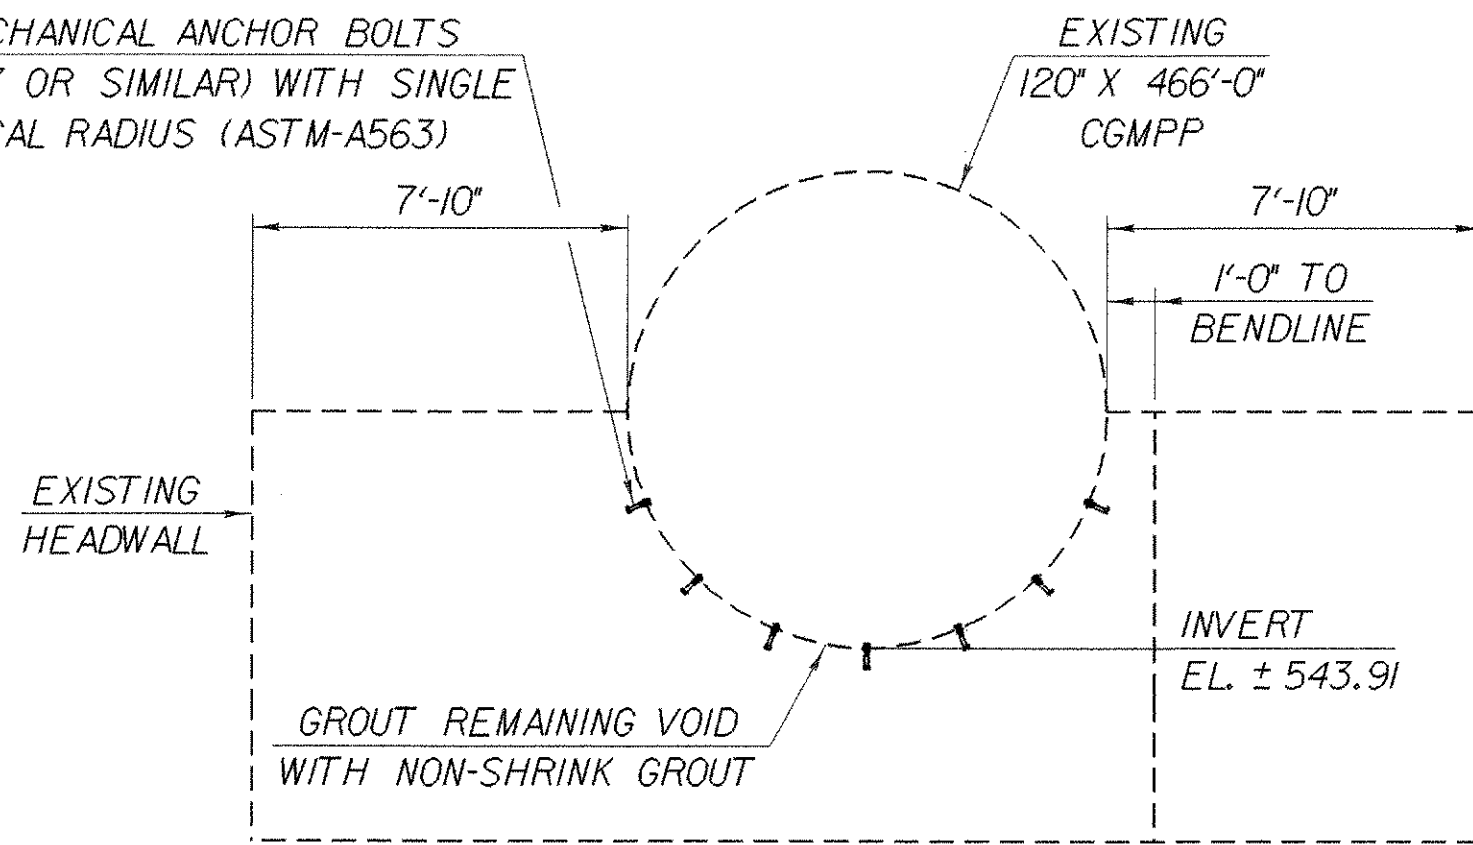


INLET HEADWALL ELEVATION

SCALE $\frac{1}{4}$ " = 1'-0"

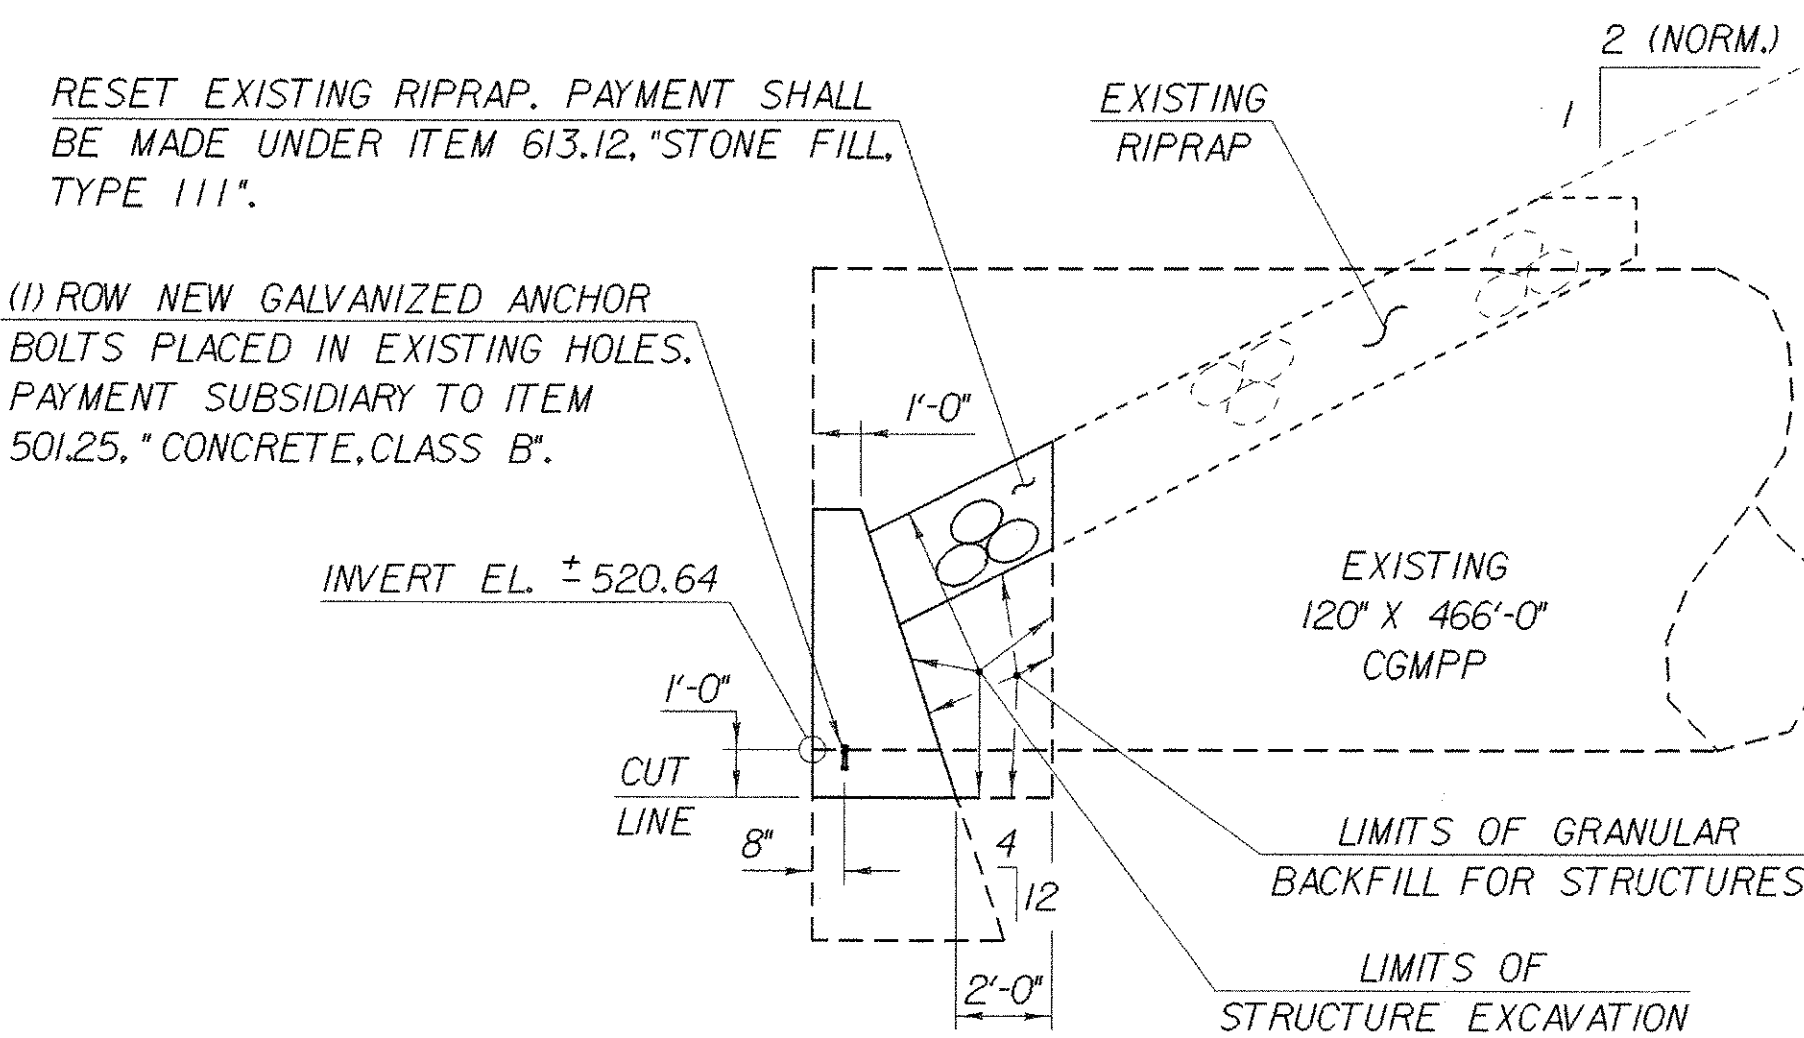


OUTLET SECTION AT PIPE CENTERLINE

SCALE $\frac{1}{4}$ " = 1'-0"

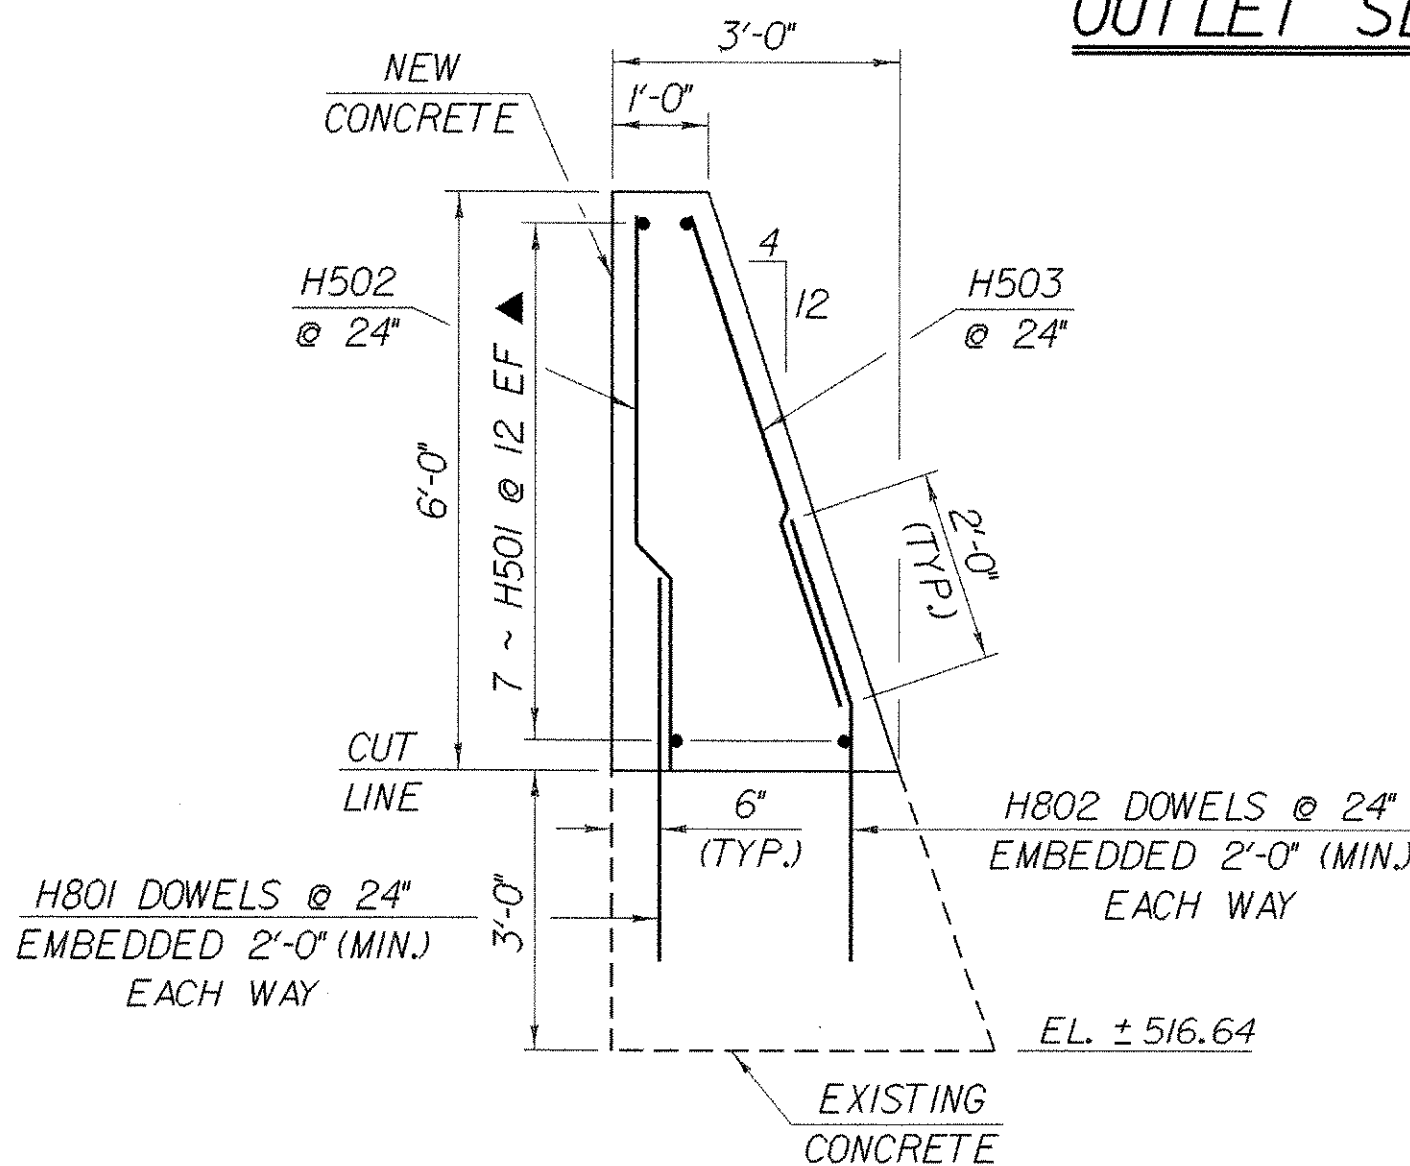


OUTLET HEADWALL TYPICAL SECTION

SCALE $\frac{1}{2}$ " = 1'-0"

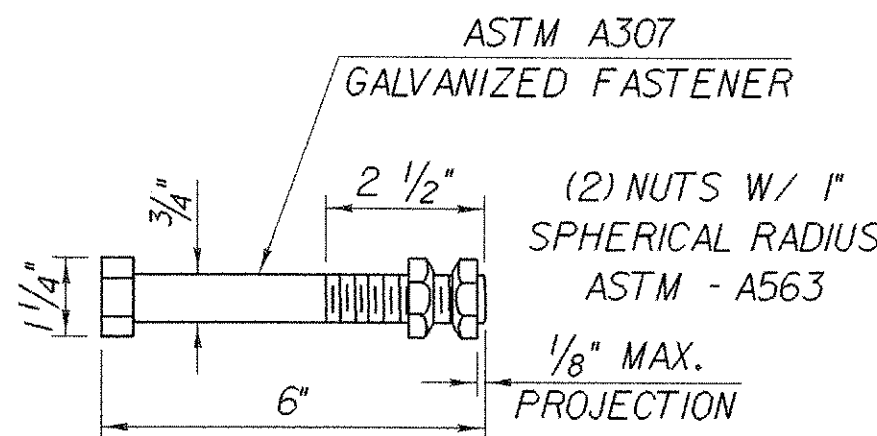

ANCHOR BOLT DETAIL FOR OUTLET HEADWALL

NTS

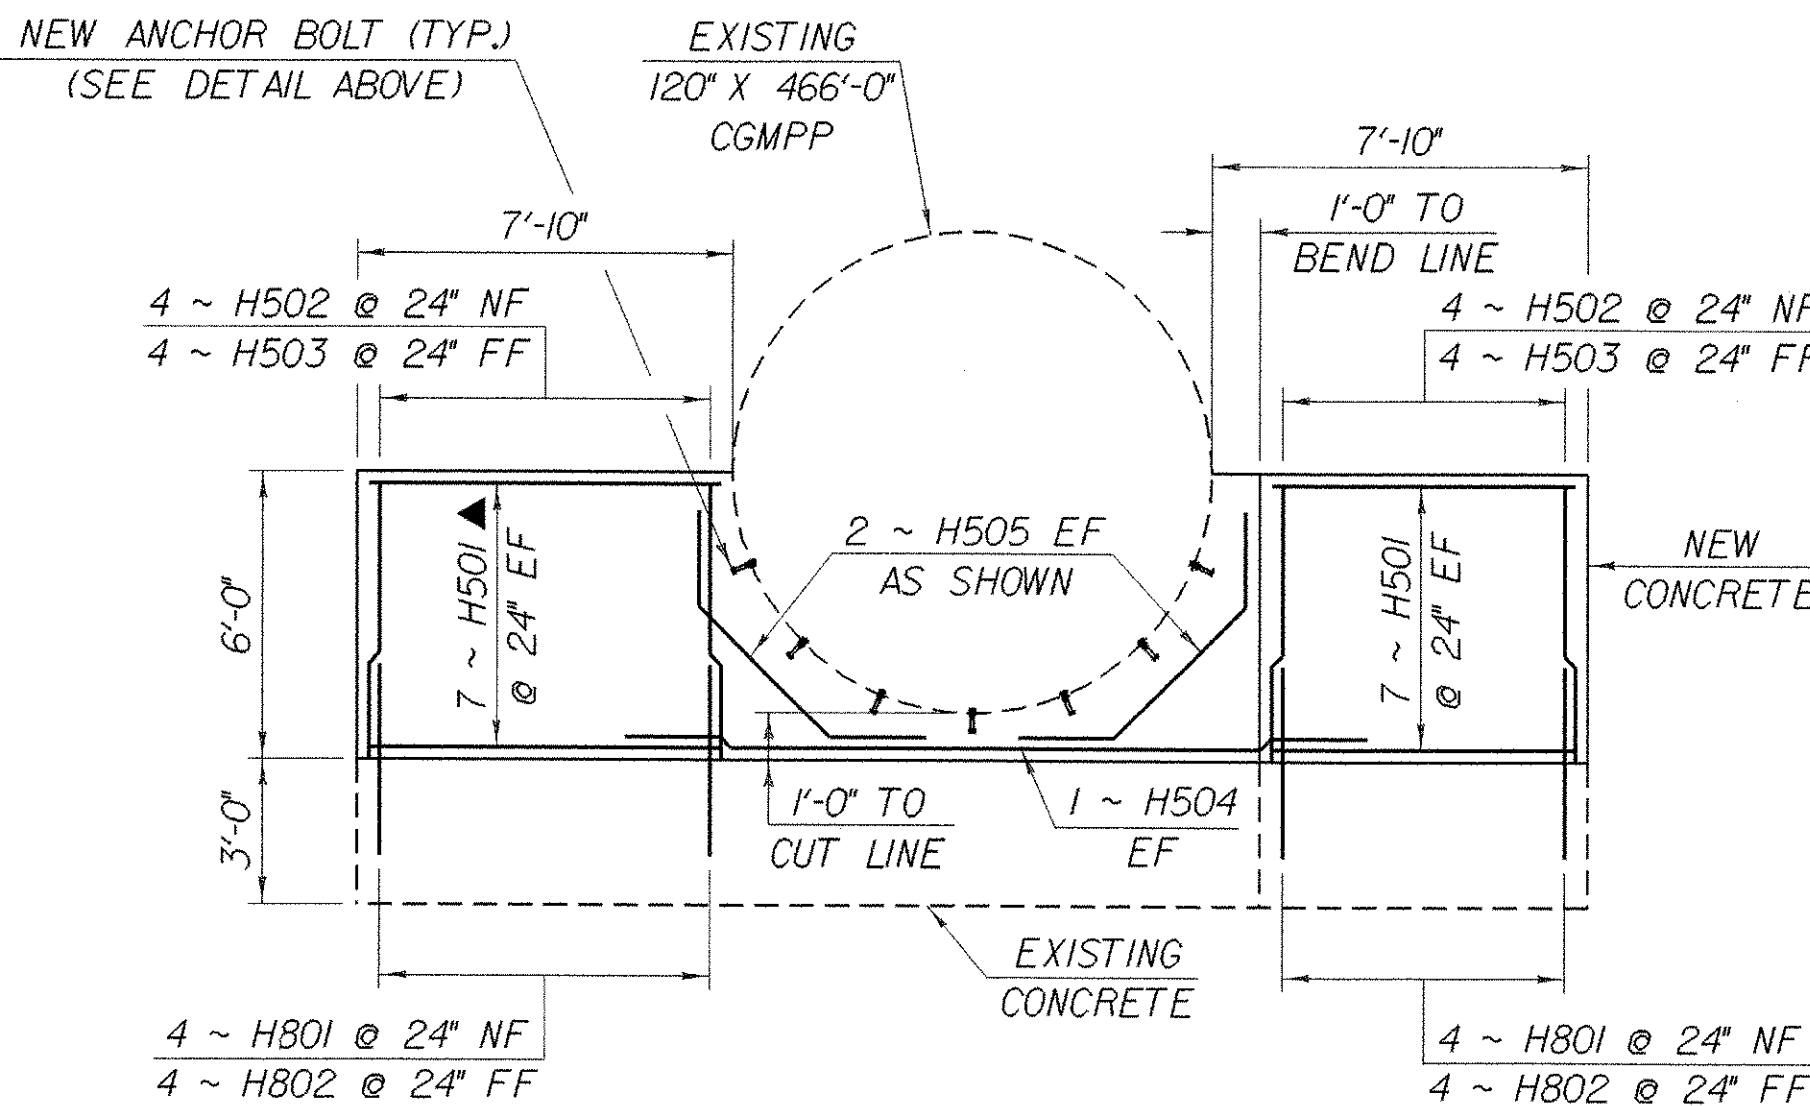

OUTLET HEADWALL ELEVATION

SCALE $\frac{1}{4}$ " = 1'-0"

NOTE:

NF = NEAR FACE
FF = FAR FACE
EF = EACH FACE
▲ = CUT TO FIT IN FIELD
3" CLR. UNLESS OTHERWISE SPECIFIED ON THE PLANS.

**STATE OF VERMONT
AGENCY OF TRANSPORTATION**

Town Of FAIRFAX-FAIRFIELD-ST. ALBANS	Bridge No. 86-5
Highway No. 1-89	Log Sta. MM 111.28 Surv. Sta.
1-89 OVER THE MILL RIVER	
86-5 HEADWALL DETAILS	
Designed By M.LOZIER	Drawn By K.CHISHOLM
Checked By G.ROY	Bridge Design Supervisor
Date 10/99	Date 10/99
PROJECT FAIRFAX-FAIRFIELD-ST. ALBANS	PROJECT NO. 1M 089 - 3 (27)
I.G.C. Info. 96a056Structures\sa056p1.dgn	sa056nwj
Bridge Sheet No. BR101	Sheet 75 of 370

PLOTTED 21-SEP-2000