



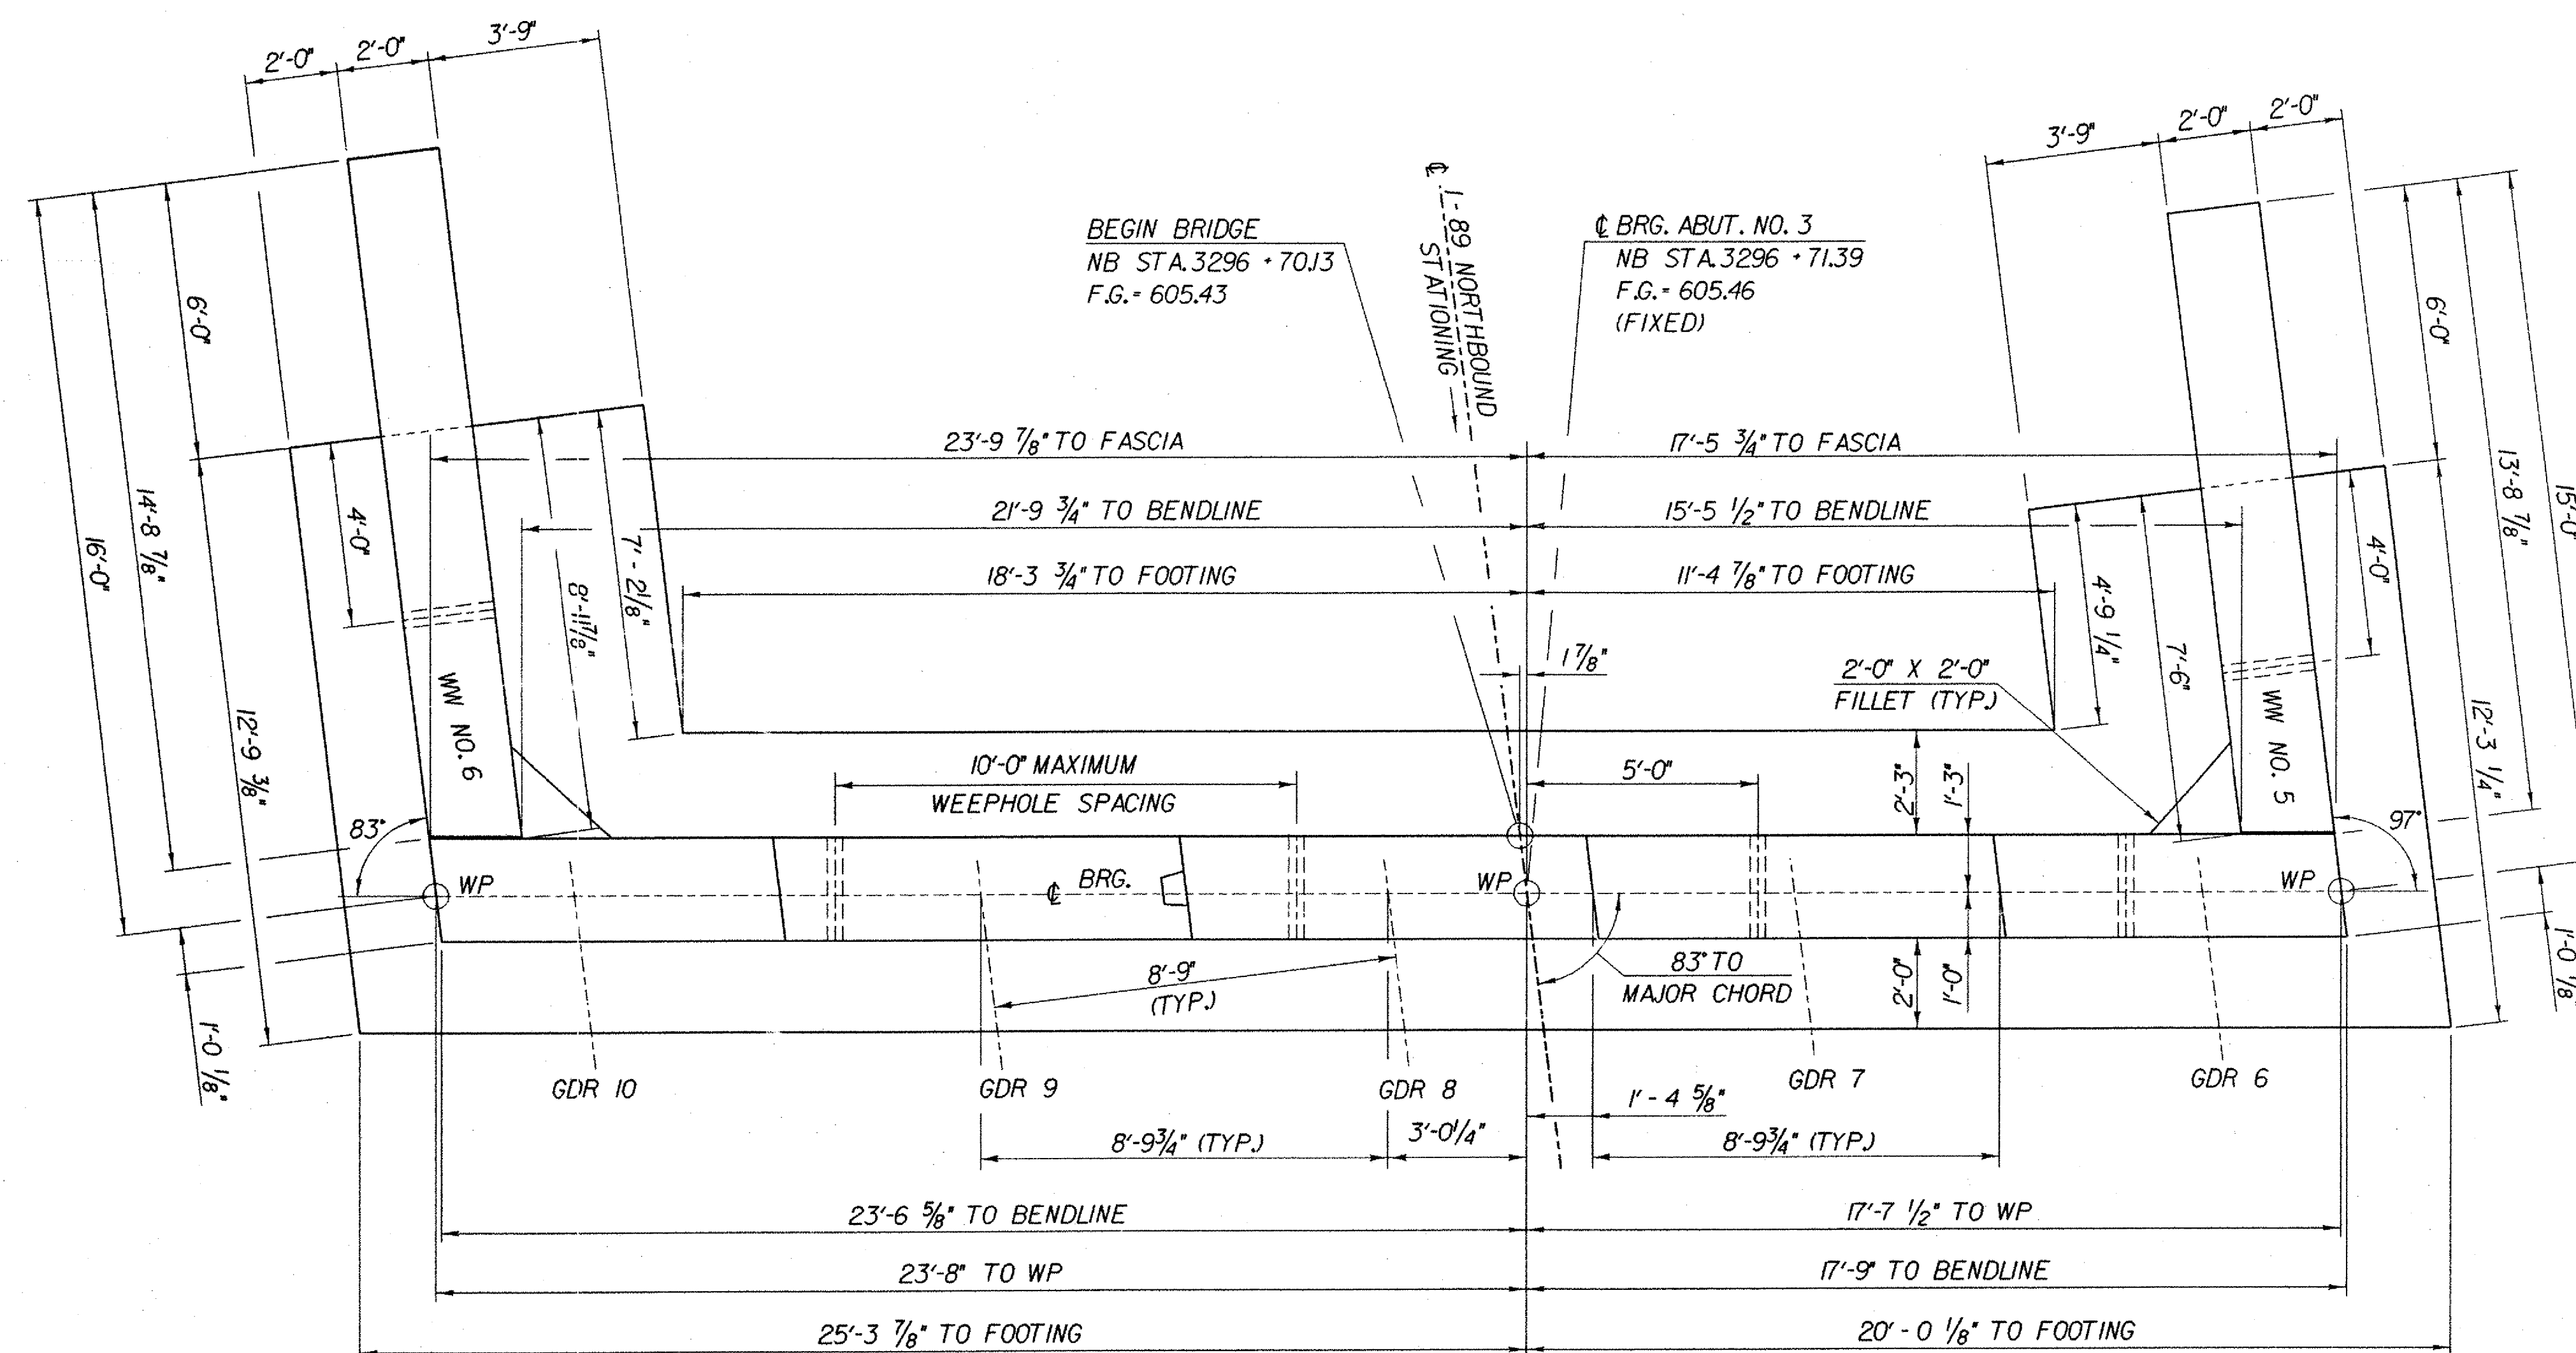


HIGH PERFORMANCE CONCRETE WAS USED
EXCLUSIVELY ON BR 87N

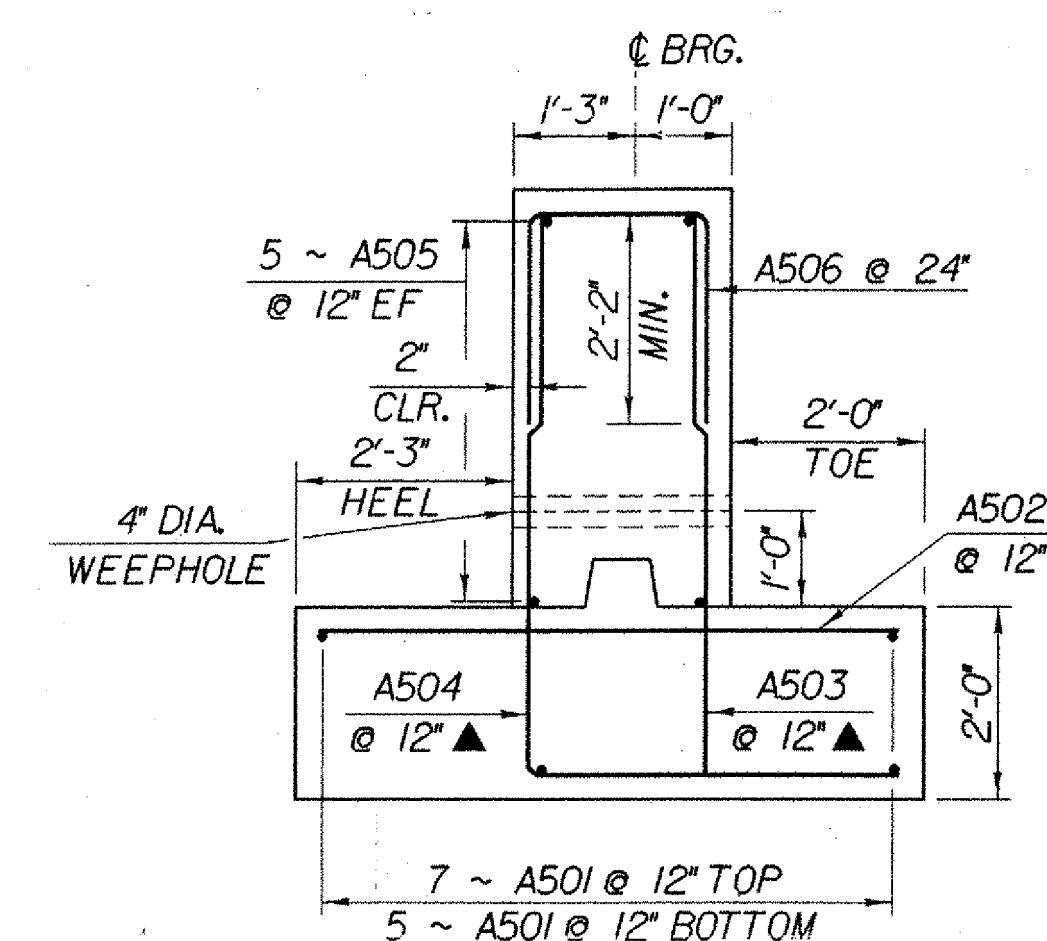

ABUTMENT TYPICAL

SCALE: 1/2" = 1'-0"

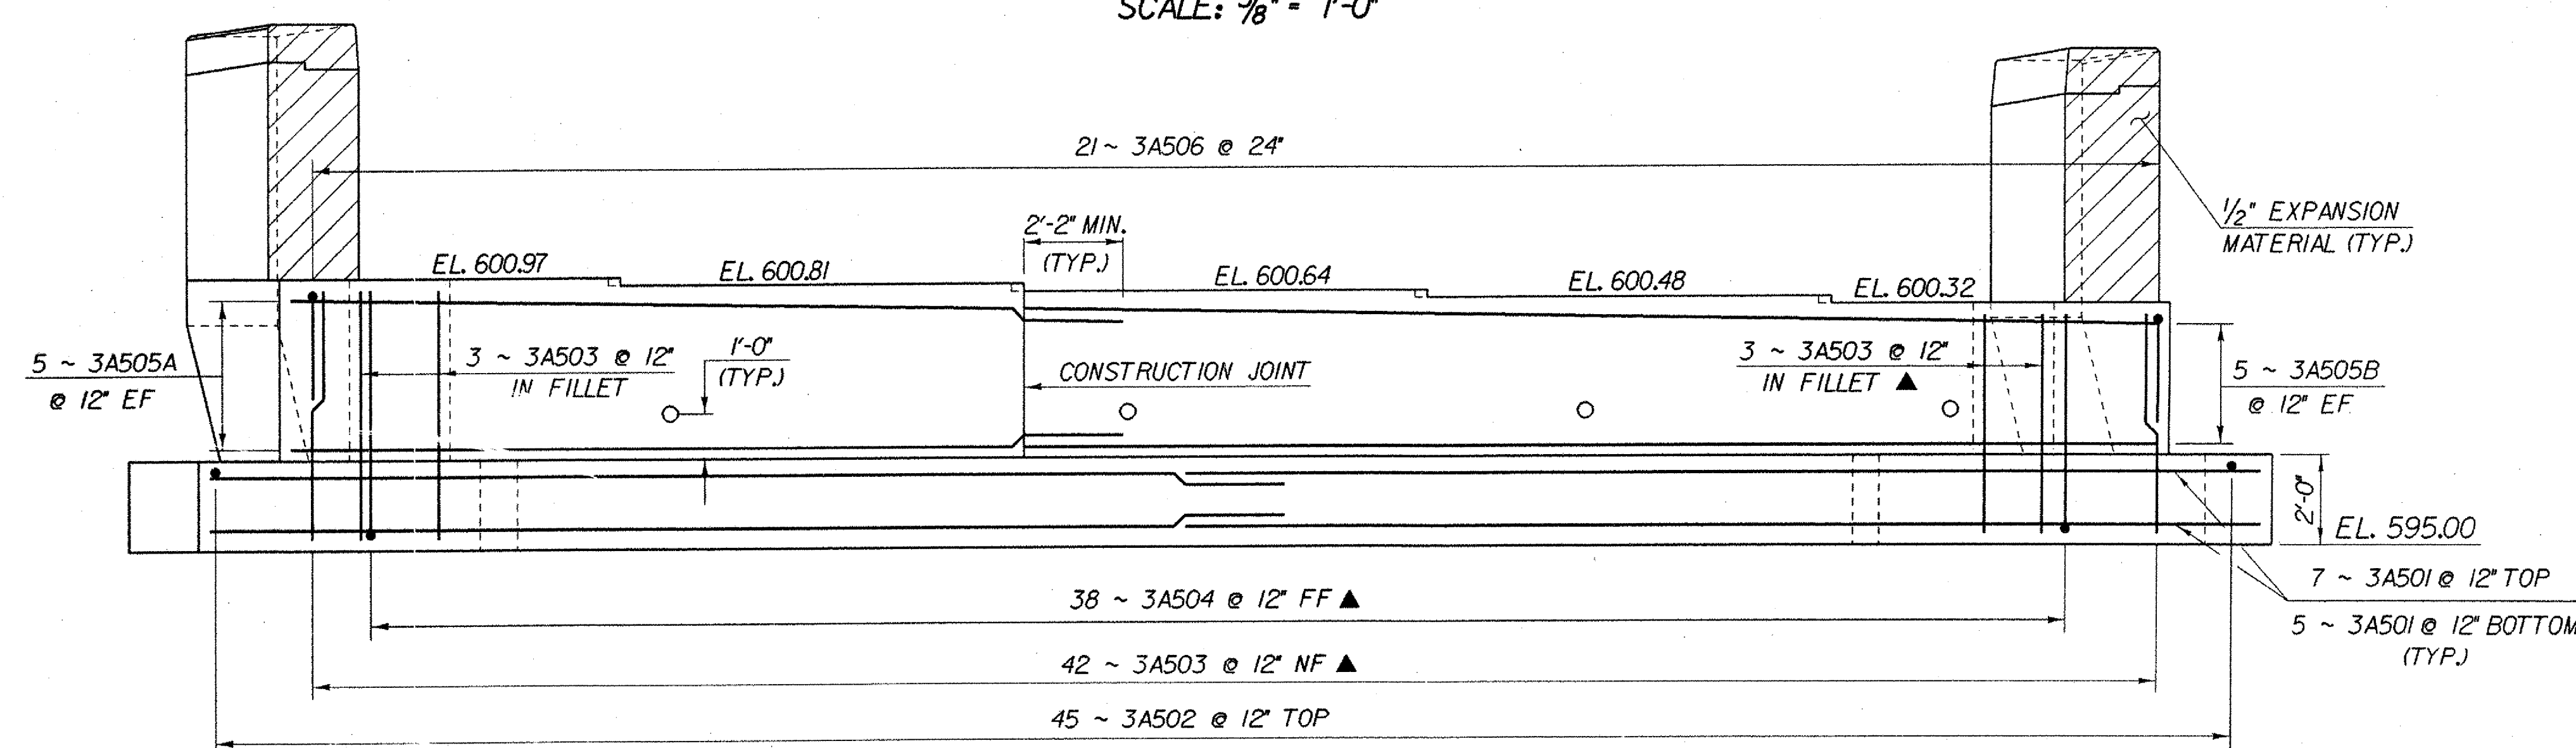

ABUTMENT NO.3 ELEVATION

SCALE: $\frac{3}{8}" = 1'-0"$

**IMPORTANT NOTE: BRIDGE FINISHED GRADES
ARE CENTERLINE GRADES.**

NOTE:

NF - NEAR FACE
 FF - FAR FACE
 EF - EACH FACE
 ▲ - CUT TO FIT IN FIELD
 3" CLR. UNLESS OTHERWISE
 SPECIFIED ON THE PLANS.

STATE OF VERMONT AGENCY OF TRANSPORTATION			
Town Of FAIRFAX-FAIRFIELD-ST. ALBANS		Bridge No. 87N	
Highway No. I-89		Log Sta. Surv. Sta.	
I-89 OVER VT 104			
ABUTMENT NO. 3 DETAILS			
Designed By M.LOZIER		Drawn By K.CHISHOLM	
Checked By GR0Y	Date 10/99	Bridge Design Supervisor R.R.WHITCOMB Date 11/99	
PROJECT FAIRFAX-FAIRFIELD-ST.ALBANS		PROJECT NO. 1 M 089 - 3 (27)	
I.G.C. Info. 94 J106\Structures\9406ab.dgn		sa056ab3J	
Bridge Sheet No. BR224		Sheet 102 of 370	

PLOTTED . 21-SEP-2000