



VT 104 STA. 12+23 LT.
 END STRUCTURE EXCAVATION
 SELECTED BACKFILL FOR MSE WALL
 VT 104 STA. 12+18 RT.
 END GRAN. BACKFILL FOR STRUCT.

12+25

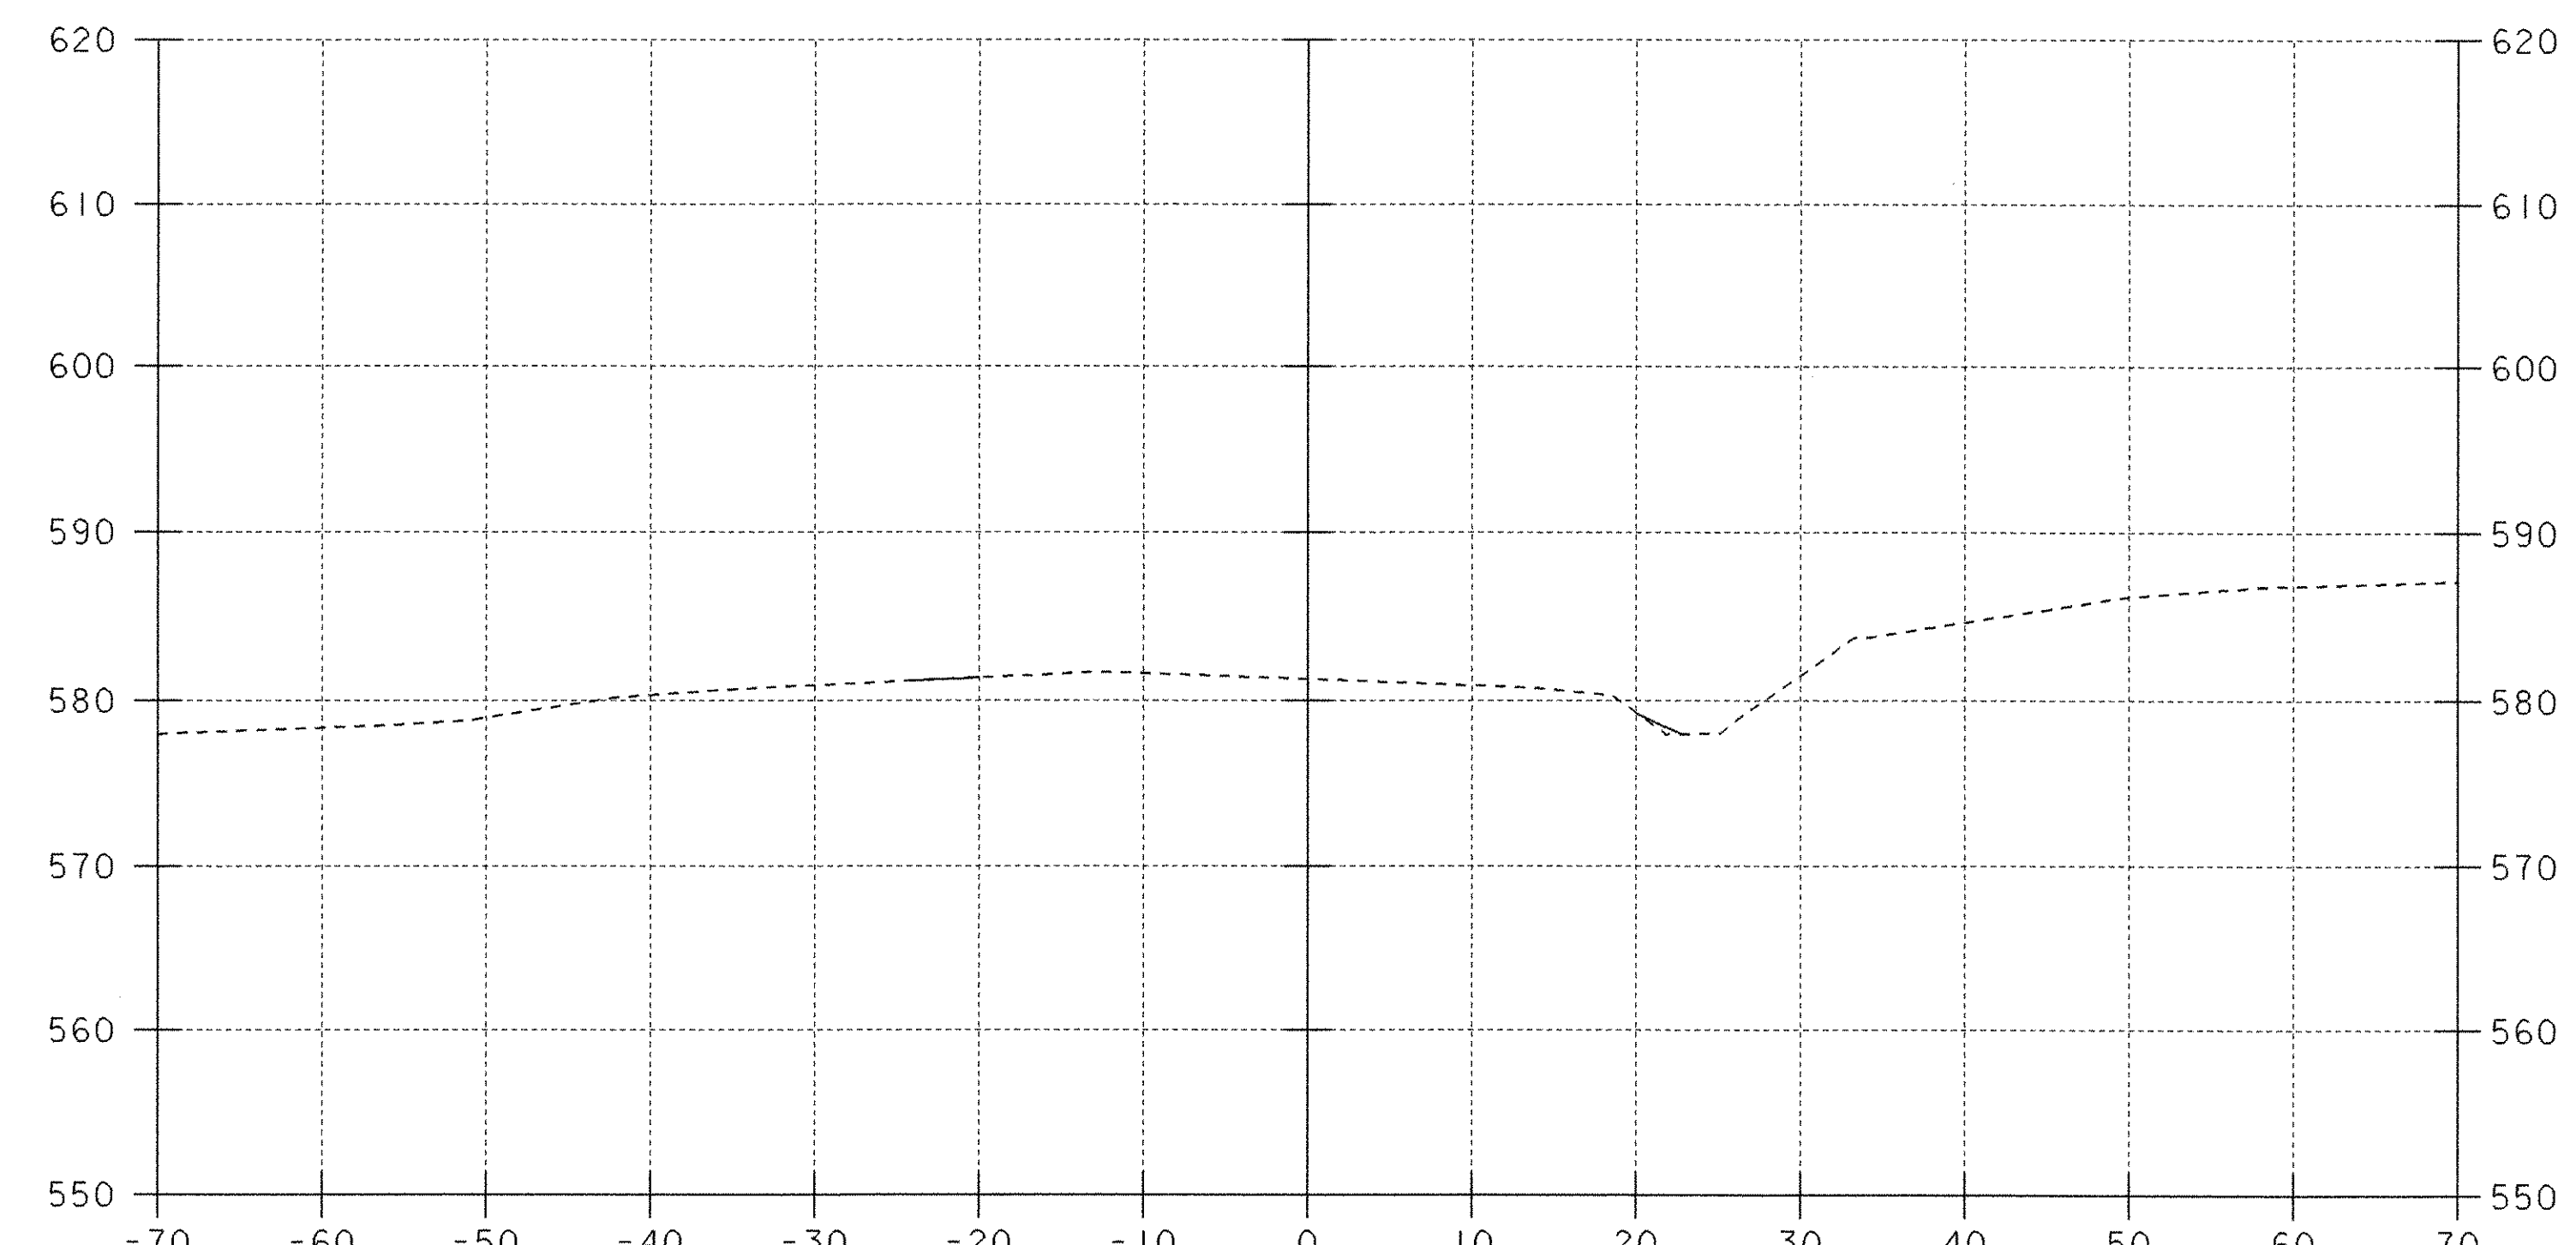


VT 104 STA. 12+75 LT.
 END TRENCH EXCAVATION
 VT 104 STA. 12+75 RT.
 END TRENCH EXCAVATION

12+75

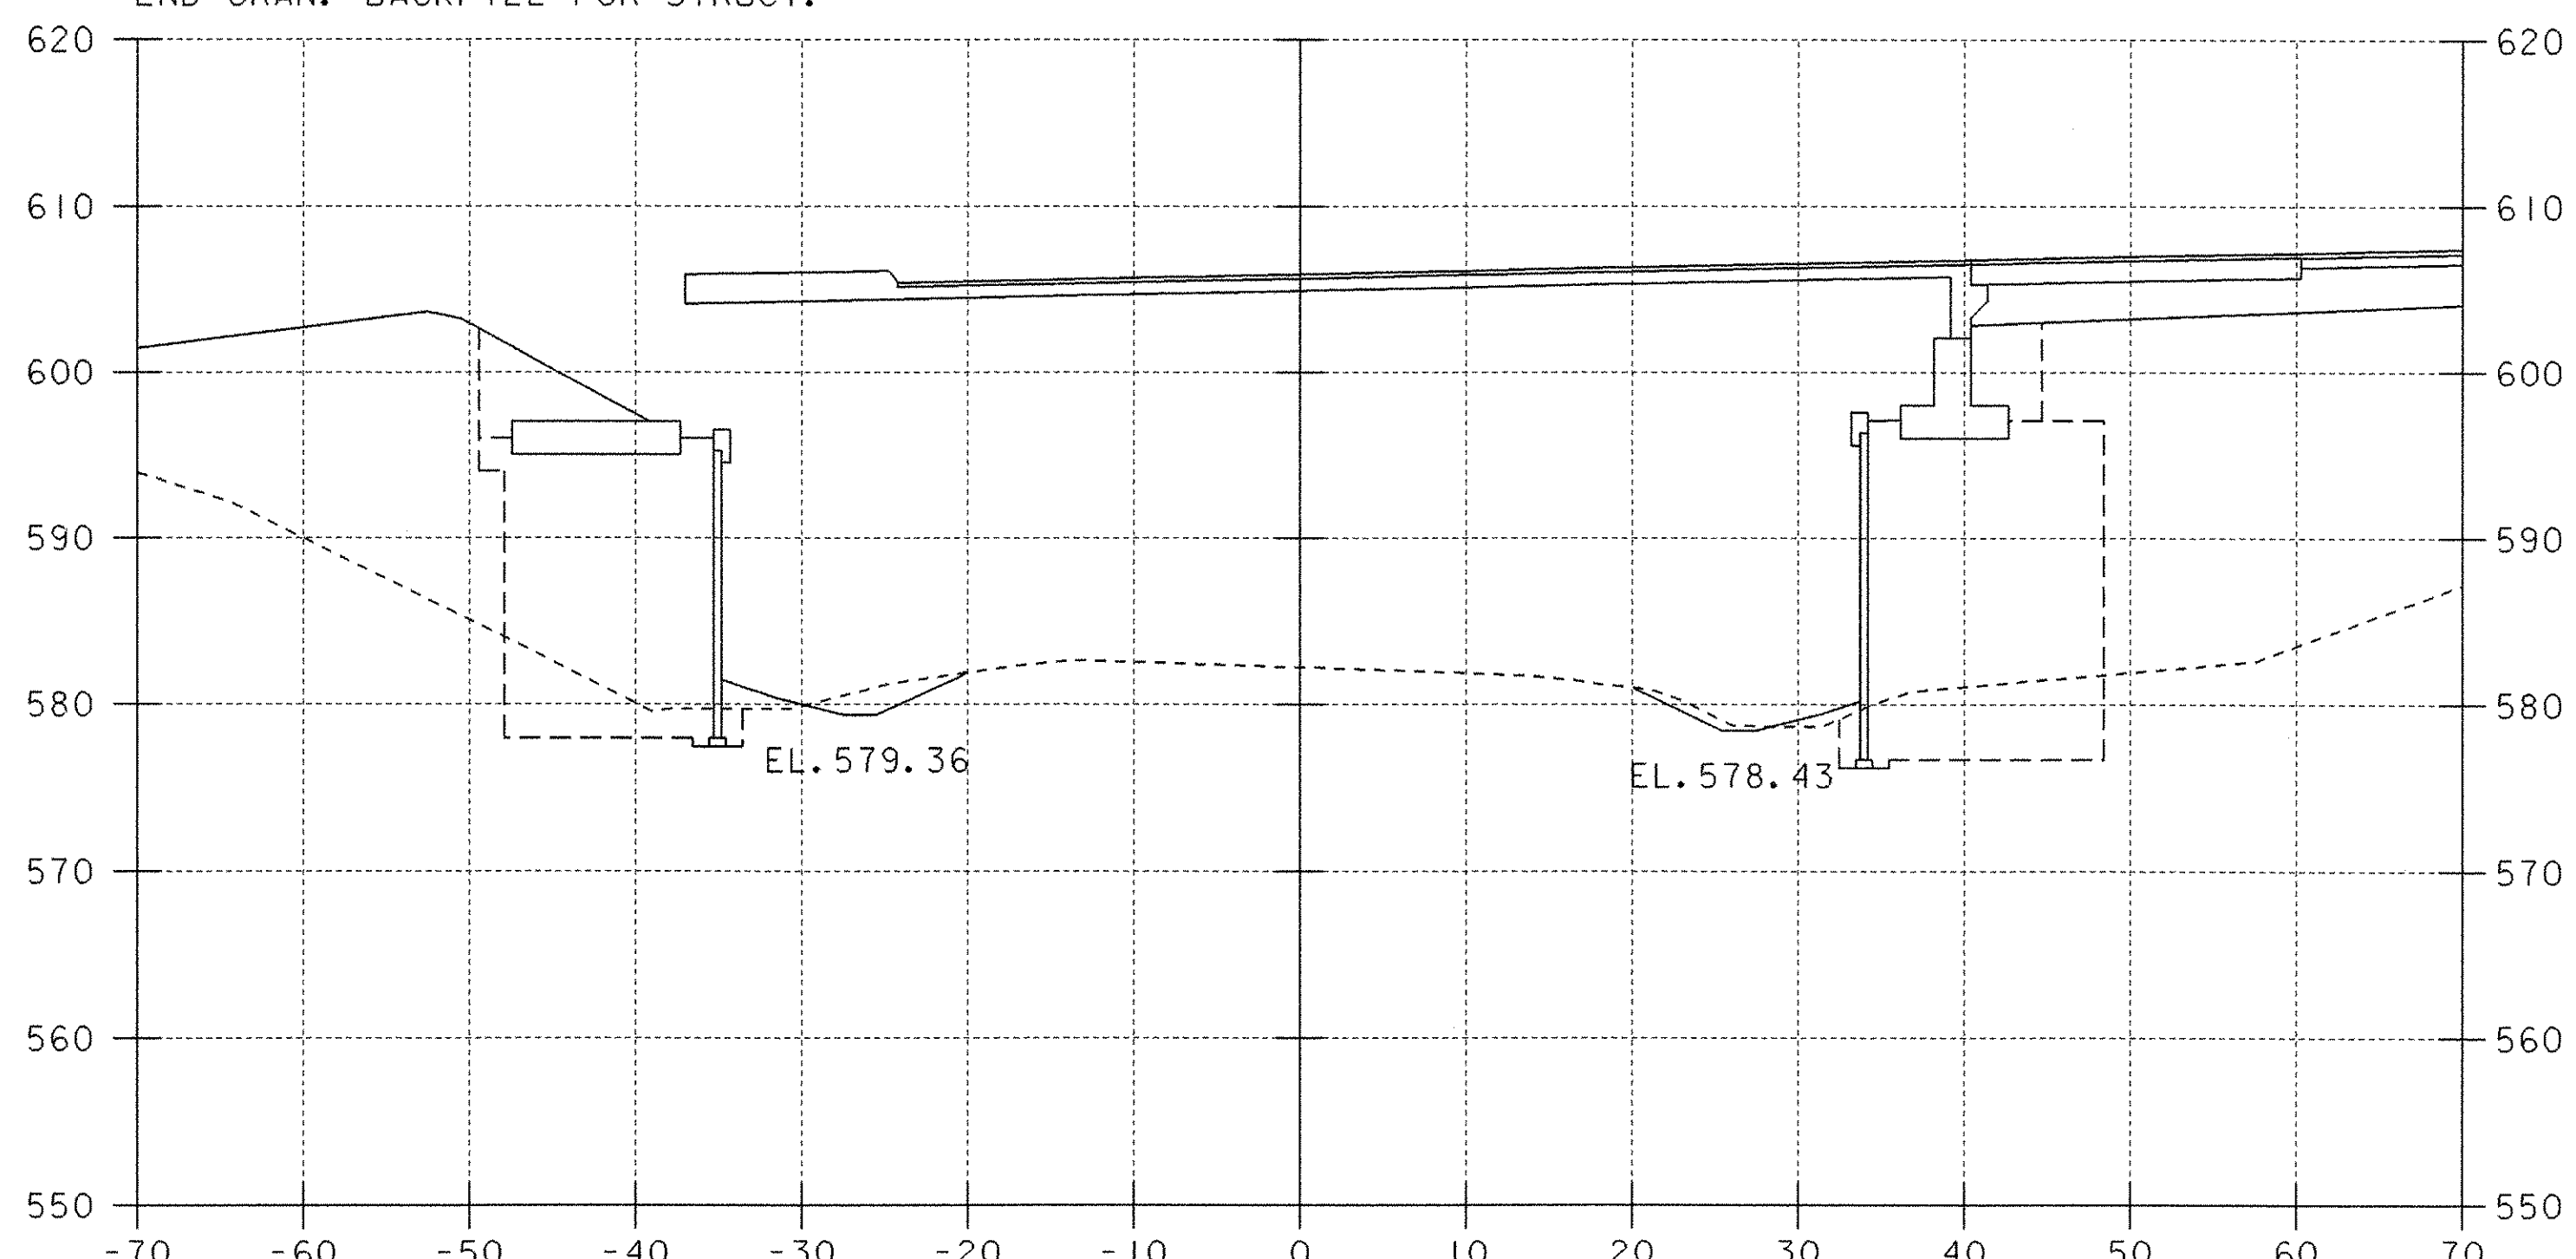

VT 104 STA. 12+04 LT.
 END GRAN. BACKFILL FOR STRUCT.

12+00

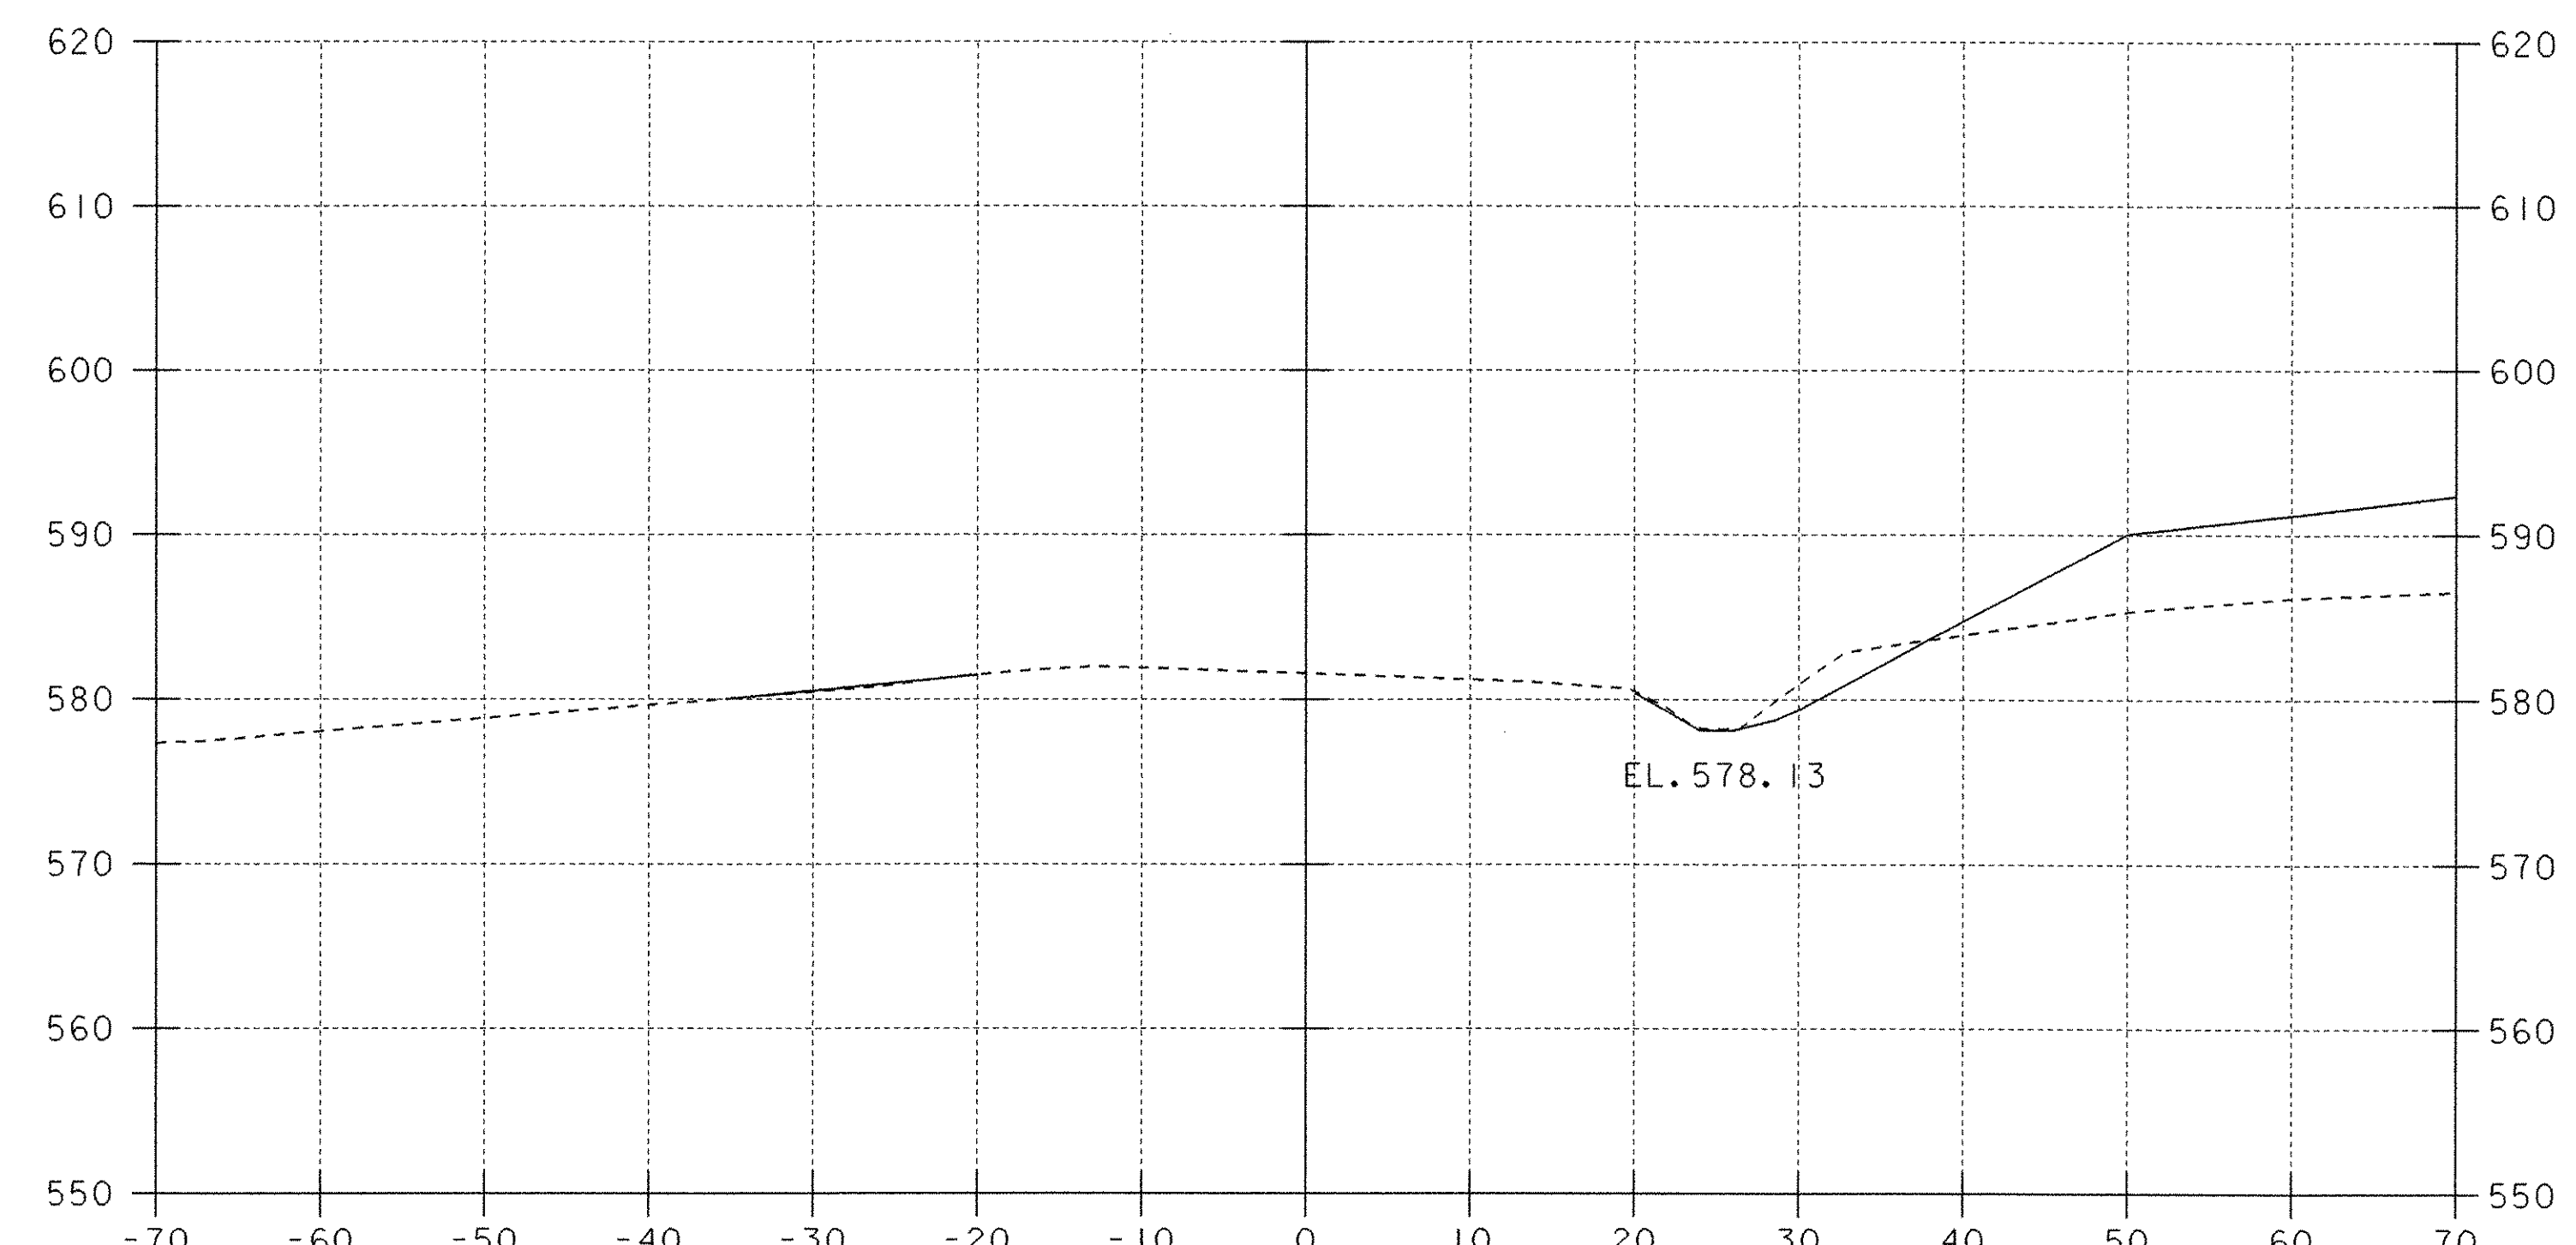

VT 104 STA. 12+50 RT.
 END STRUCTURE EXCAVATION
 SELECTED BACKFILL FOR MSE WALL

12+50

DATUM
 VERTICAL _____
 HORIZONTAL _____

SCALE 1" = 10'-0"

PROJECT: FAIRFAX-FAIRFIELD-ST. ALBANS	PROJECT NO.: IM 089-3 (27)
DESIGN FILE NAME: \96a056\Structures\sa056xsl.dgn	PLOT DATE: 2I-SEP-2000
IPARM FILE NAME: sa056c03.i	BRIDGE SHEET BR238
VT 104 CROSS SECTIONS STA. 12+00 TO STA. 12+75	SHEET: 116 OF 370