



A-A

MATCHLINE

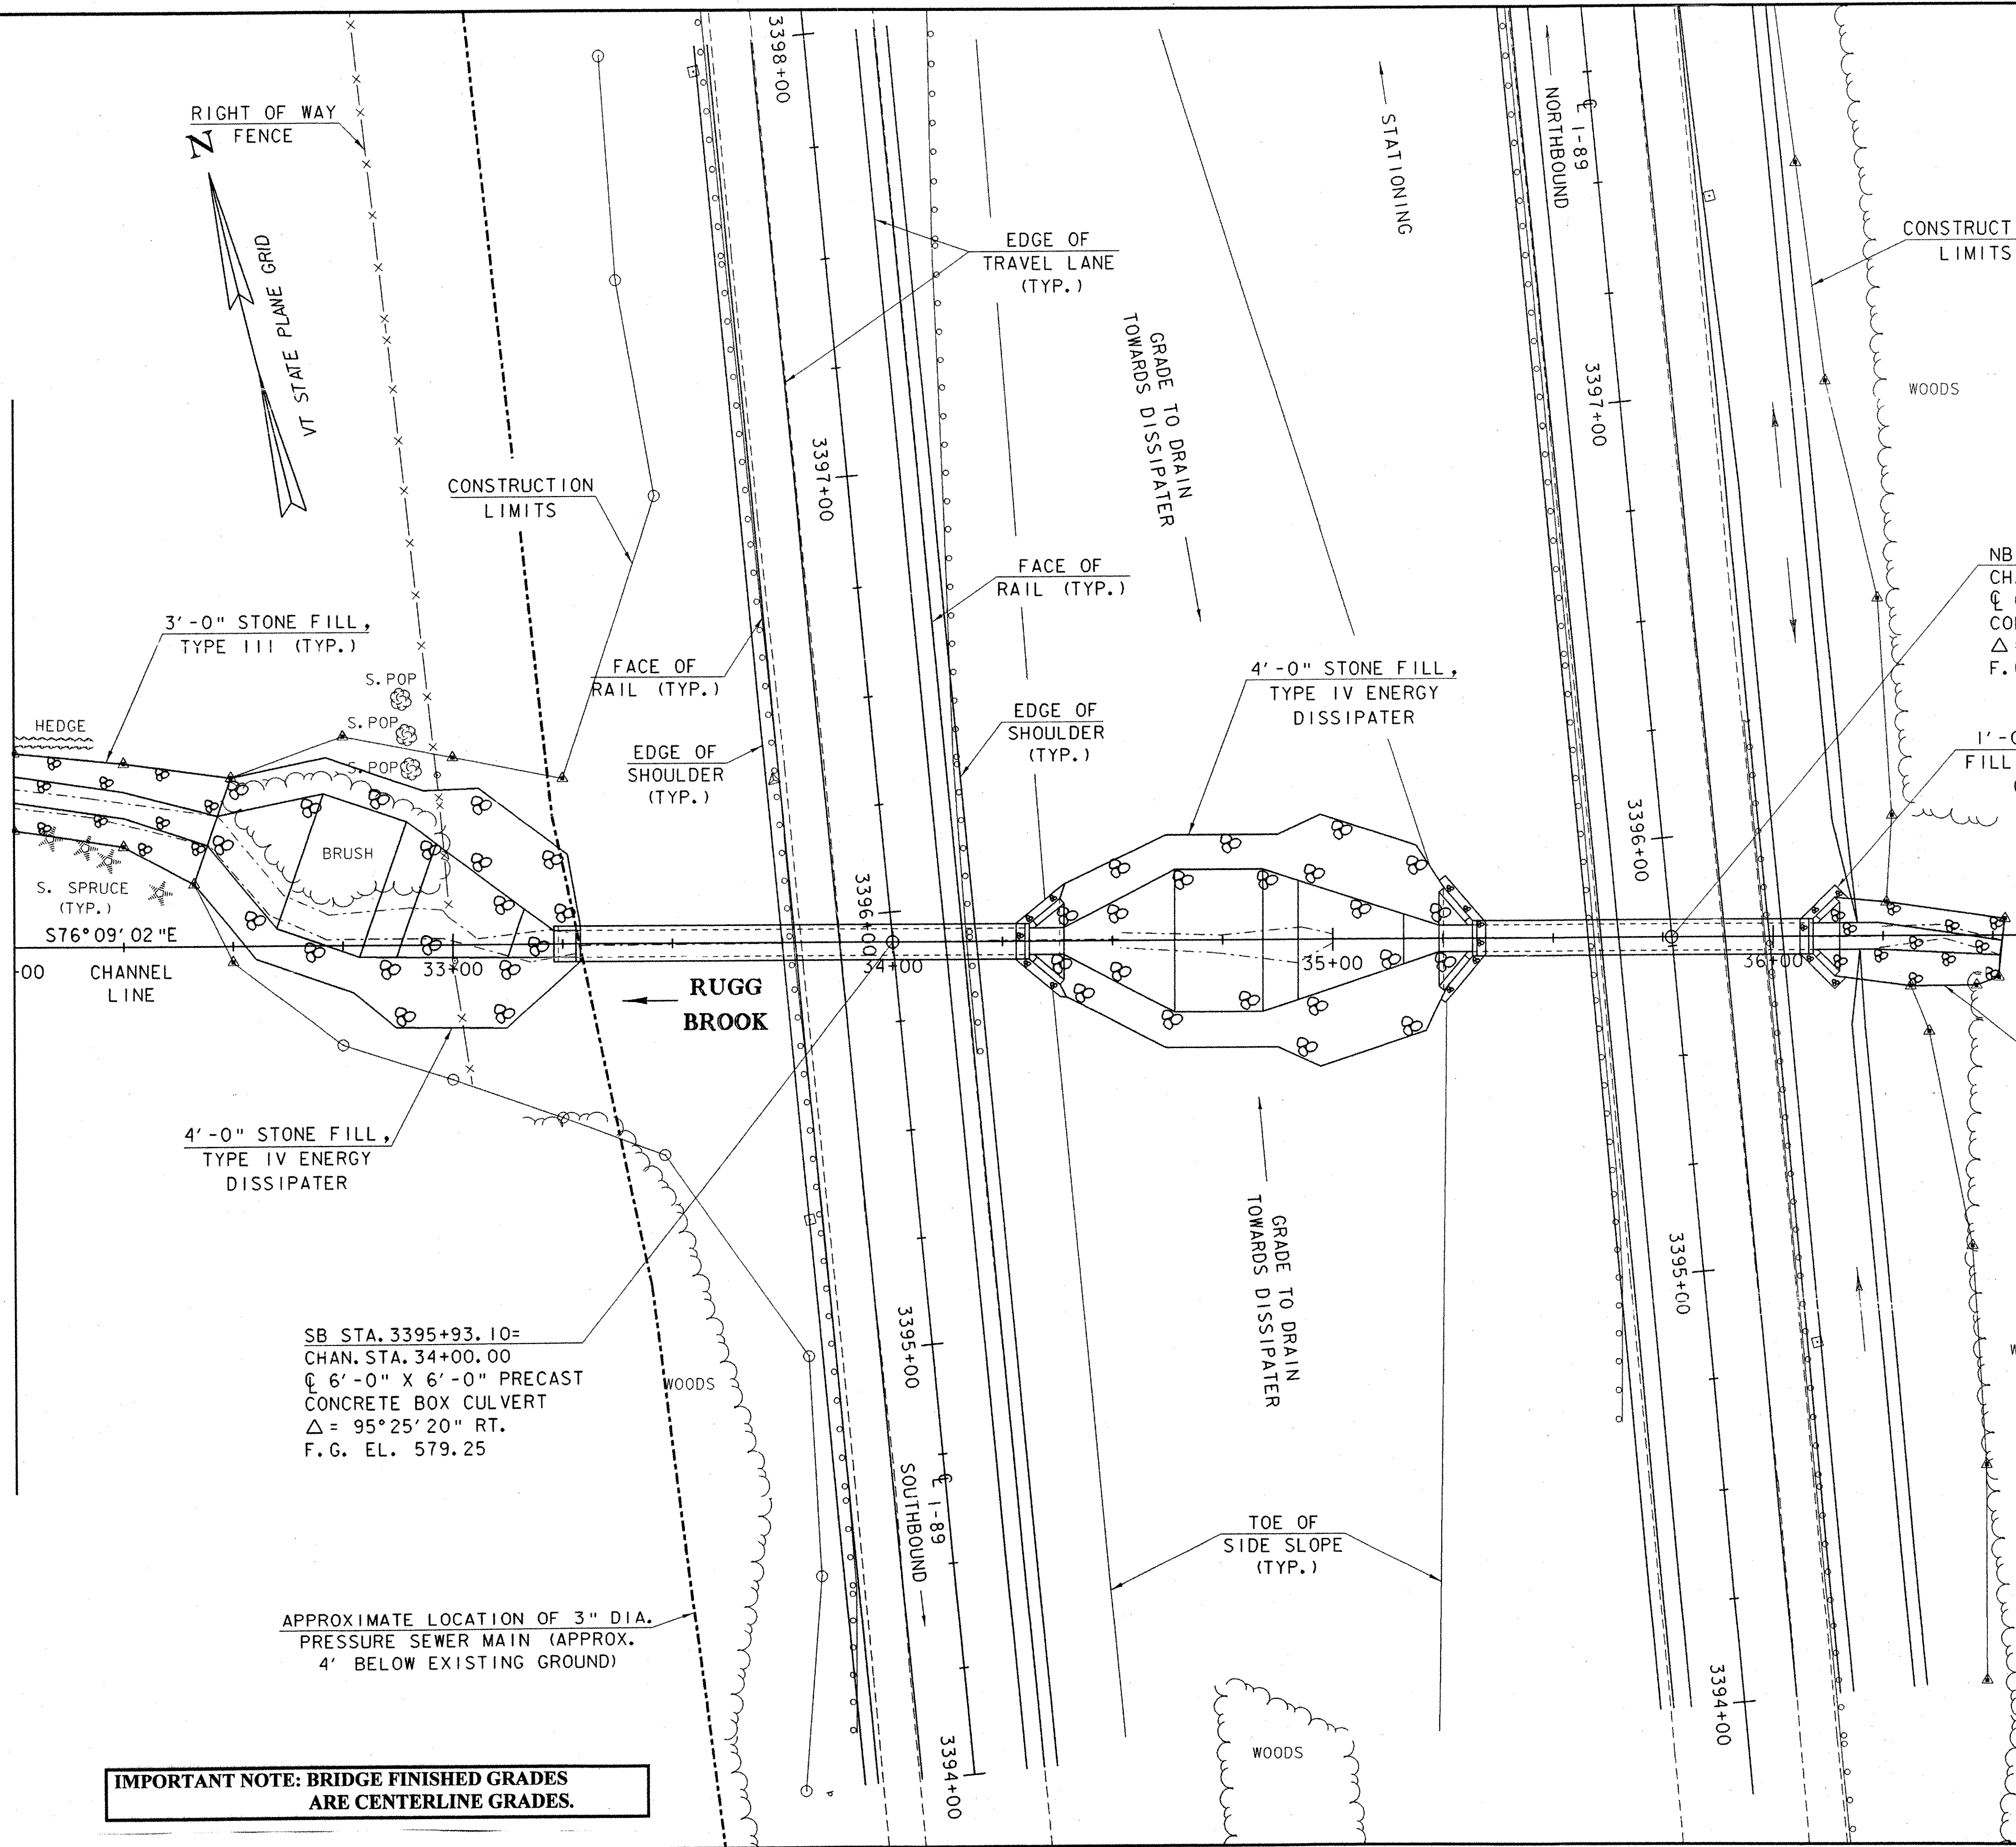

EXISTING STRUCTURE DATA
 NB: 60" DIA. X 120' ACCGMP
 SB: 60" DIA. X 120' ACCGMP

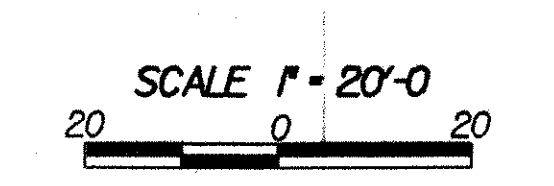

STATE OF VERMONT AGENCY OF TRANSPORTATION			
Town Of FAIRFAX-FAIRFIELD-ST. ALBANS		Bridge No. 87-3 N & S	
Highway No. 1-89		Log Sta.	
		Surv. Sta.	
1-89 OVER THE RUGG BROOK			
87-3 N & S PLAN			
Designed By G. ROY		Drawn By G. ROY	
Checked By Date		Bridge Design Supervisor	
M. LOZIER 6/00		R.R. WHITCOMB Date 6/00	
PROJECT FAIRFAX-FAIRFIELD-ST. ALBANS		PROJECT NO. 1 M 089 - 3 (27)	
I.G.C. Info. 96a056Structures\sa056bdr.dgn		sa0561021	
Bridge Sheet No. BR307		Sheet 133 of 370	

IMPORTANT NOTE: BRIDGE FINISHED GRADES ARE CENTERLINE GRADES.