
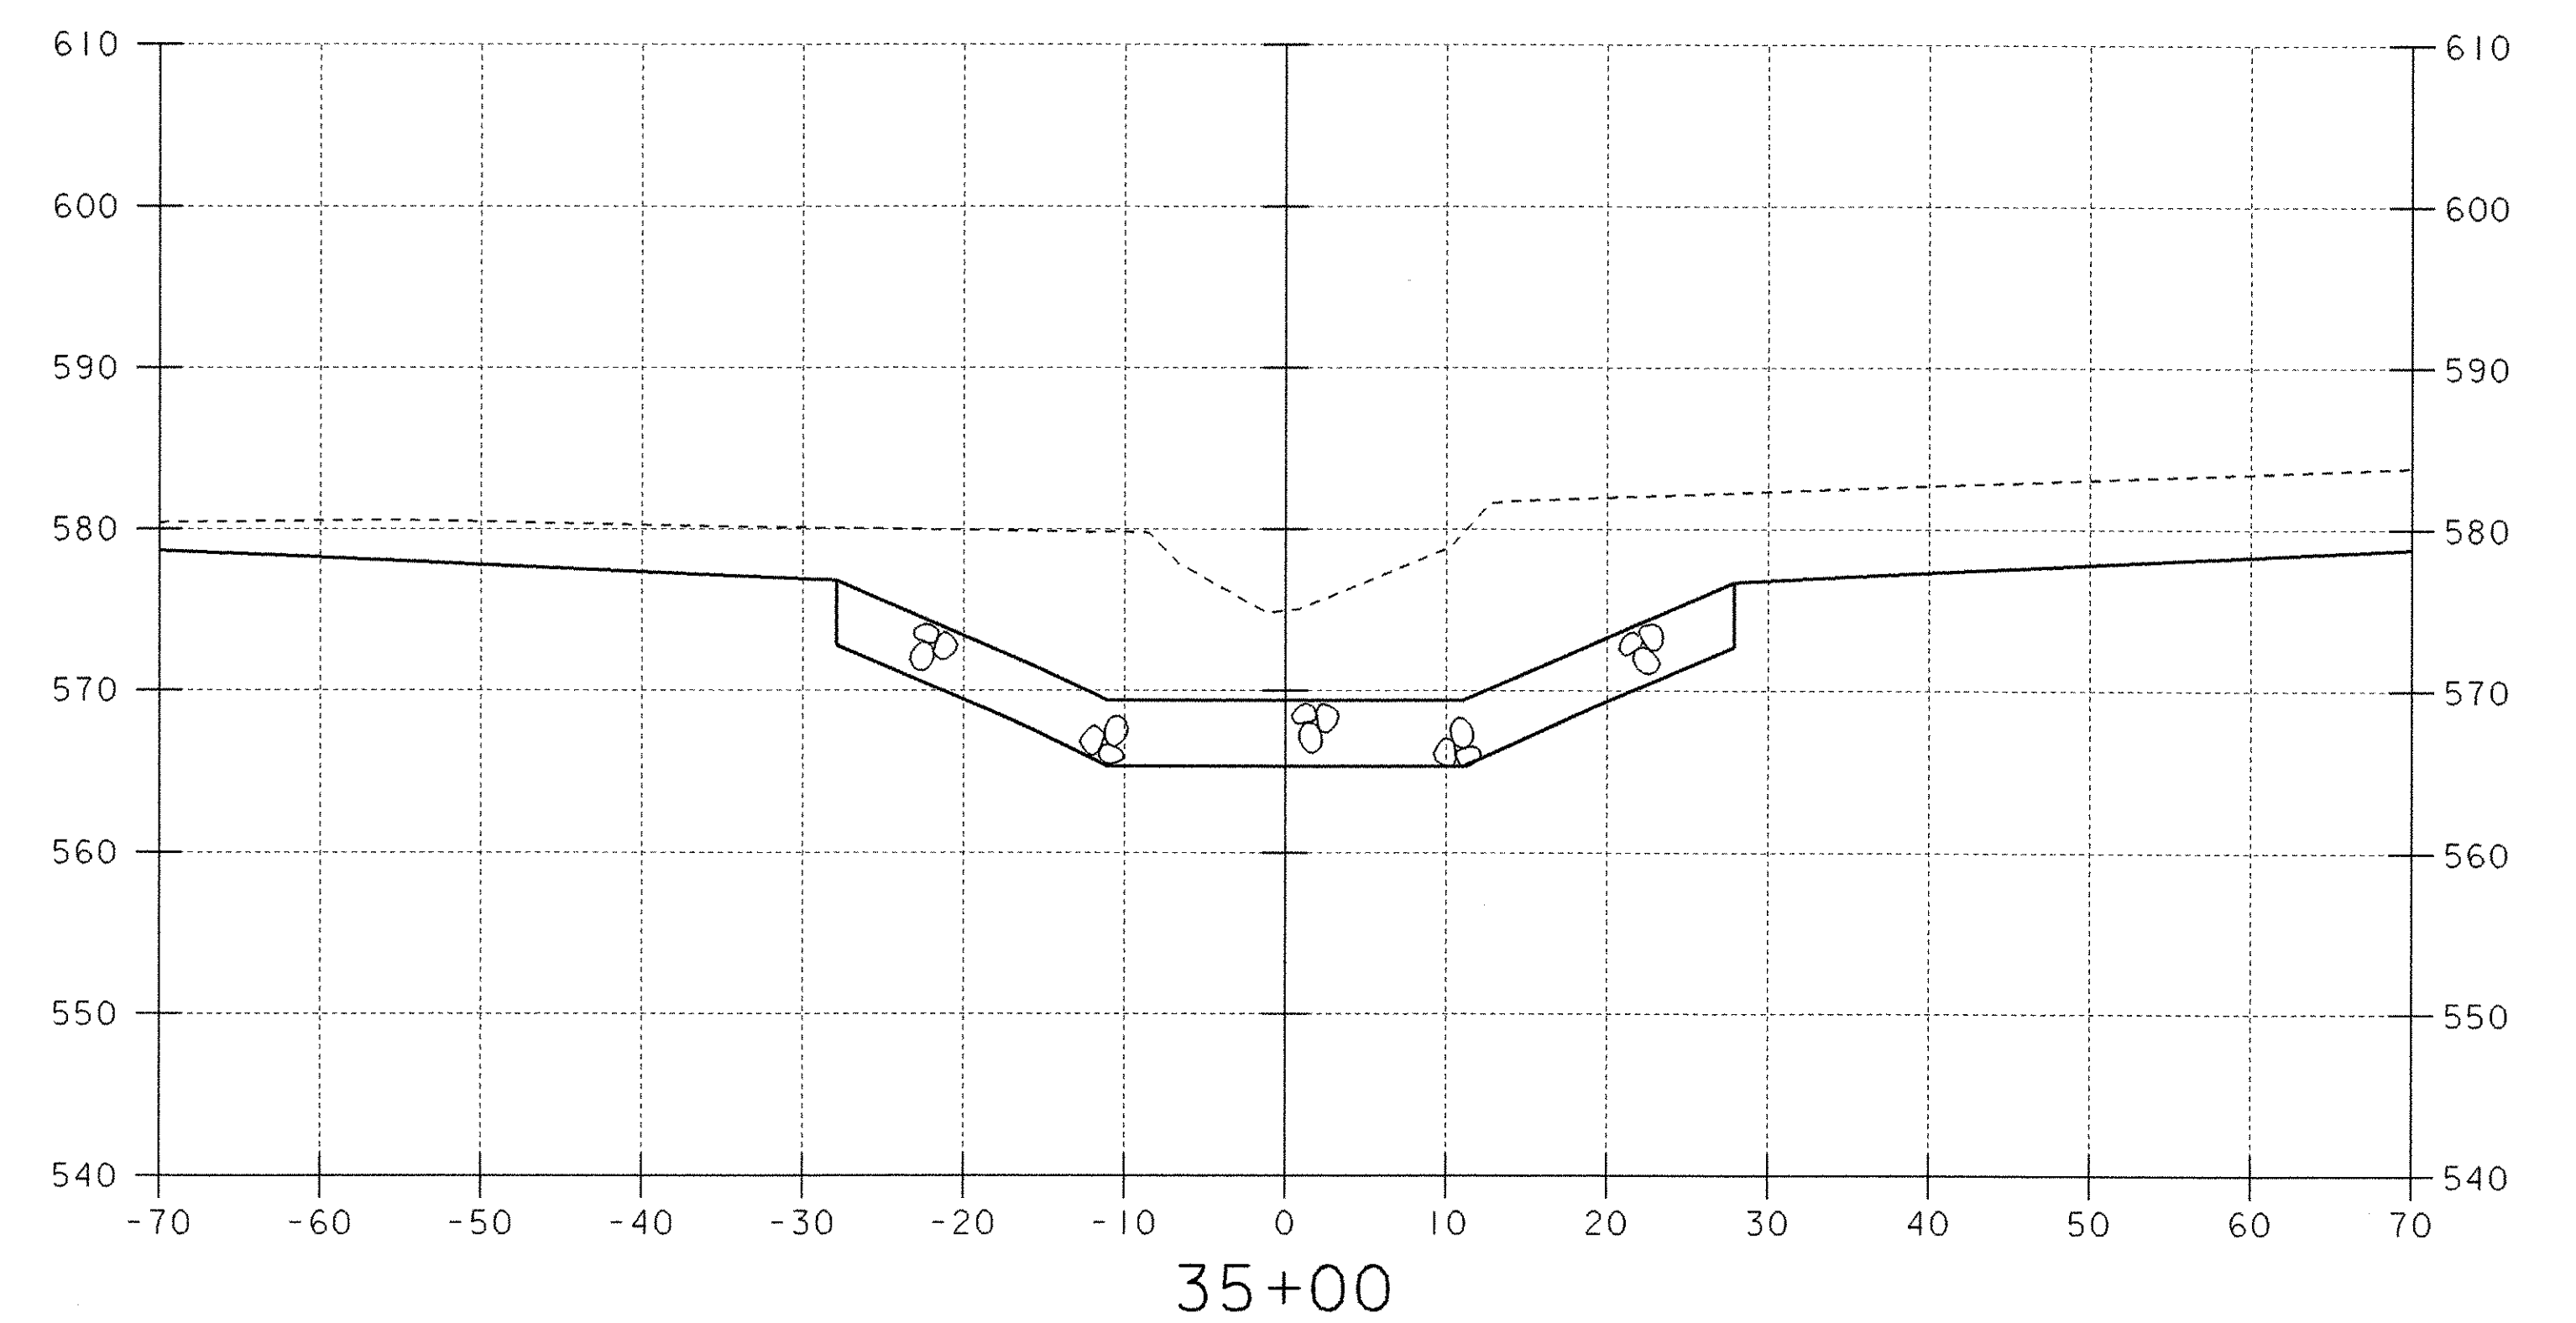
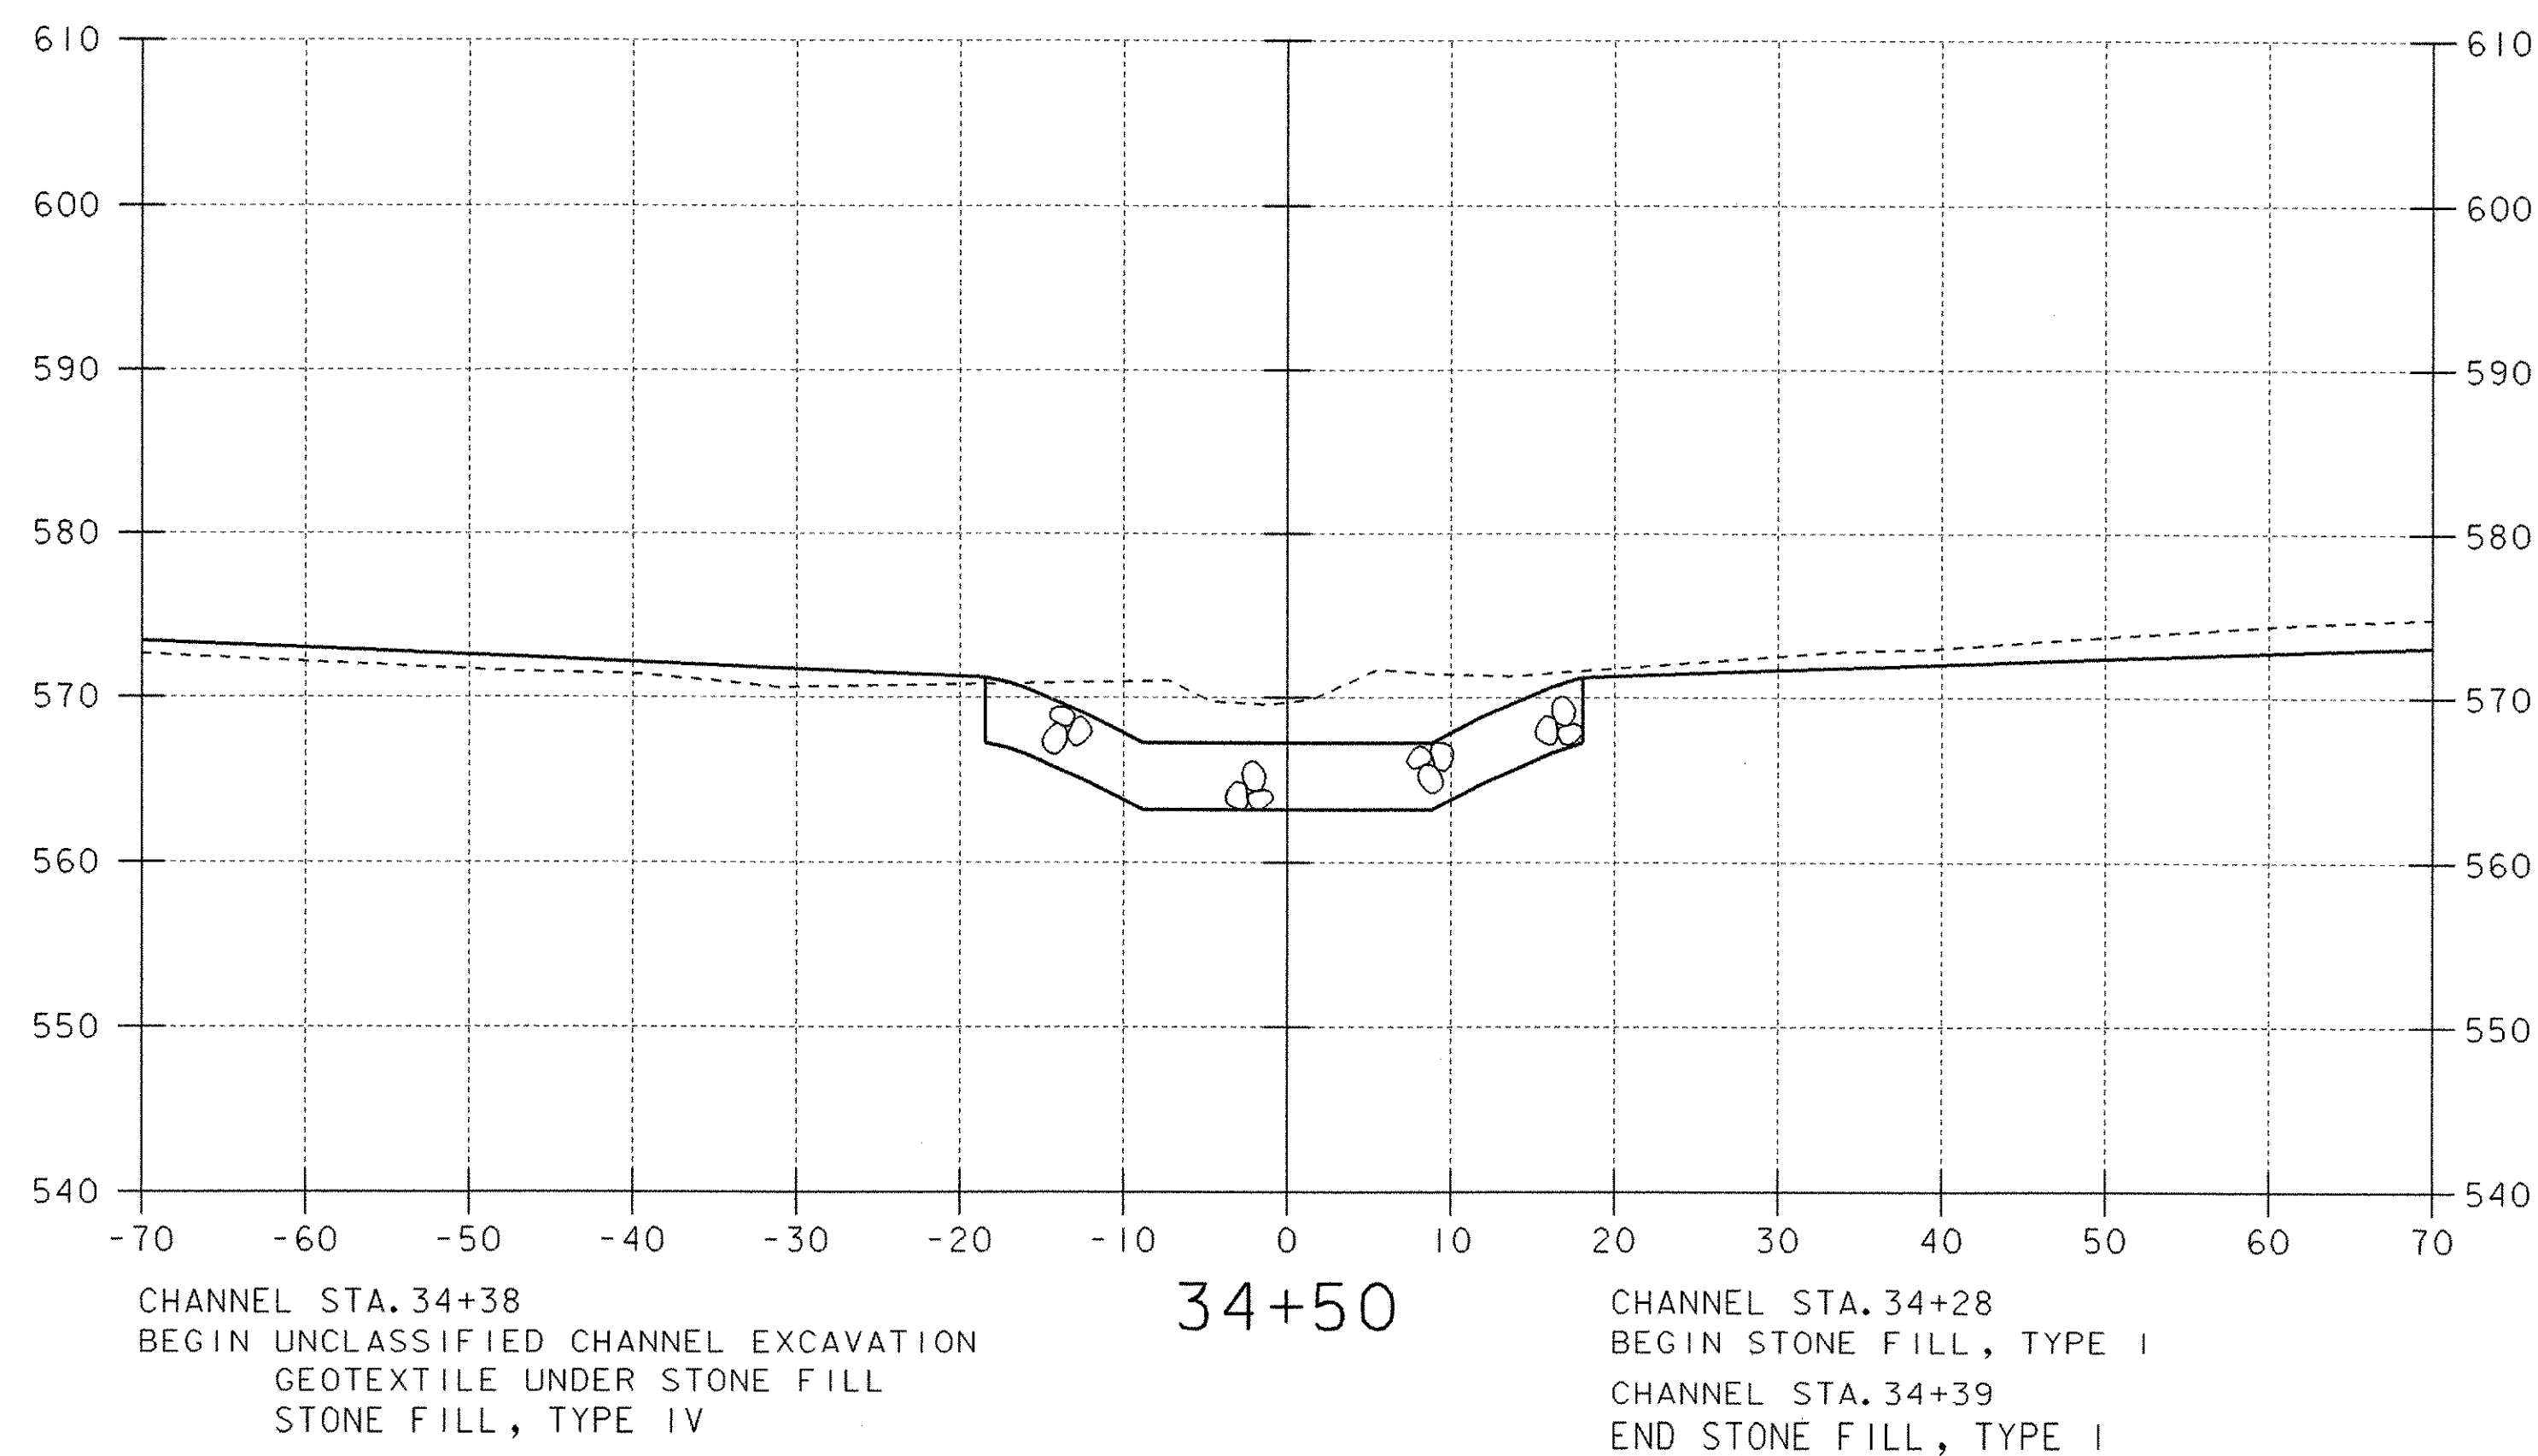
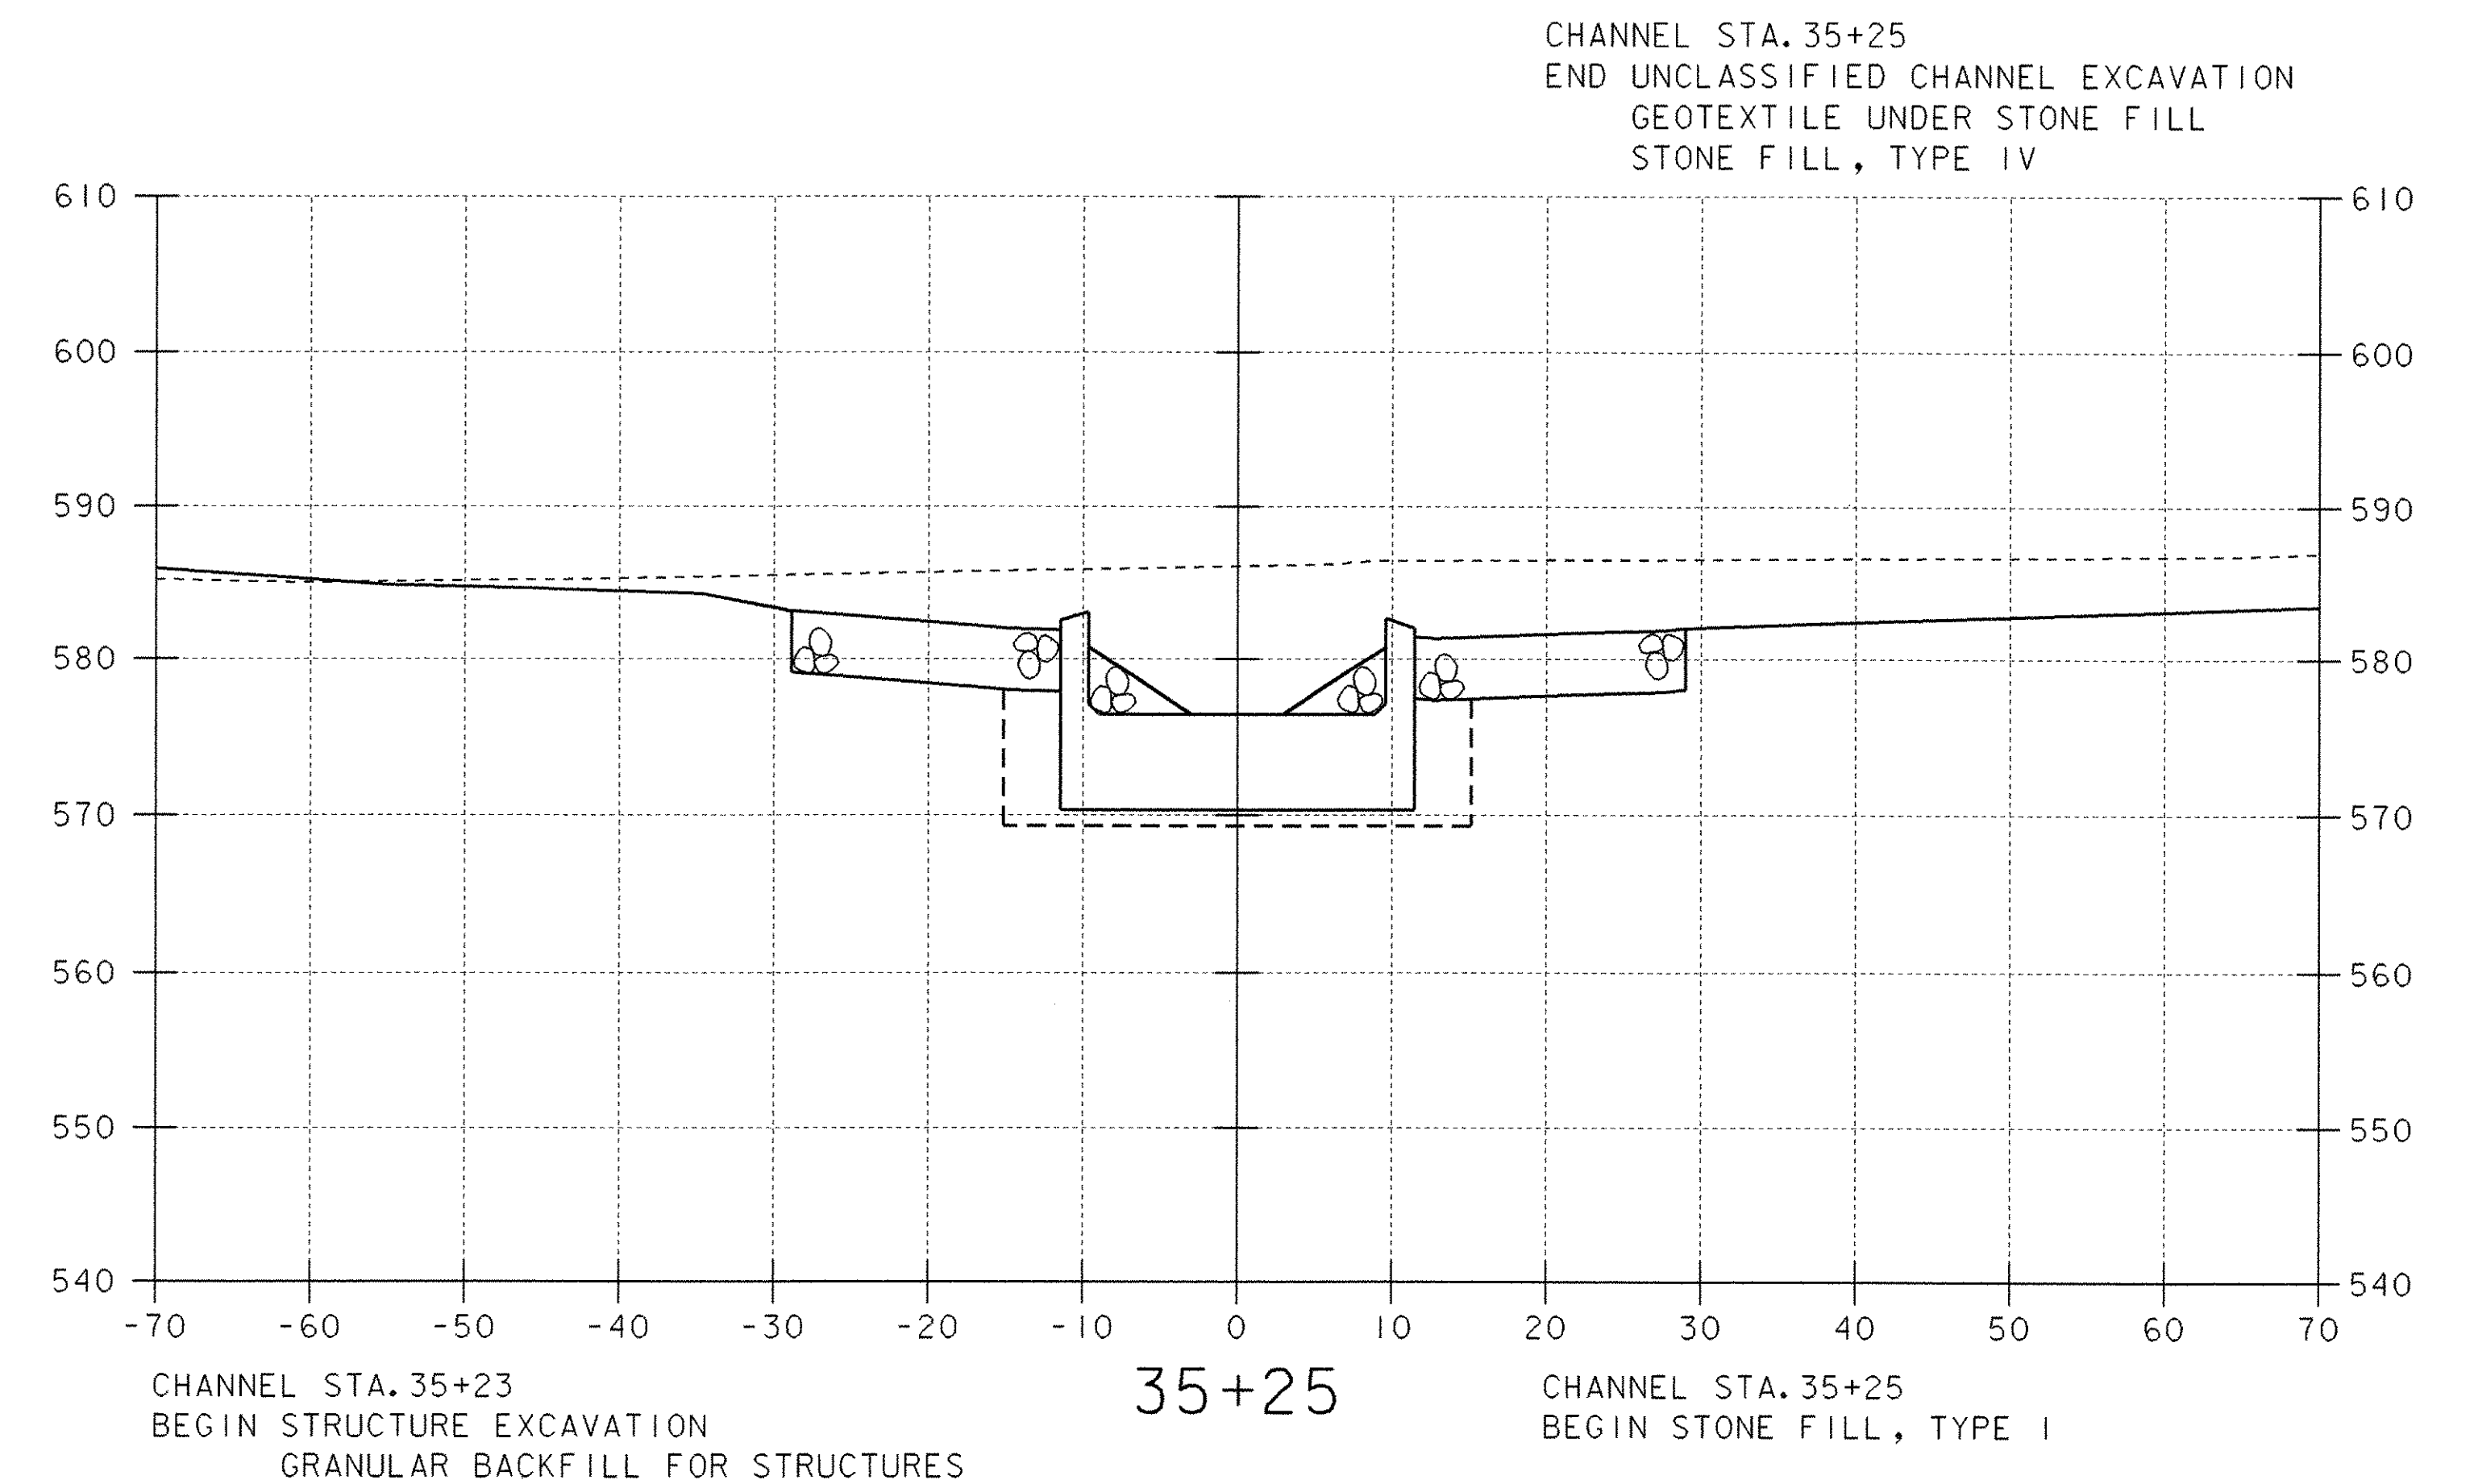


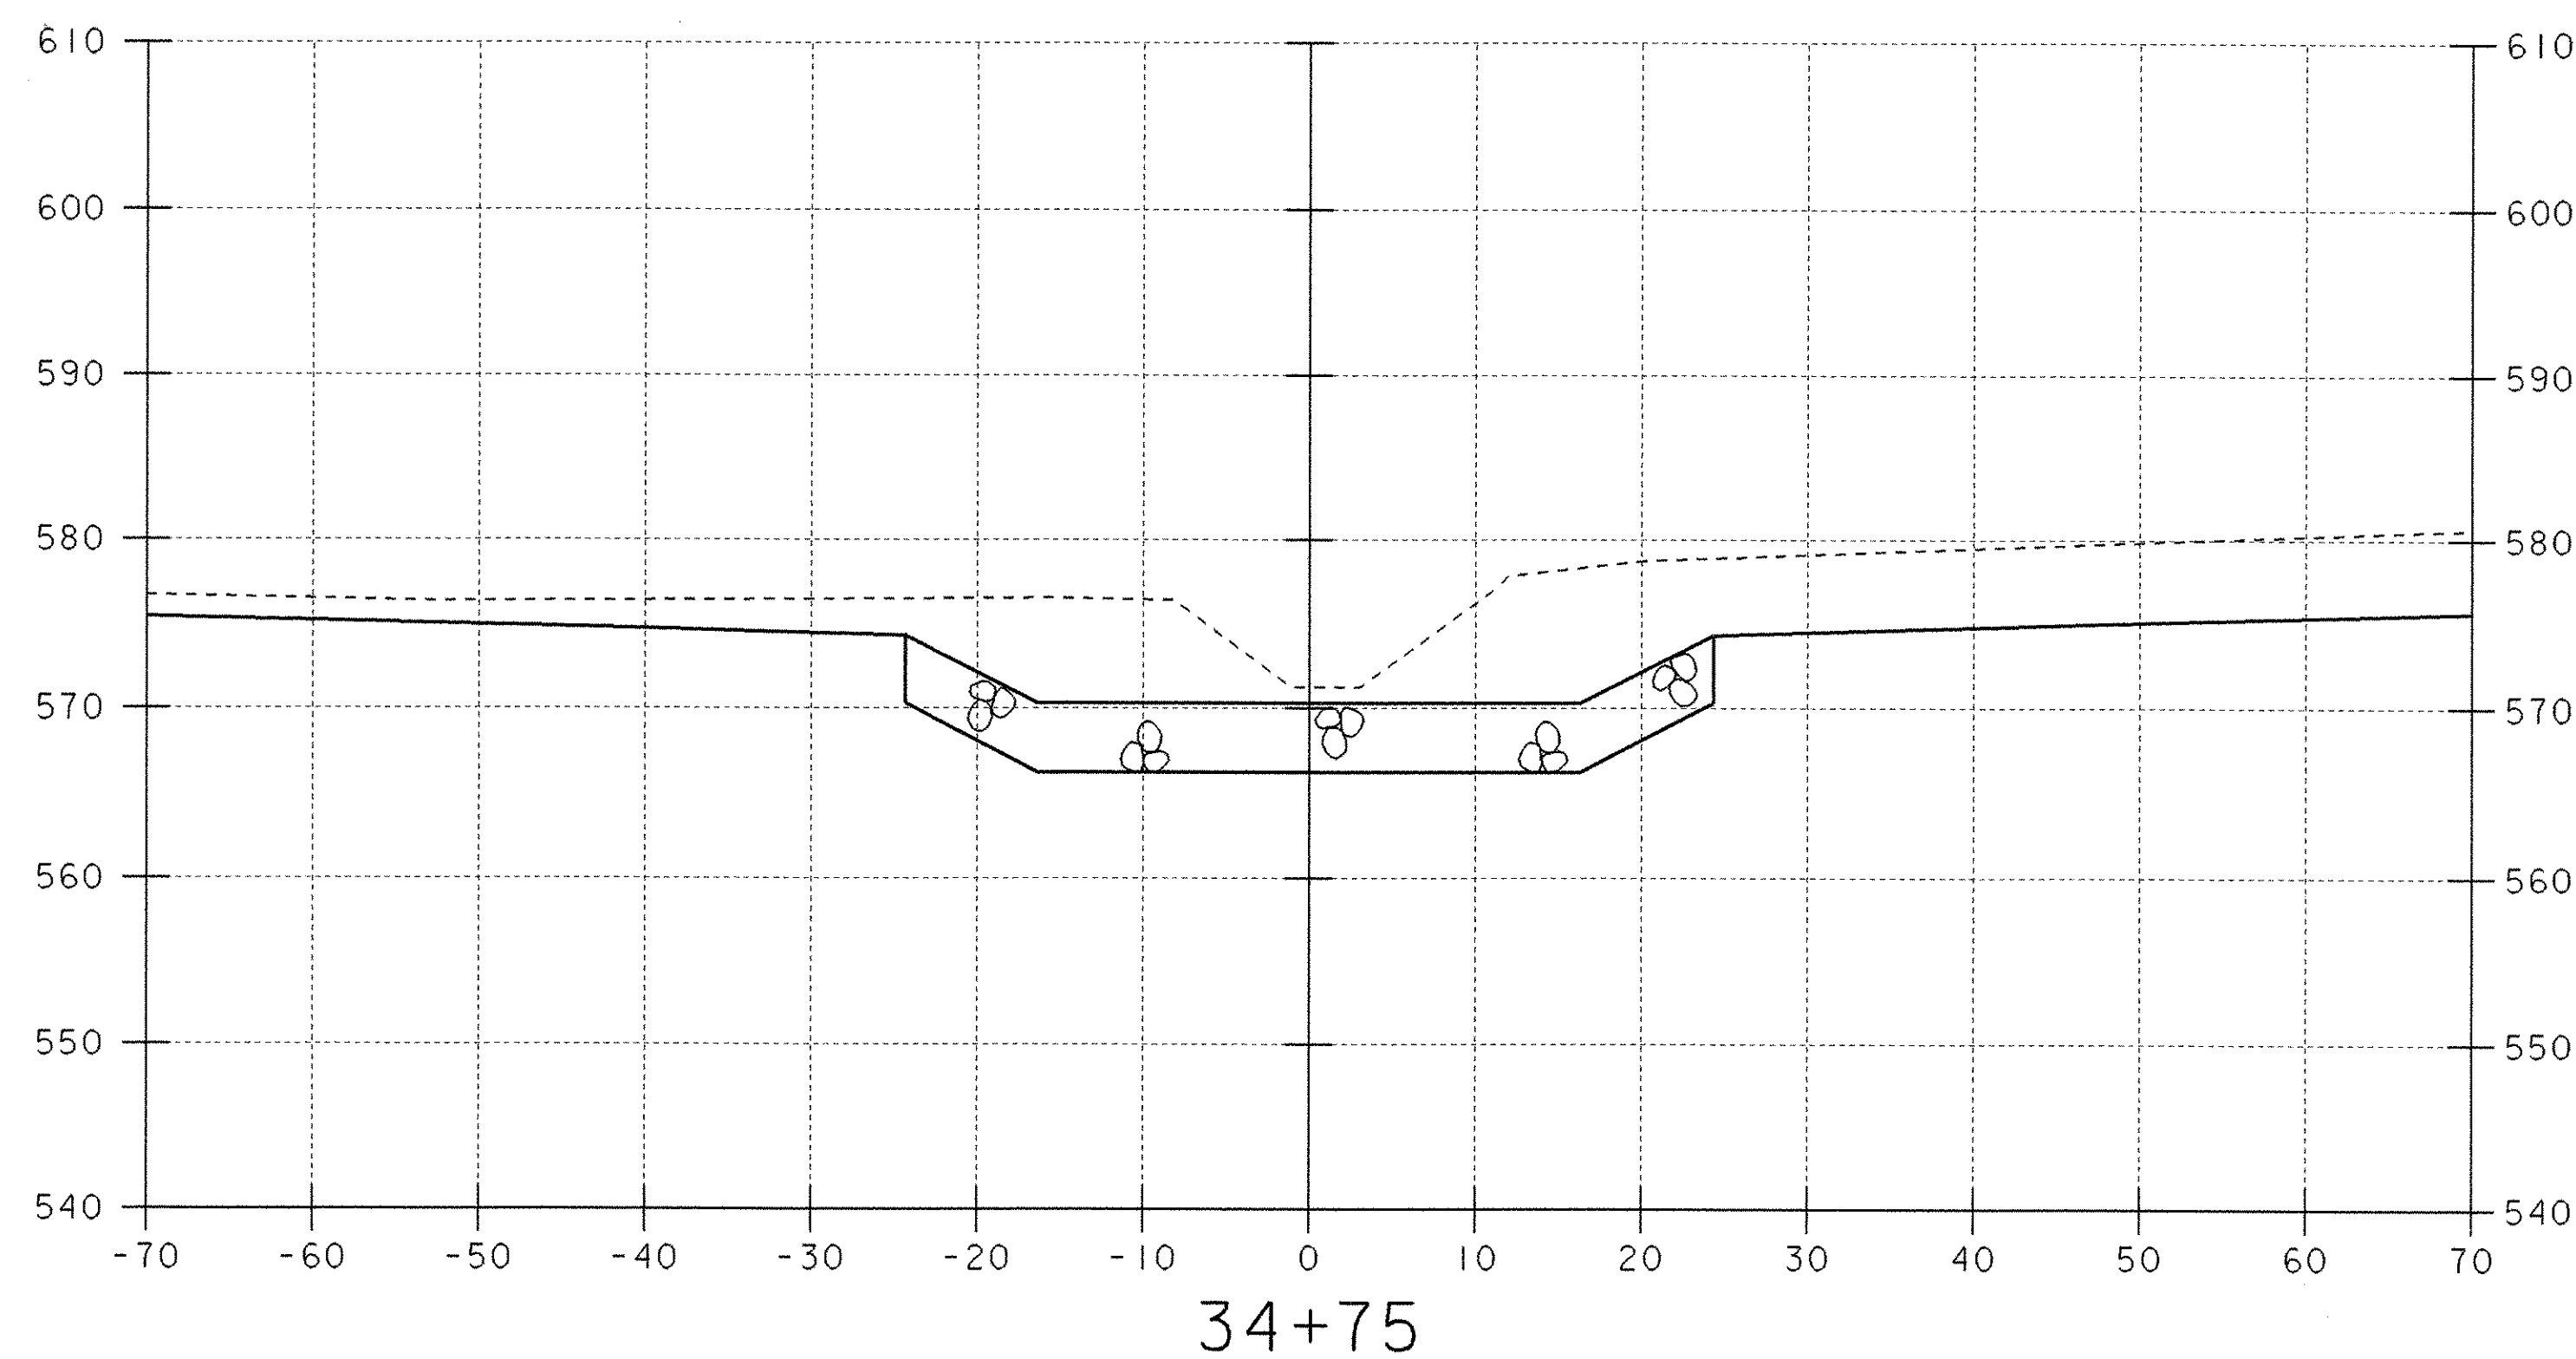

SCALE 1" = 10'-0"
10 0 10

DATUM
VERTICAL _____
HORIZONTAL _____

CHANNEL STA. 34+40
END STRUCTURE EXCAVATION
GRANULAR BACKFILL FOR STRUCTURES

PROJECT: FAIRFAX-FAIRFIELD-ST. ALBANS	PROJECT NO.: IM 089-3 (27)
DESIGN FILE NAME: \96a056\Structures\sa056xs4.dgn	PLOT DATE: 21-SEP-2000
IPARM FILE NAME: sa056c06.i	BRIDGE SHEET BR32I
CHANNEL CROSS SECTIONS (5)	SHEET: 147 OF 370
STA. 34+50 TO STA. 35+25	