

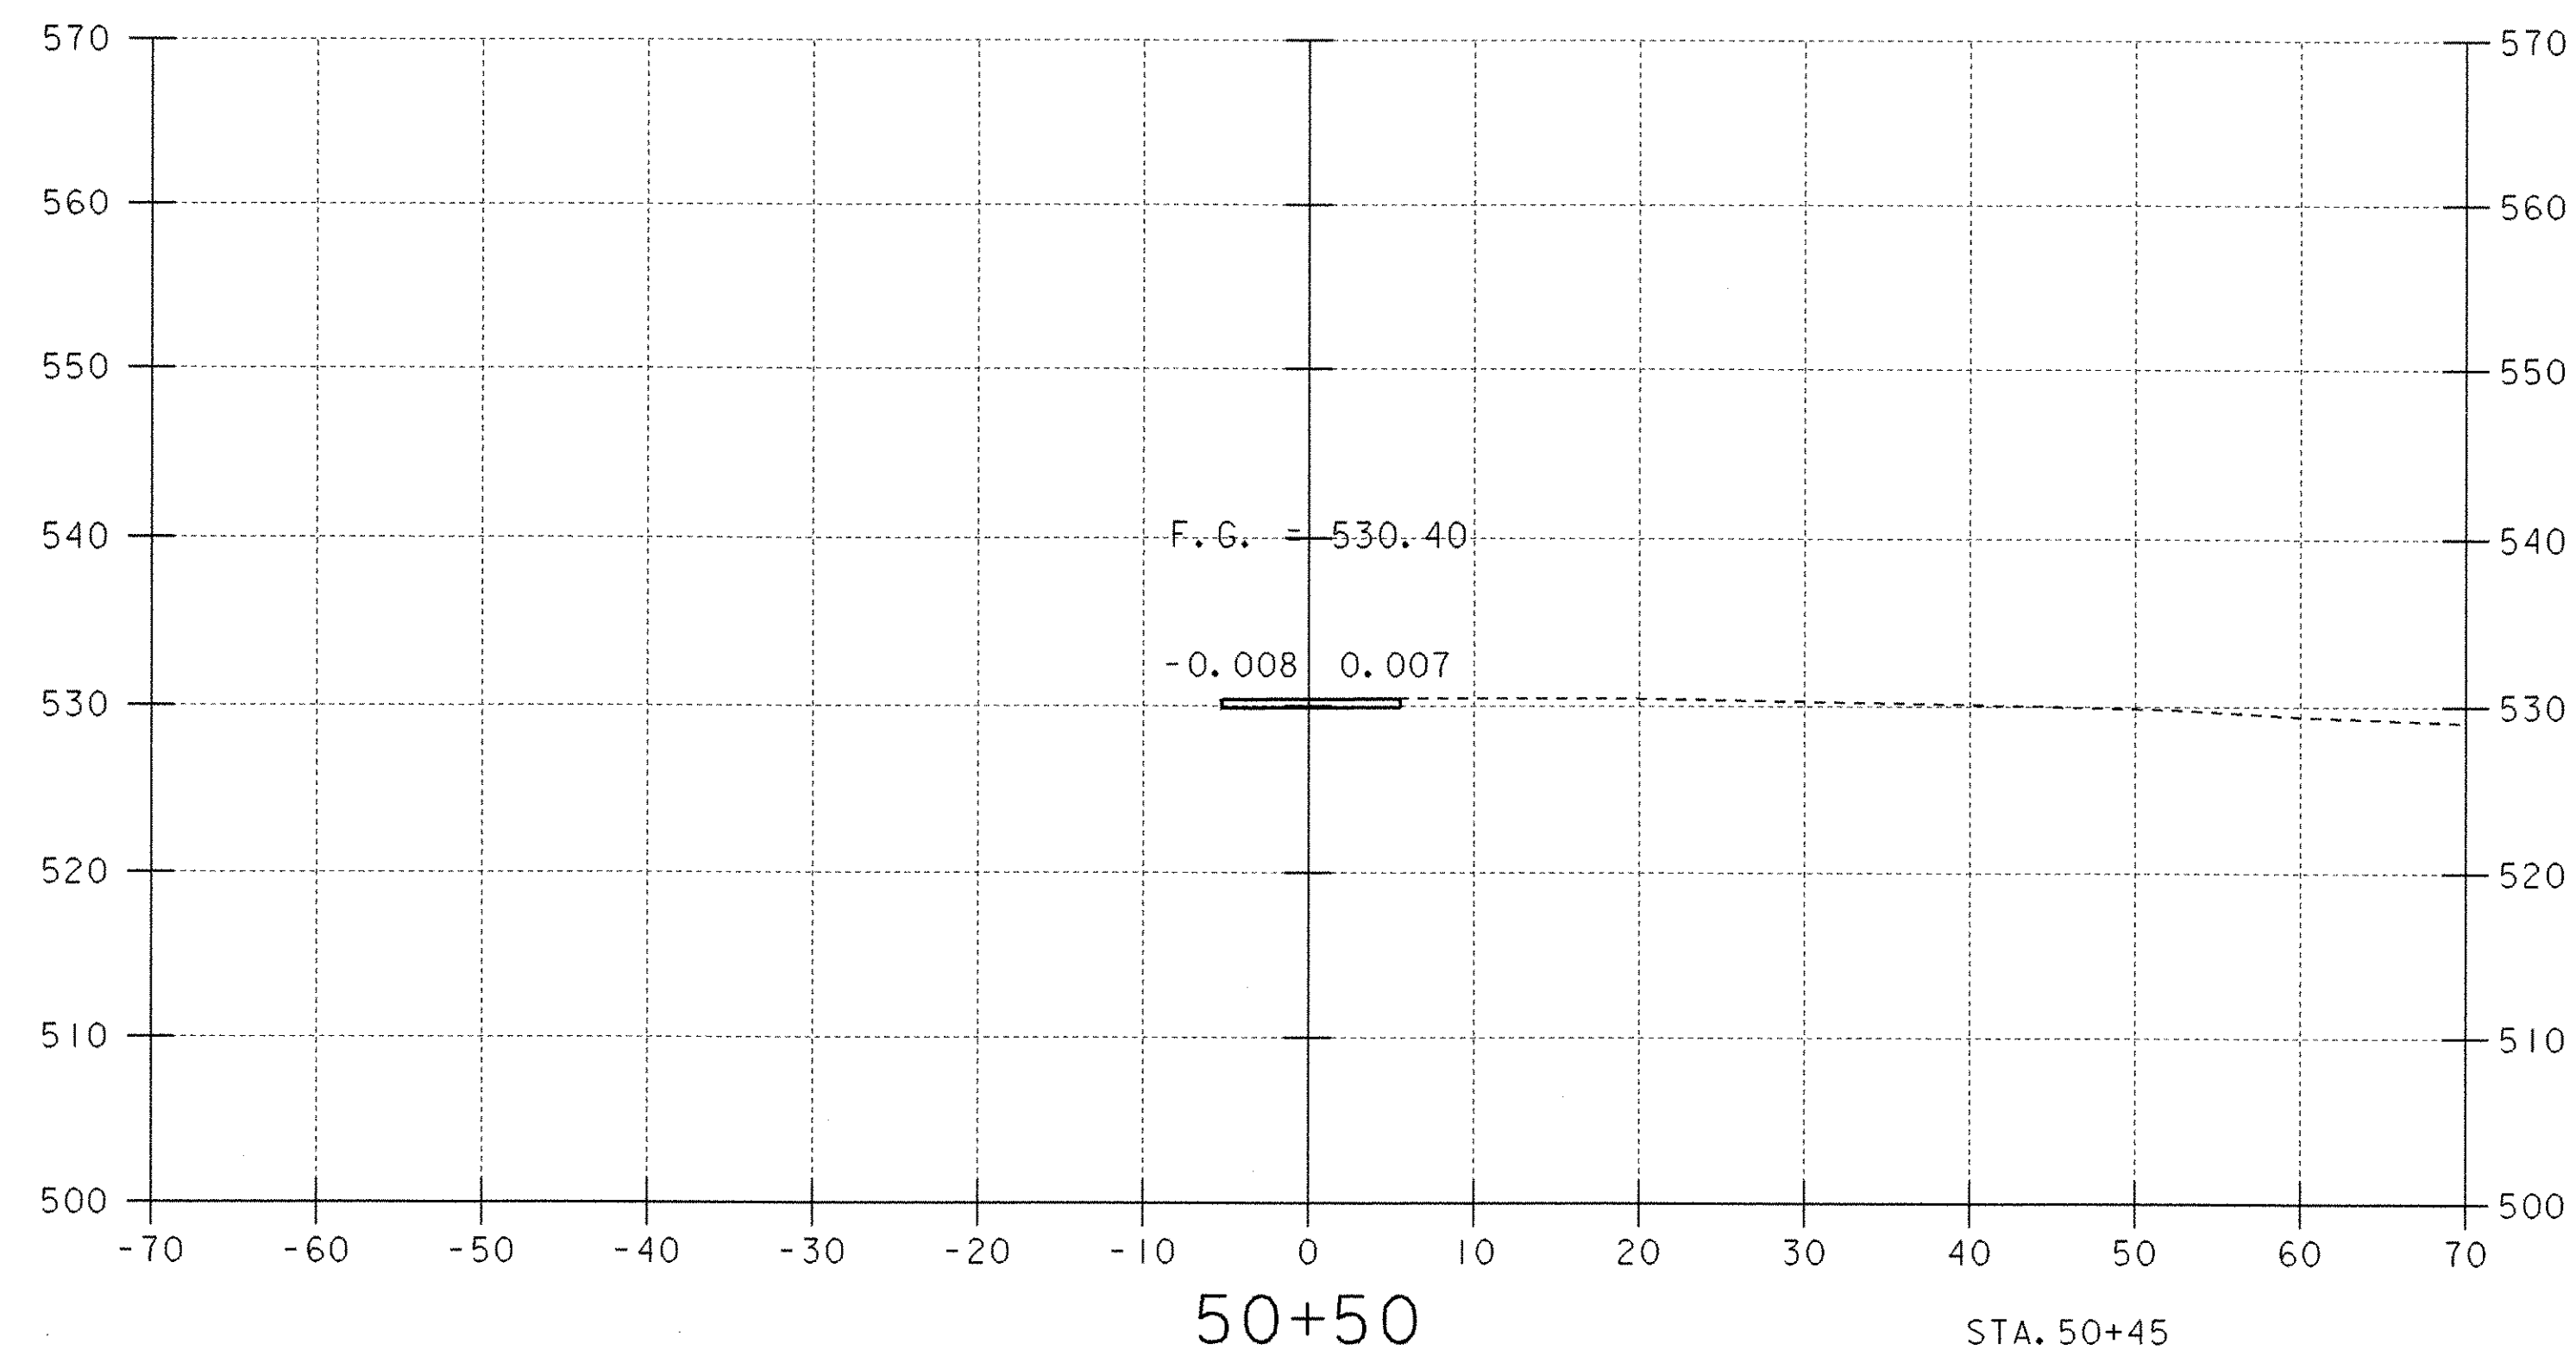
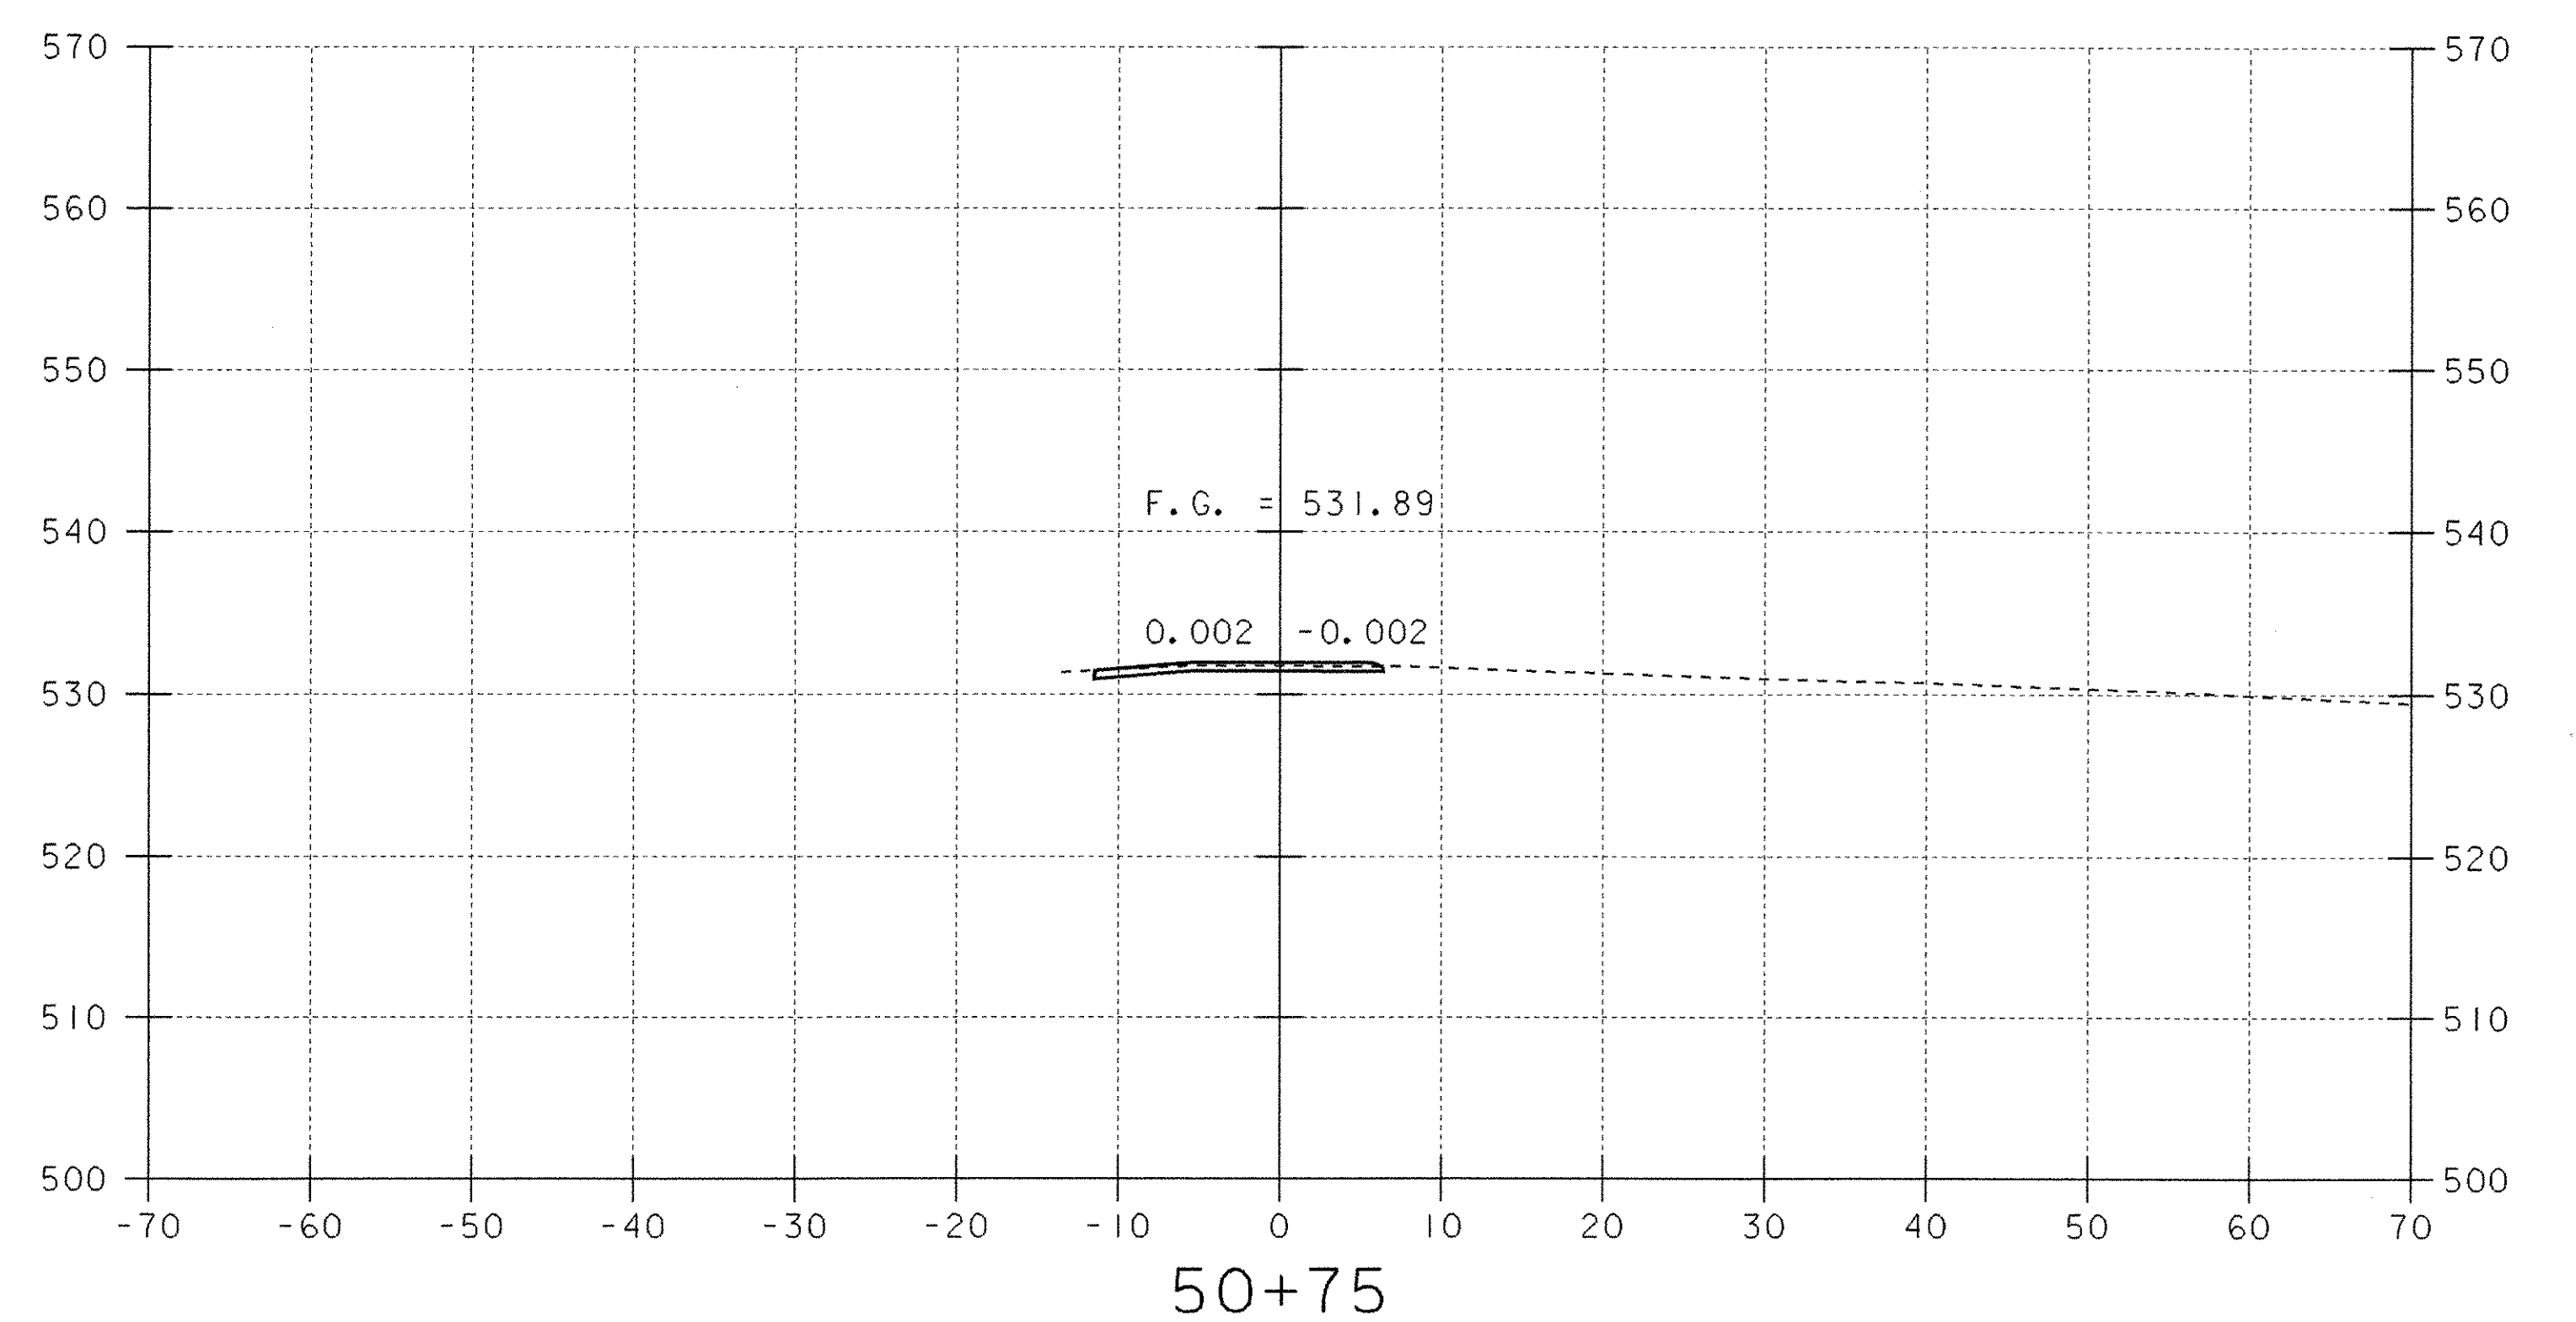


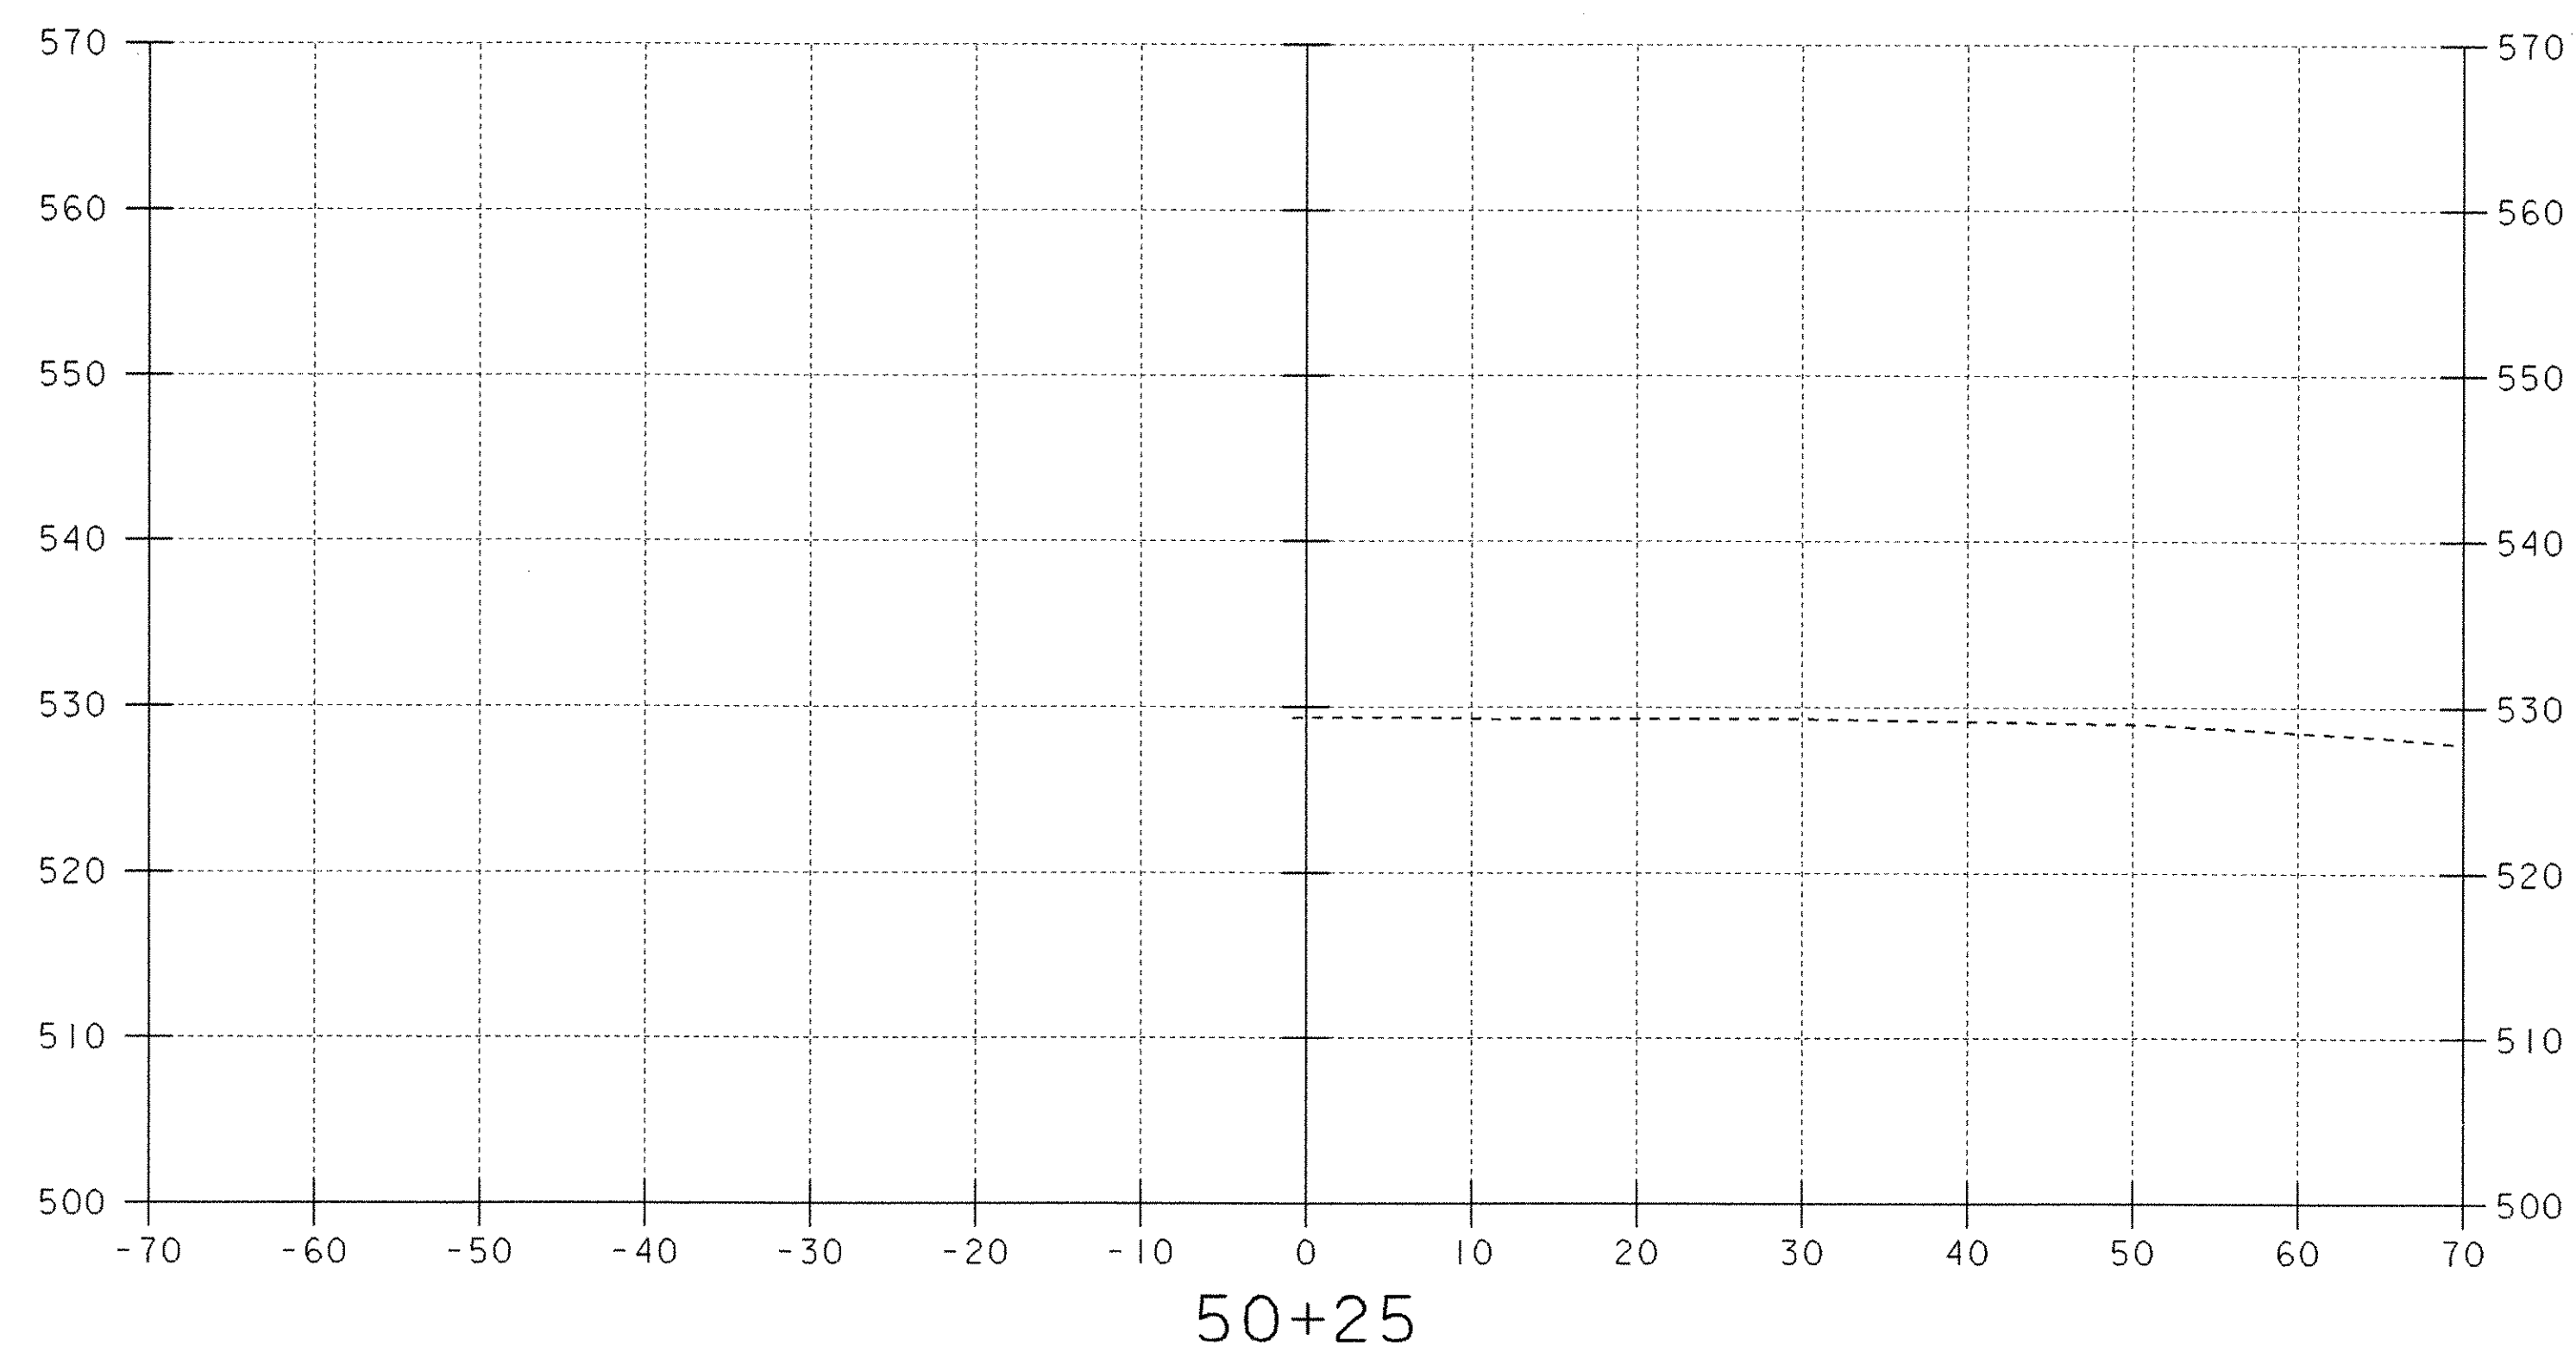

STA. 50+45
BEGIN DRIVE CONSTRUCTION
MATCH EXISTING GRADE

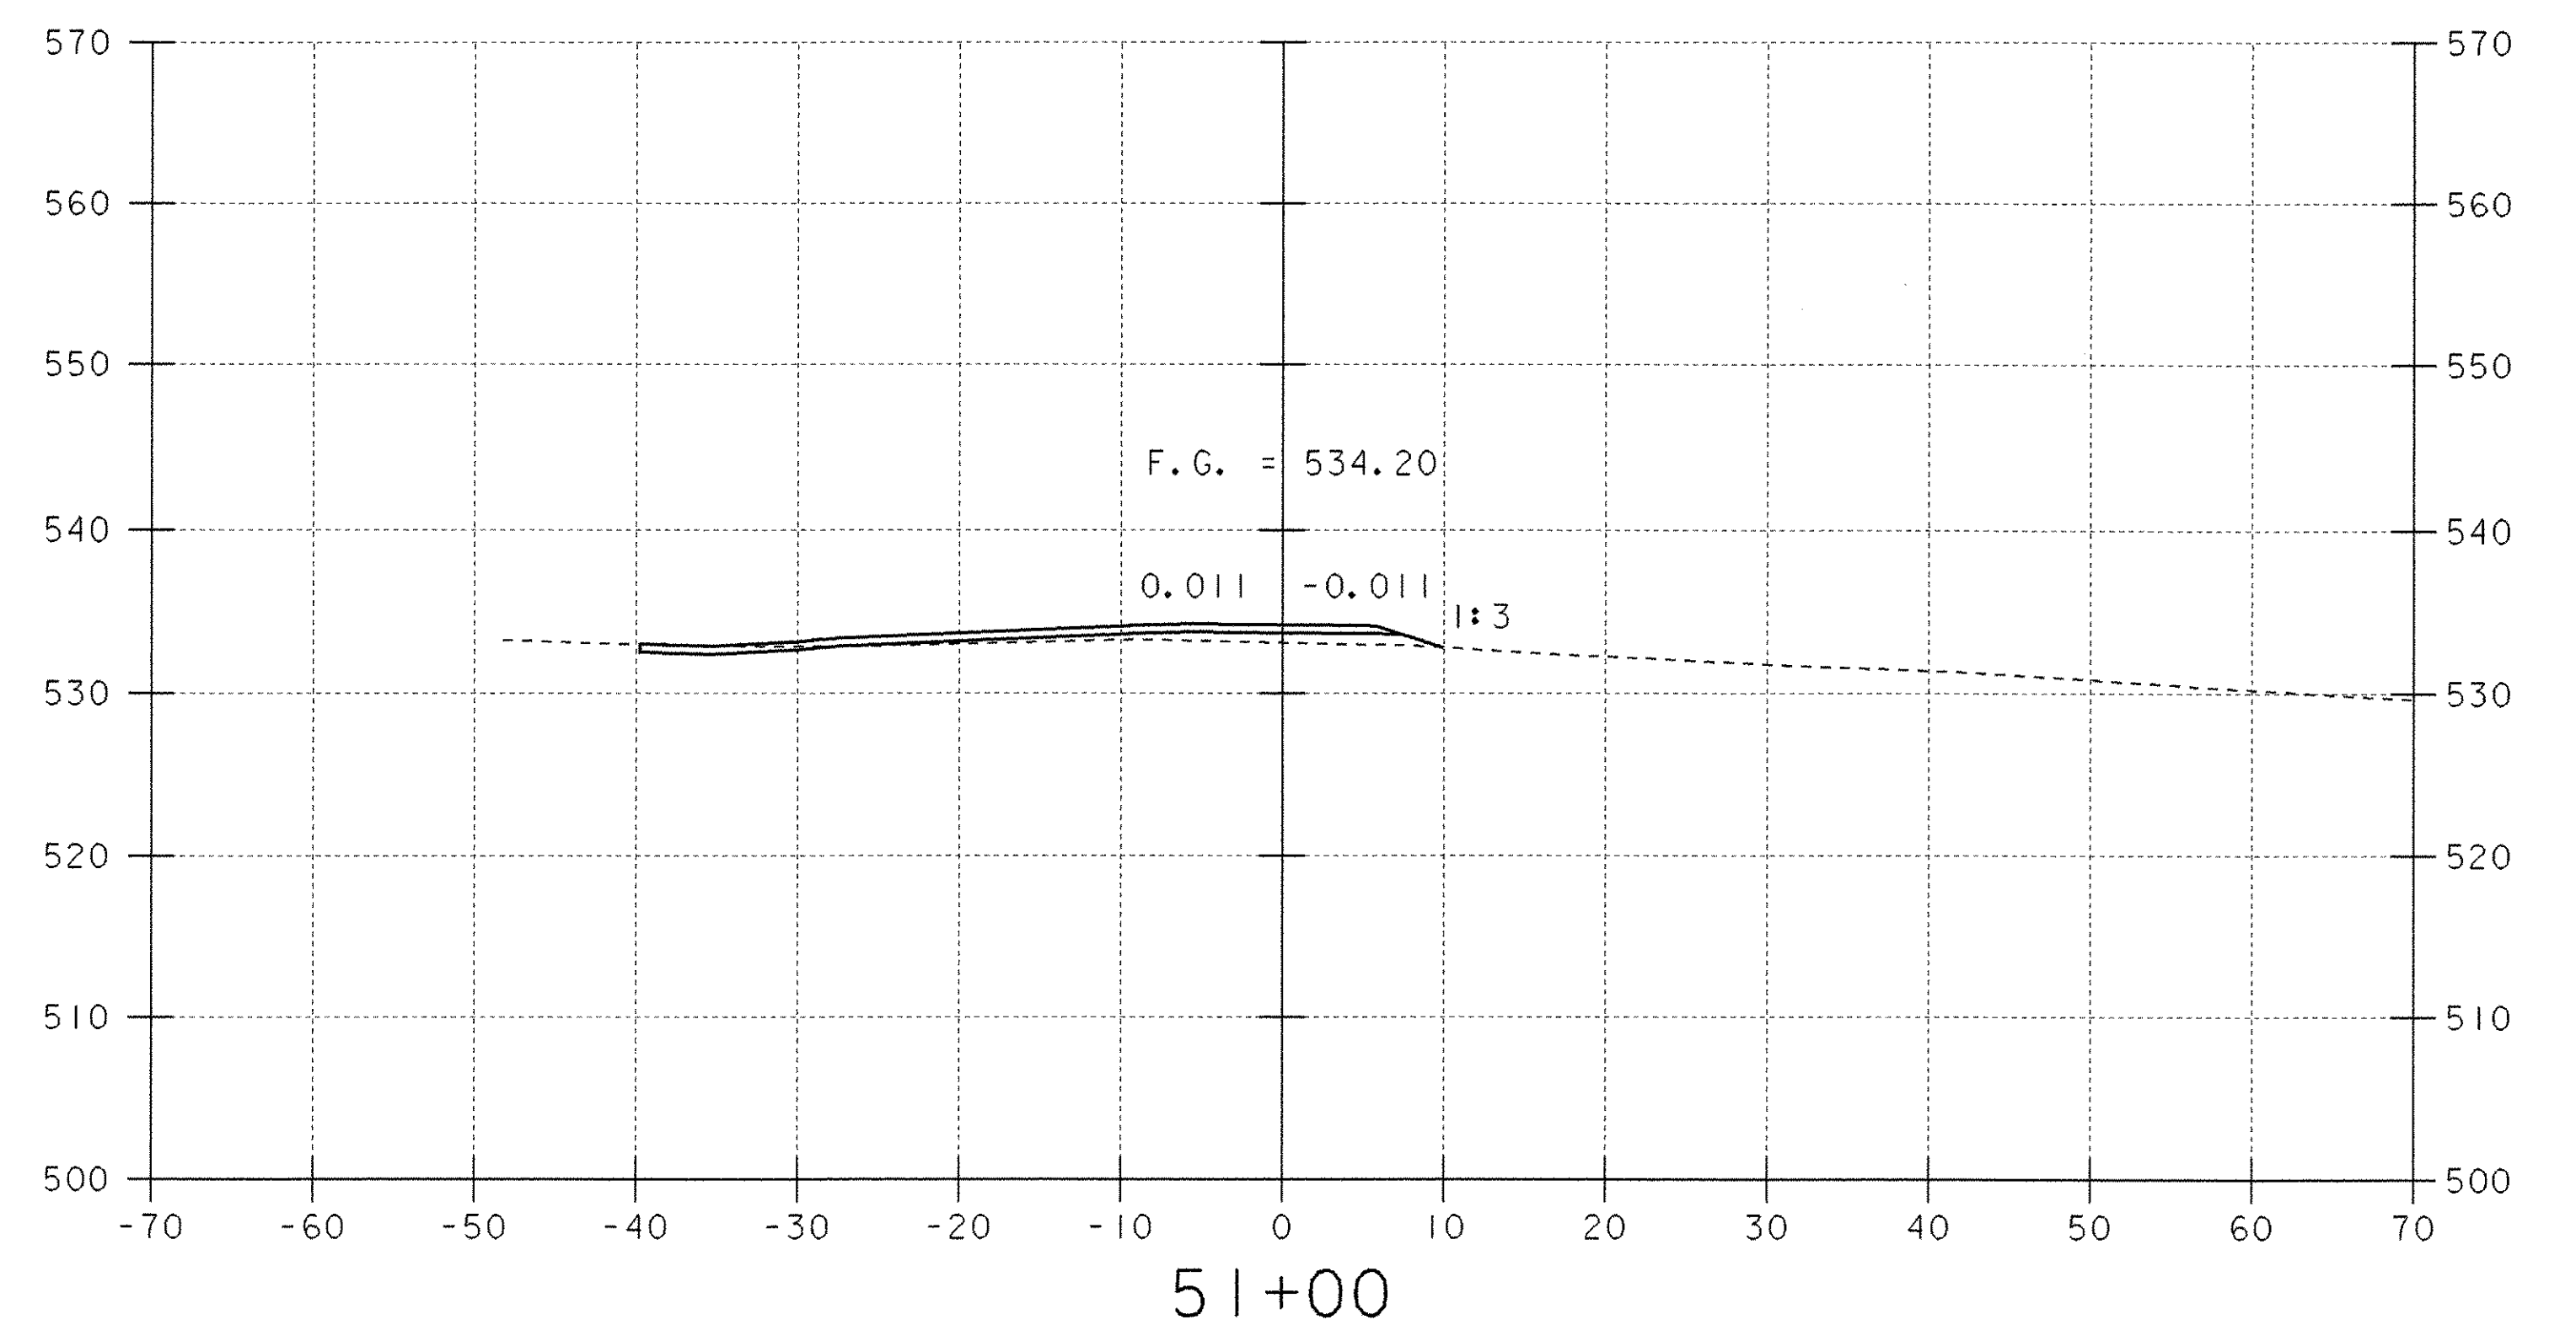

SCALE 1" = 10'-0"

DATUM
VERTICAL _____
HORIZONTAL _____

PROJECT: FAIRFAX-FAIRFIELD-ST. ALBANS	PROJECT NO.: IM 089-3 (27)
DESIGN FILE NAME: \96a056\Structures\sa056xs4.dgn	PLOT DATE: 21-SEP-2000
IPARM FILE NAME: sa056d01.i	BRIDGE SHEET BR324
DRIVE CROSS SECTIONS (1)	SHEET: 150 OF 370
STA. 50+25 TO STA. 51+00	