




BEGIN APPROACH SLAB NO. 6
 SB STA. 3425 + 01.68
 TOP OF APPROACH SLAB
 ELEV. 578.13

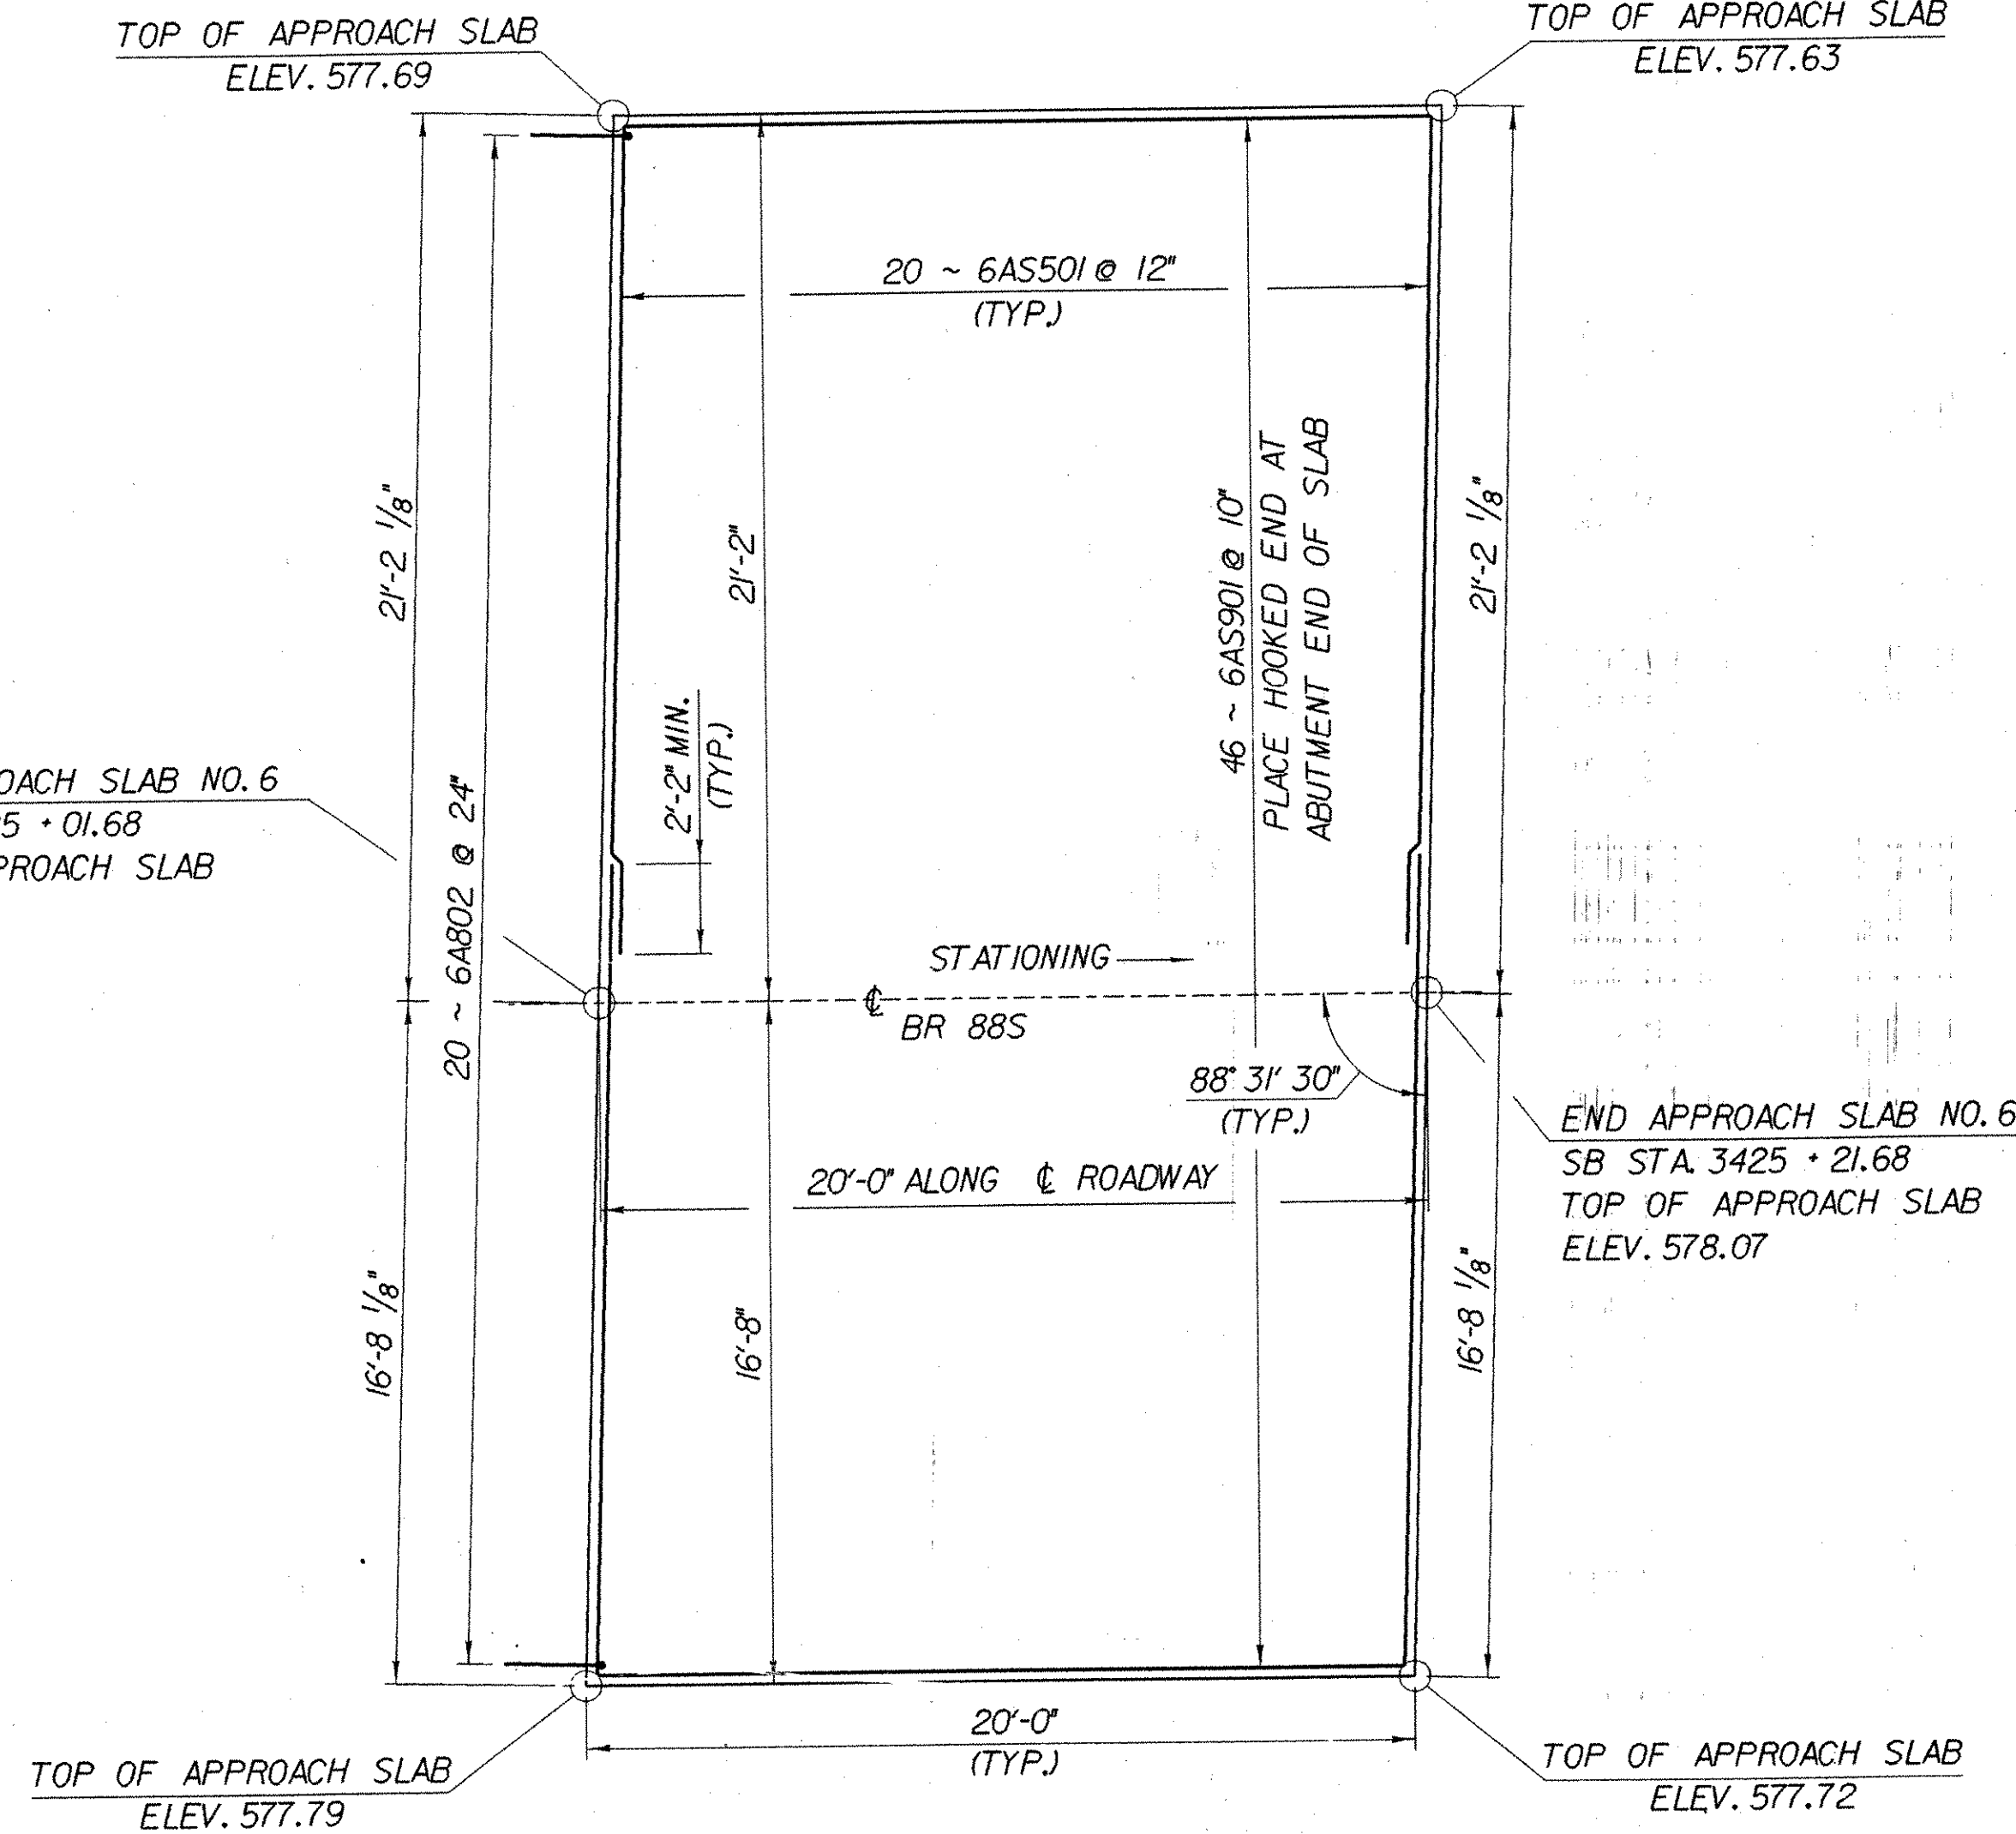


BRIDGE 88S APPROACH SLAB PLAN
 SCALE: 1/4" = 1'-0"

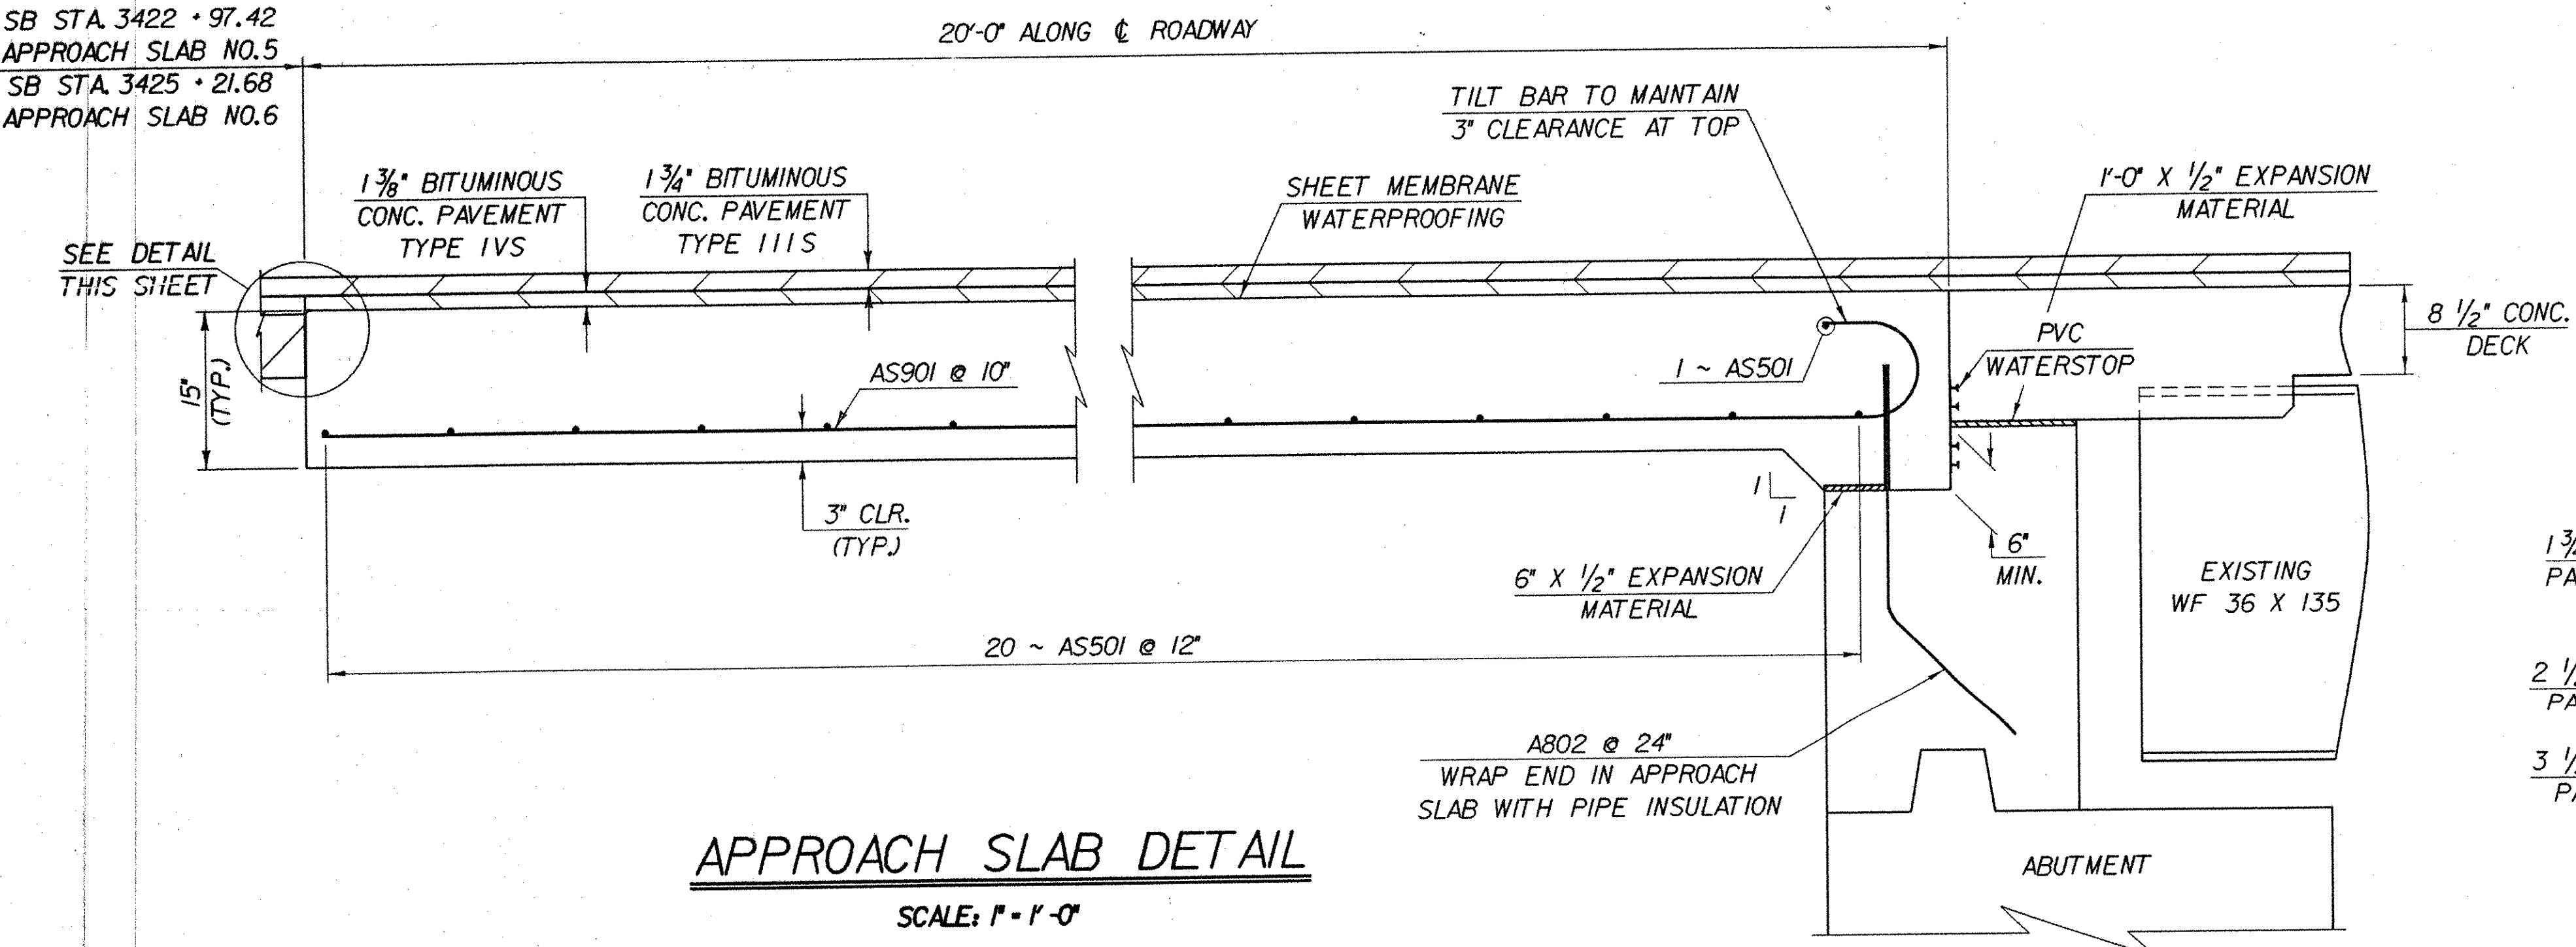

APPROACH SLAB DETAIL
 SCALE: 1" = 1'-0"

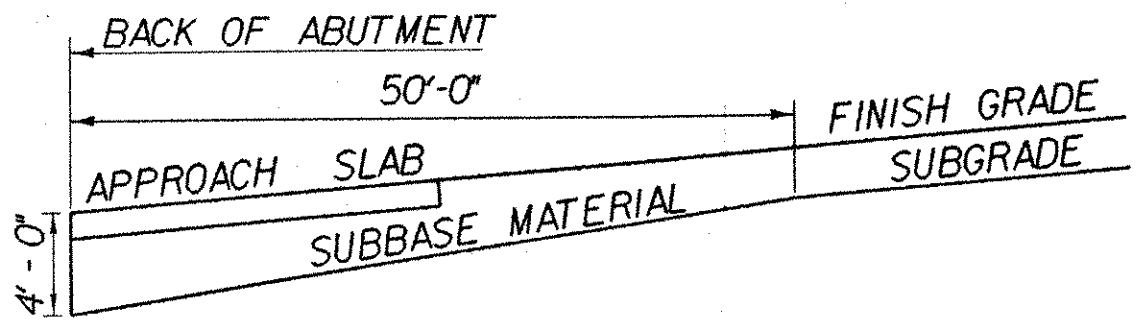

SUBBASE DETAIL AT ABUTMENTS
 (ELEVATION IN CUT AND FILL)
 NOT TO SCALE

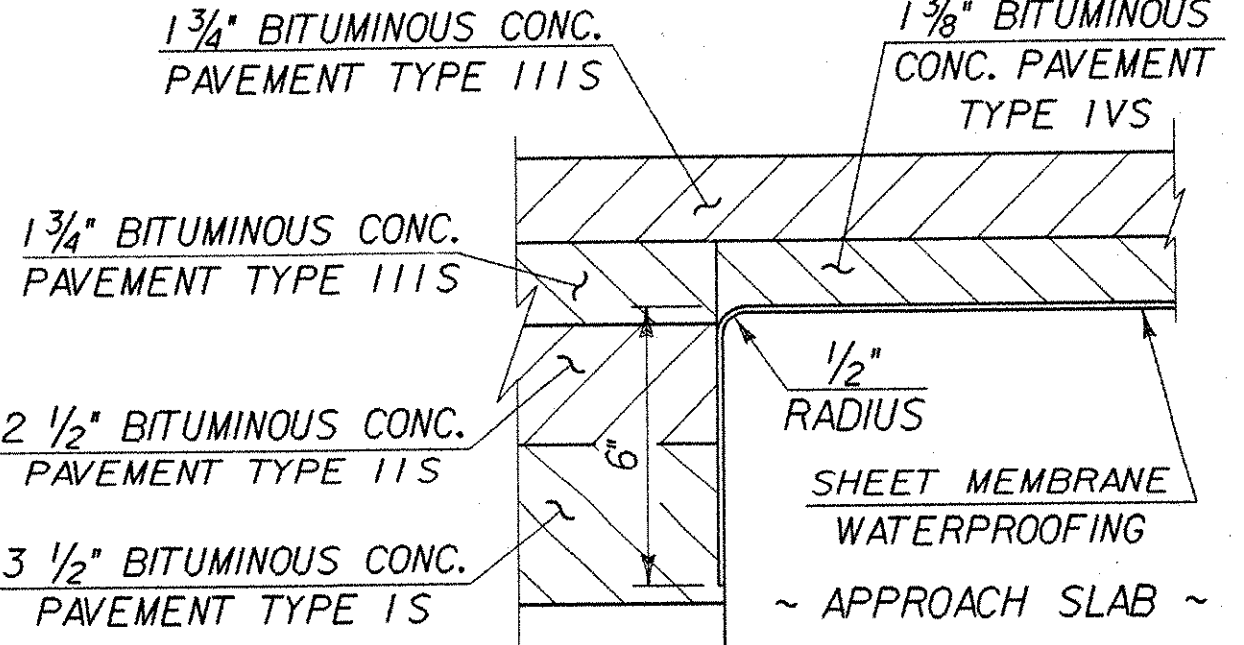

DETAIL FOR SHEET MEMBRANE AT APPROACH SLAB END
 SCALE: 3" = 1'-0"

IMPORTANT NOTE: BRIDGE FINISHED GRADES ARE CENTERLINE GRADES.

STATE OF VERMONT AGENCY OF TRANSPORTATION	
Town of FAIRFAX-FAIRFIELD-ST. ALBANS	Bridge No. 88S
Highway No. 1-89	Log Sta. Surv. Sta.
1-89 OVER ST. ALBANS SOUTH STATE HIGHWAY (EXIT 19)	
88S APPROACH SLAB DETAILS	
Designed By M. LOZIER	Drawn By K. CHISHOLM
Checked By M. LOZIER	Bridge Design Supervisor R. R. WHITCOMB Date 2/00
PROJECT FAIRFAX-FAIRFIELD-ST. ALBANS	PROJECT NO. 1 M 089 - 3 (27)
I.G.C. Info. 96a056Structures\sa056sp3.dgn	sa056apl
Bridge Sheet No. BR429	Sheet 181 of 370