



**BRIDGE 88N APPROACH SLAB PLAN**  
SCALE: 1/4" = 1'-0"

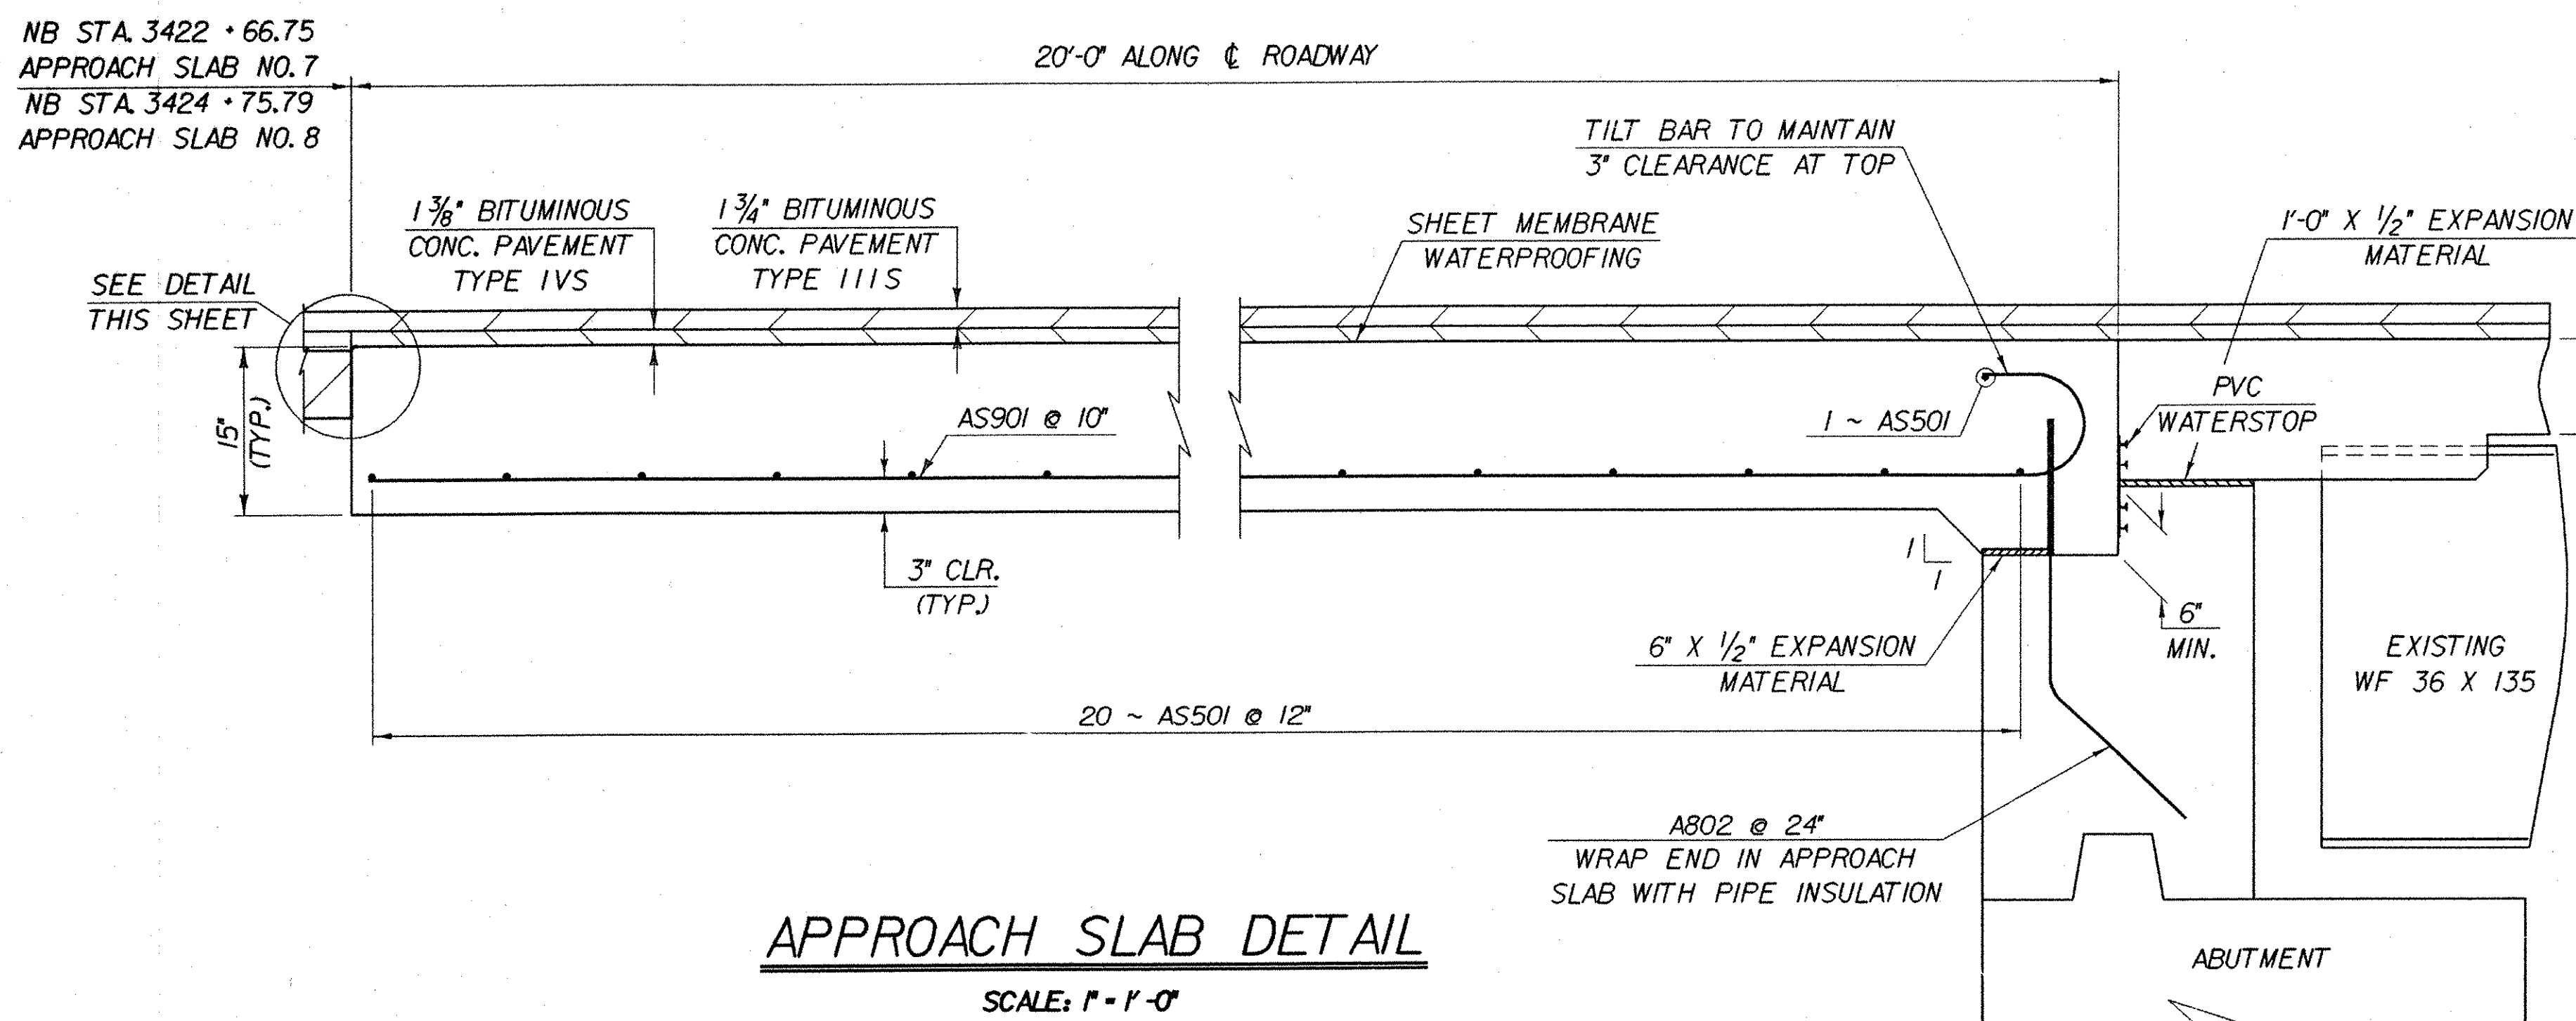


**APPROACH SLAB DETAIL**  
SCALE: 1" = 1'-0"

**IMPORTANT NOTE: BRIDGE FINISHED GRADES ARE CENTERLINE GRADES.**

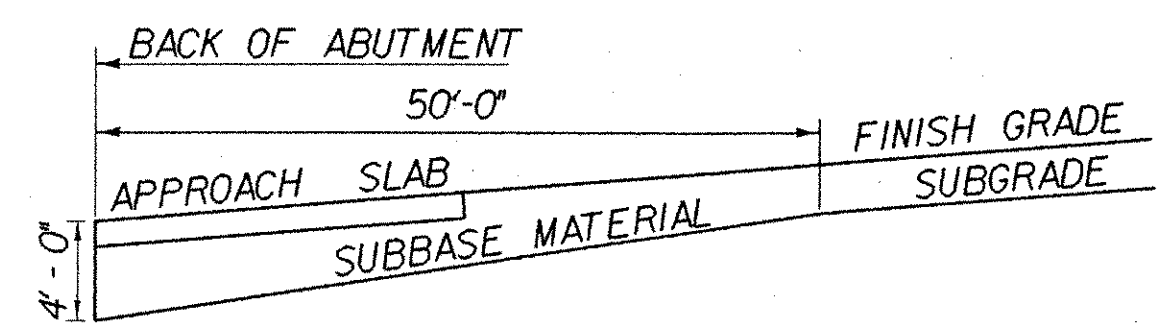

**SUBBASE DETAIL AT ABUTMENTS**  
(ELEVATION IN CUT AND FILL)  
NOT TO SCALE

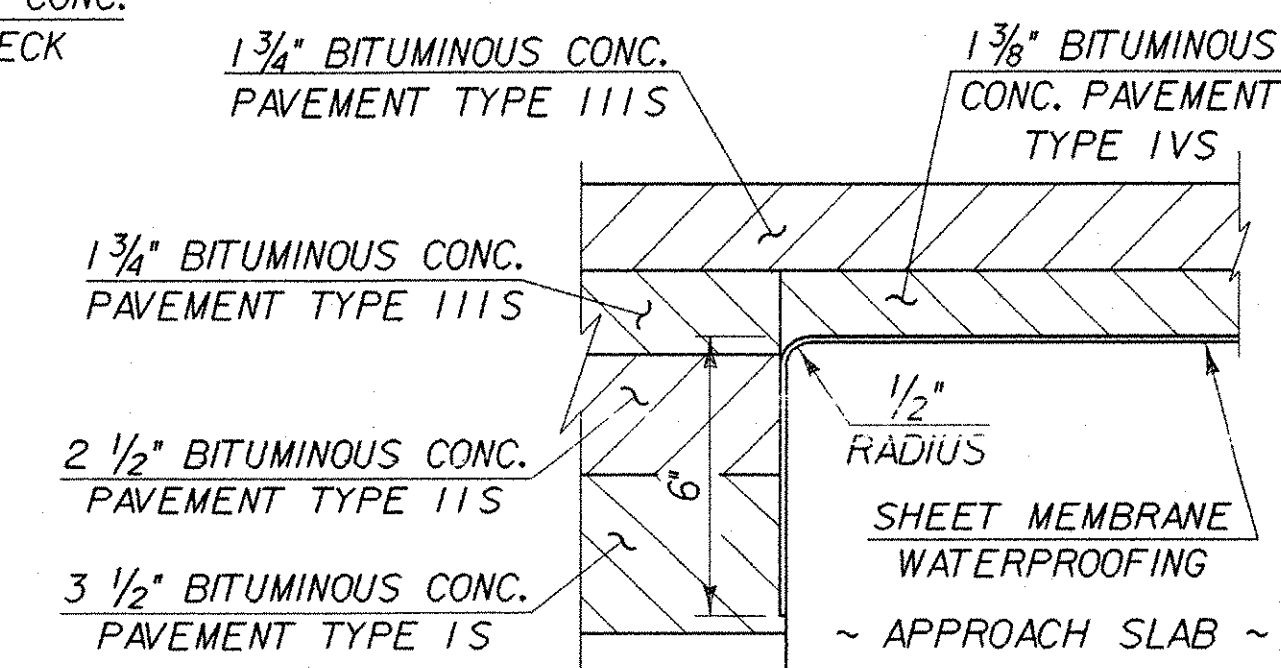

**DETAIL FOR SHEET MEMBRANE AT APPROACH SLAB END**  
SCALE: 3" = 1'-0"

<b>STATE OF VERMONT AGENCY OF TRANSPORTATION</b>	
Town of <b>FAIRFAX-FAIRFIELD-ST. ALBANS</b>	Bridge No. <b>88N</b>
Highway No. <b>I-89</b>	Log Sta. _____
<b>I-89 OVER ST. ALBANS SOUTH STATE HIGHWAY (EXIT 19)</b>	
<b>88N APPROACH SLAB DETAILS</b>	
Designed By <b>M. LOZIER</b>	Drawn By <b>K. CHISHOLM</b>
Checked By <b>M. LOZIER</b> Date <b>2/00</b>	Bridge Design Supervisor <b>R.R. WHITCOMB</b> Date <b>2/00</b>
PROJECT <b>FAIRFAX-FAIRFIELD-ST. ALBANS</b>	PROJECT NO. <b>1M 089 - 3 (27)</b>
I.G.C. Info. <b>96a056Structures\sa056sp4.dgn</b>	<b>sa056sp2.j</b>
Bridge Sheet No. <b>BR430</b>	Sheet <b>182</b> of <b>370</b>