


PIER NO. 2 PLAN
SCALE: 3/8" = 1'-0"

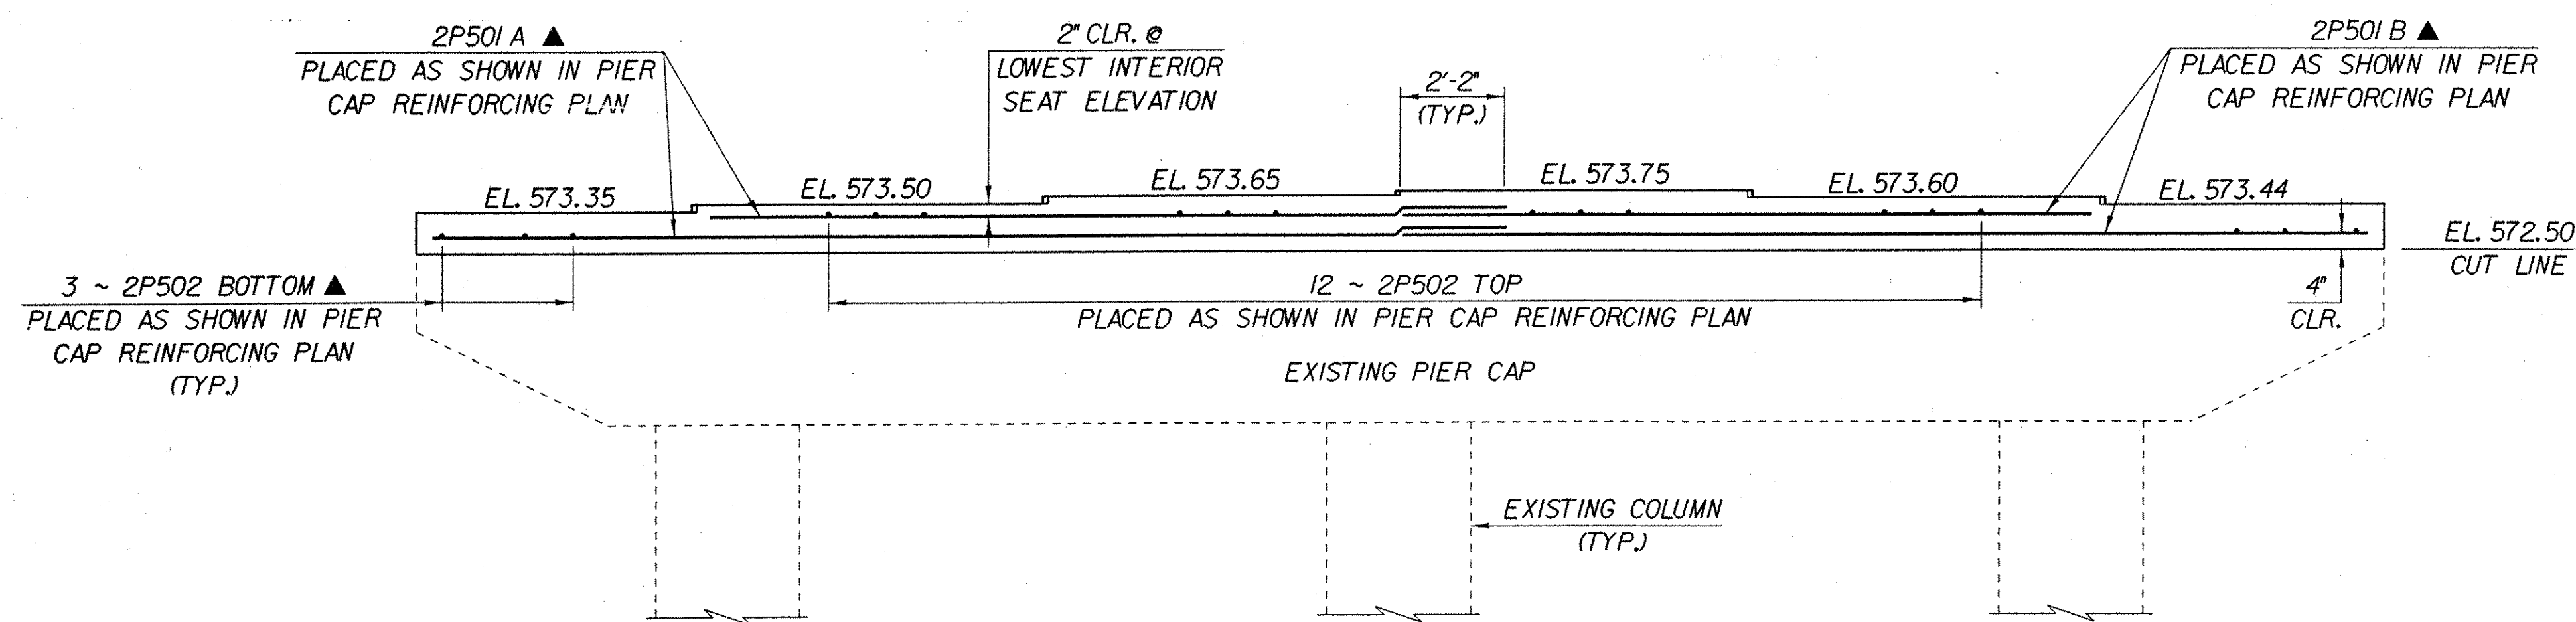

PIER NO. 2 PARTIAL ELEVATION
(LOOKING UPSTATION)
SCALE: 3/8" = 1'-0"

IMPORTANT NOTE: BRIDGE FINISHED GRADES ARE CENTERLINE GRADES.

NOTE:

NF - NEAR FACE
FF - FAR FACE
EF - EACH FACE
▲ - CUT TO FIT IN FIELD
3" CLR. UNLESS OTHERWISE SPECIFIED ON THE PLANS.

**STATE OF VERMONT
AGENCY OF TRANSPORTATION**

| | |
|---|---|
| Town Of FAIRFAX-FAIRFIELD-ST. ALBANS | Bridge No. 88S |
| Highway No. 1-89 | Log Sta. Surv. Sta. |
| 1-89 OVER ST. ALBANS SOUTH STATE HIGHWAY (EXIT 19) | |
| PIER NO. 2 DETAILS | |
| Designed By M. LOZIER | Drawn By K. CHISHOLM |
| Checked By M. LOZIER Date 2/00 | Bridge Design Supervisor R. R. WHITCOMB Date 2/00 |
| PROJECT FAIRFAX-FAIRFIELD-ST. ALBANS | PROJECT NO. 1M 089 - 3 (27) |
| I.G.C. Info. 96a056Structures\sa056ab2.dgn | sa056pr2.j |
| Bridge Sheet No. BR443 | Sheet 195 of 370 |