
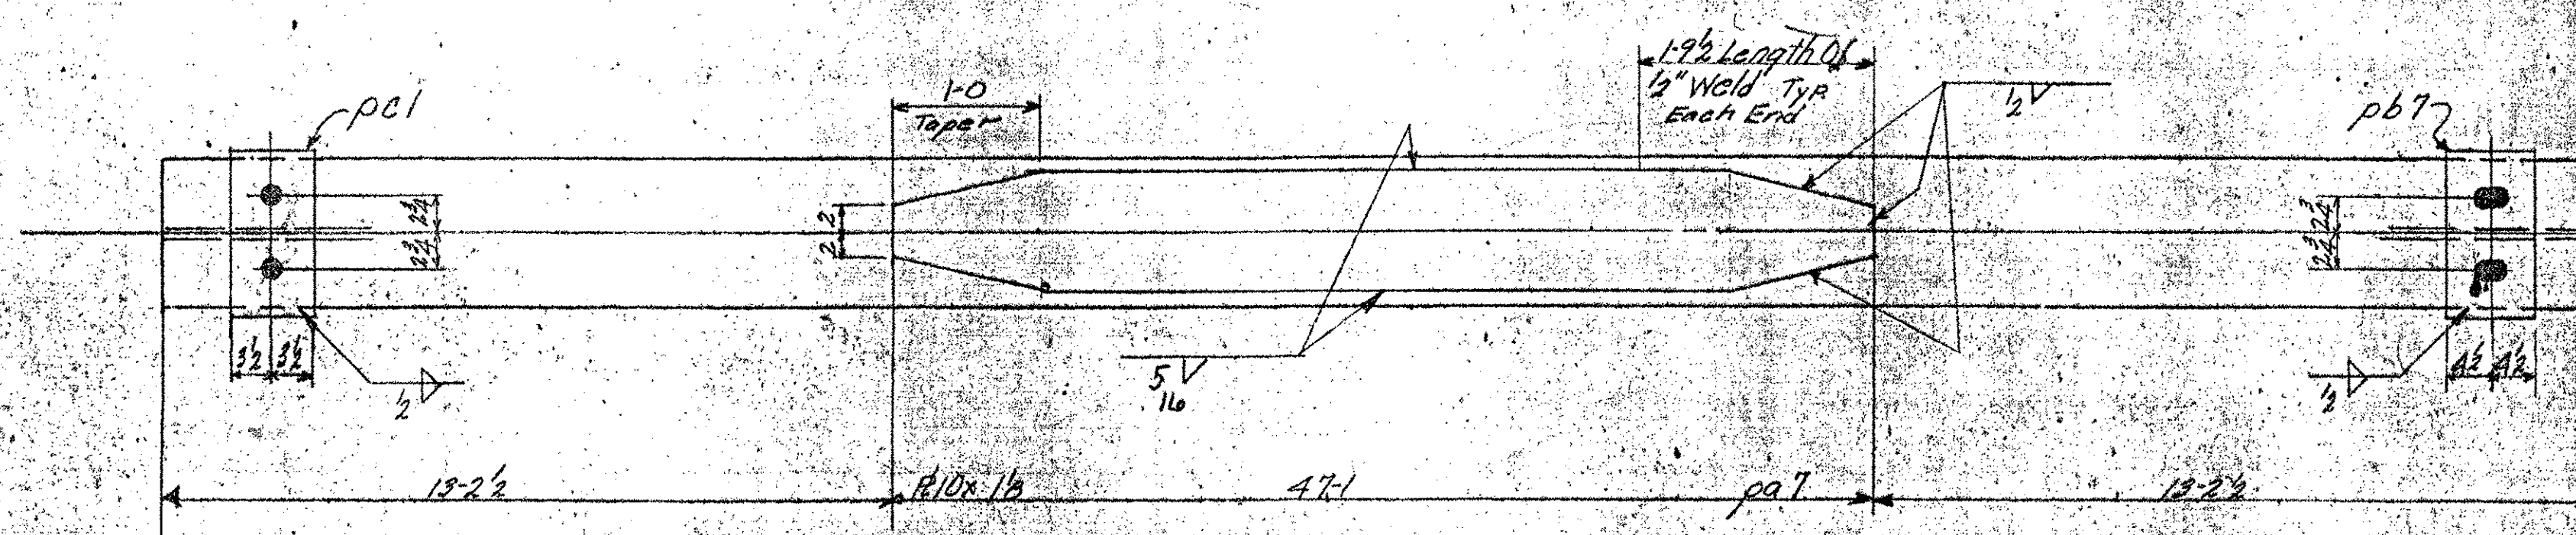
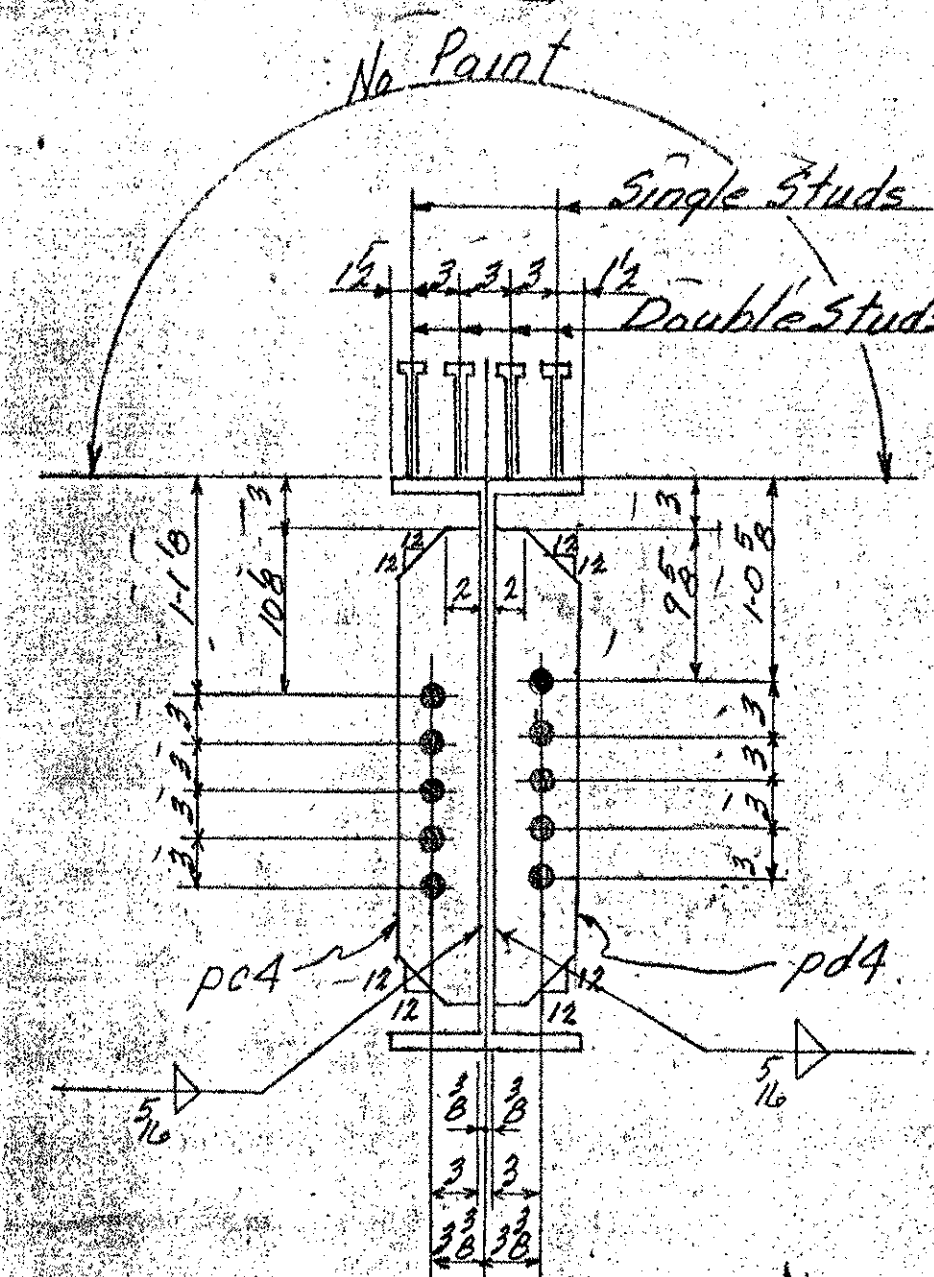


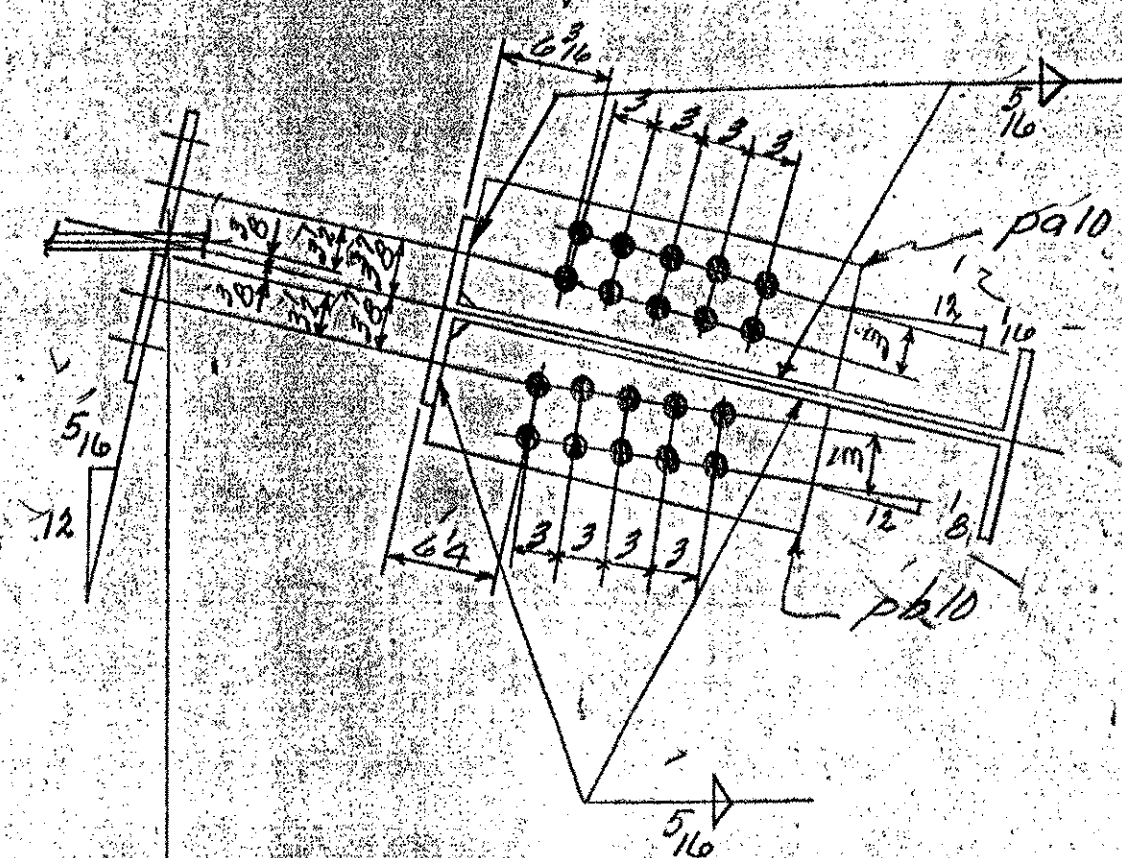

BRIDGE SHEET BR474
REFERENCE SHEET 20 OF 37
SHEET 226 OF 370

[illegible][illegible]

VERMONT STRUCTURAL STEEL CORPORATION BURLINGTON, VT.					
		PROJECT <i>I-89 Over Approach Road</i>		<i>P.O.# 109-3(35) 72</i>	
DRAWN BY	<i>L.C. Nichols</i>	LOCATION	<i>Seargeant Fairbanks Field - St Albans</i>	PRINT RECORD	
CHECKED BY	<i>R.L.M. 11-18-66</i>	CUSTOMER	<i>Lane Const. Co.</i>	NO.	FOR
HOLDER	<i>15% Noted</i>	ARCHITECT	<i>State of Vt. Dept. of Highways</i>	<i>13</i>	<i>APP 11-2</i>
BOLTS	<i>None</i>	JOB NO.	<i>66-1189-220</i>	<i>20</i>	<i>Slip 128</i>
PAINT	<i>Red Lead Vii</i>	SHEET NO.	<i>10</i>	<i>2</i>	<i>STRIP 128</i>
	<i>Specs. Noted</i>		<i>66-1189-226</i>	<i>2</i>	<i>LANE 11-2</i>
			<i>STP 51</i>		
			<i>Shear Studs</i>		