
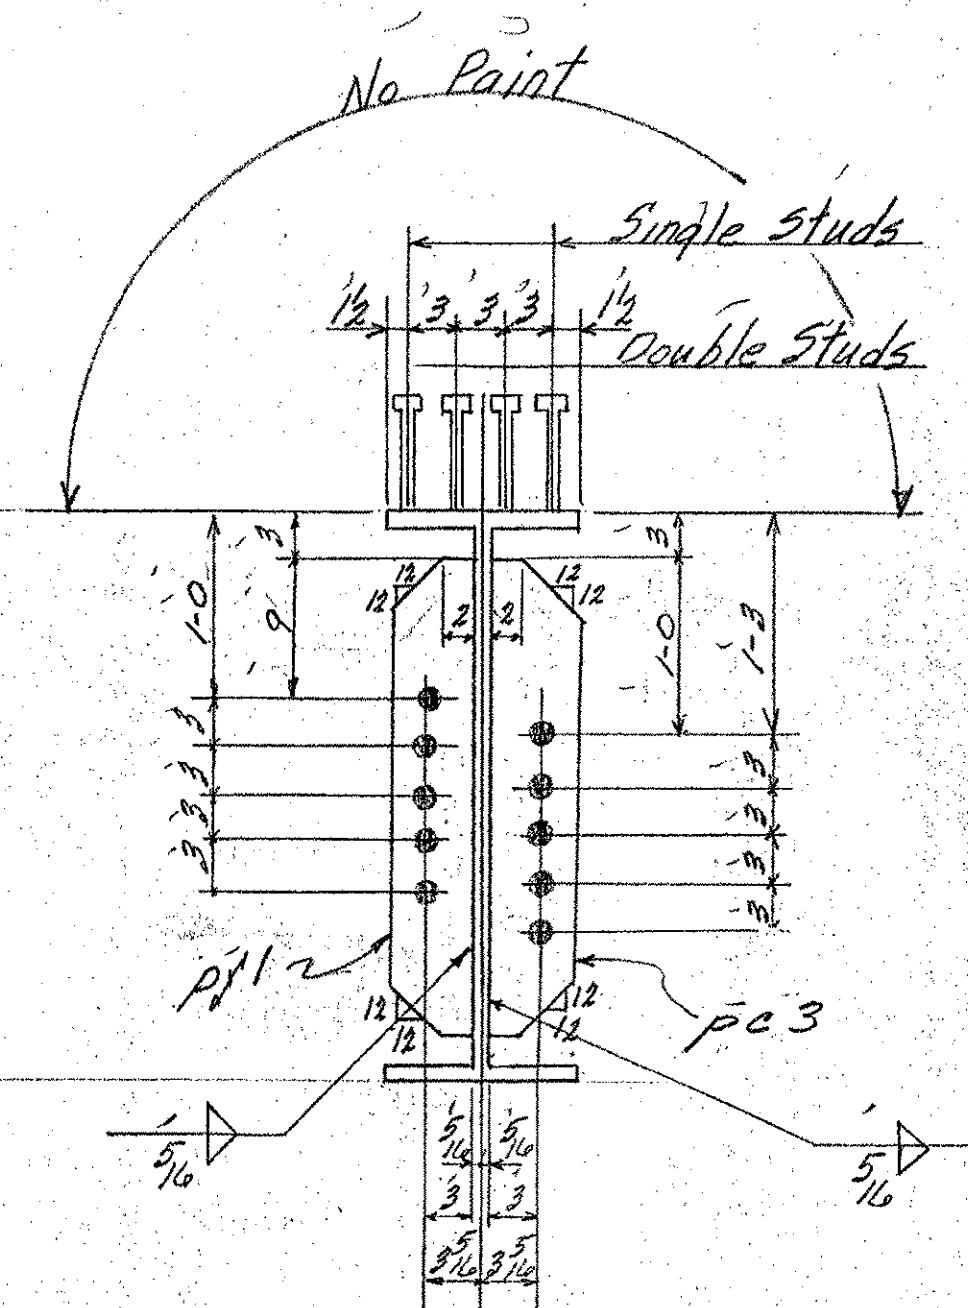


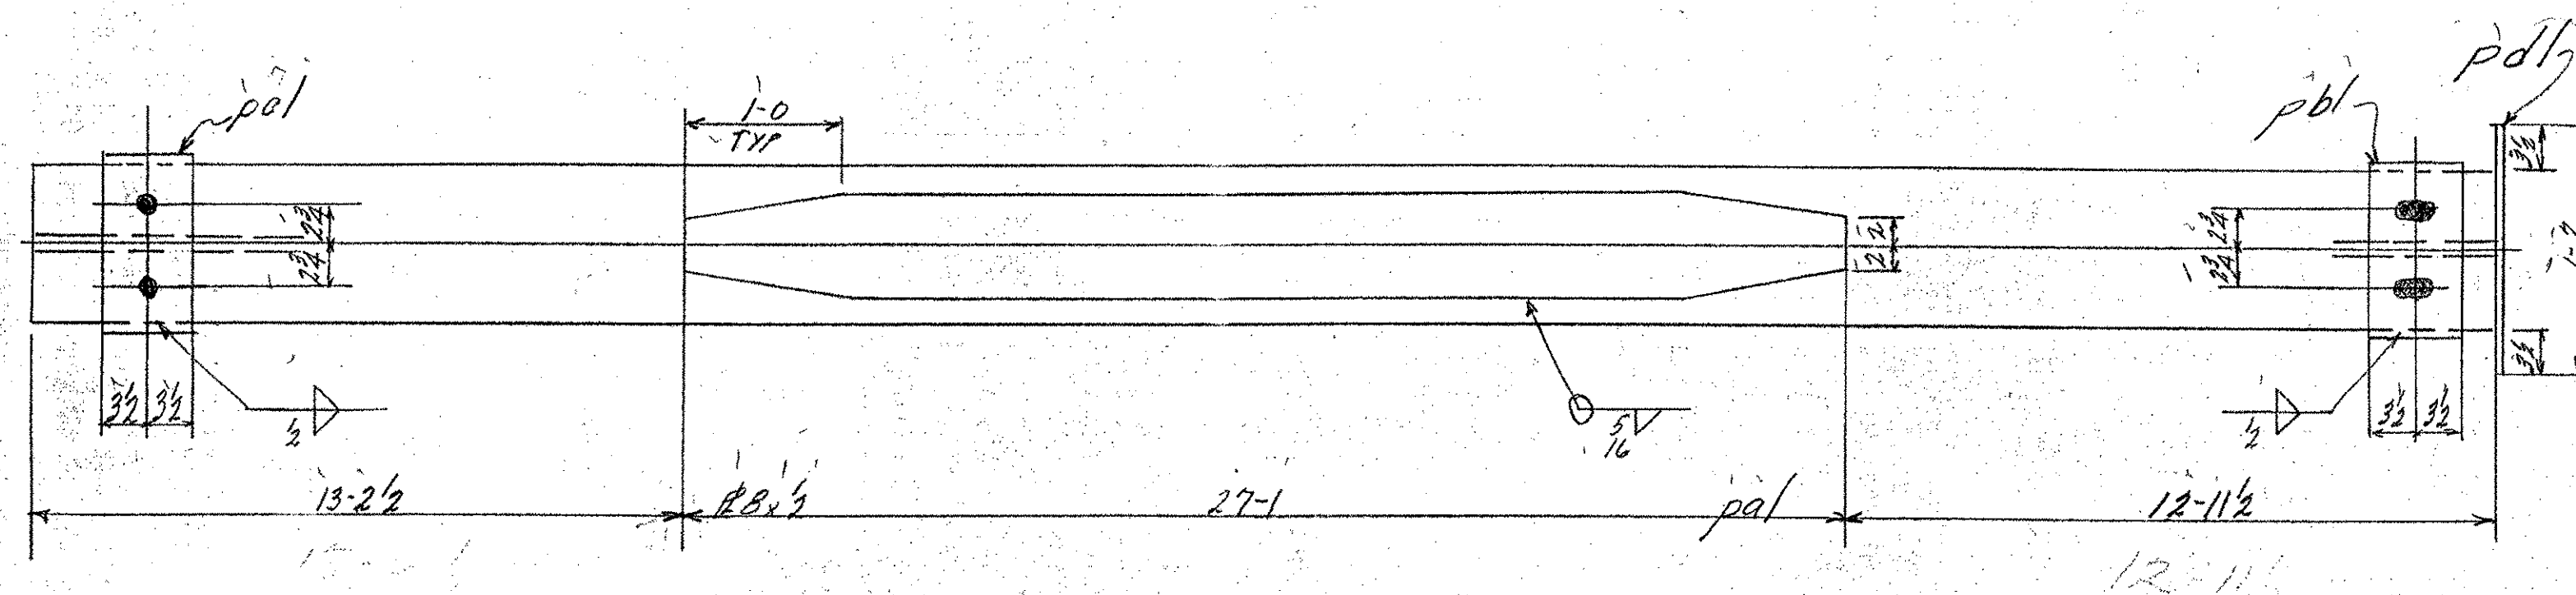

BRIDGE SHEET BR479
REFERENCE SHEET 25 OF 37
SHEET 231 OF 370

[illegible]

JOB NO.		SHEET NO.			
BILL OF MATERIAL					
NO. PIECES	MARK	DESCRIPTION	LENGTH		WEIGHT
			FT.	IN.	
ASTM-A36					
		Beam			
1	BB15	36W-135	53	3	ord. 336662 7189 ✓
1	pel	Bar 3x3	27	1	336662 368 ✓
1	pb1	Bar 7x1	1	1	Res @ 20-0
1	pel	do	1	1	52 ✓
1	pel	3x3	1	7	Res @ 33x4x10-0 13 ✓
1	pb3	Bar 3x3	2	0	ord. 26-0
1	pb3	do	2	0	336662 54 ✓
2	pb3	Bar 3x3	2	6	Res @ 20-0
2	pb1	do	2	6	85 ✓
CUT					
		3/4" F Wld	2	4	24
		3/4" F Wld	34	9	31 ✓ 21
		Ord. 366-1189-226			4494
366		3/4" shear studs	0	7	7784
					368 ✓
					8162 ✓

[illegible]