
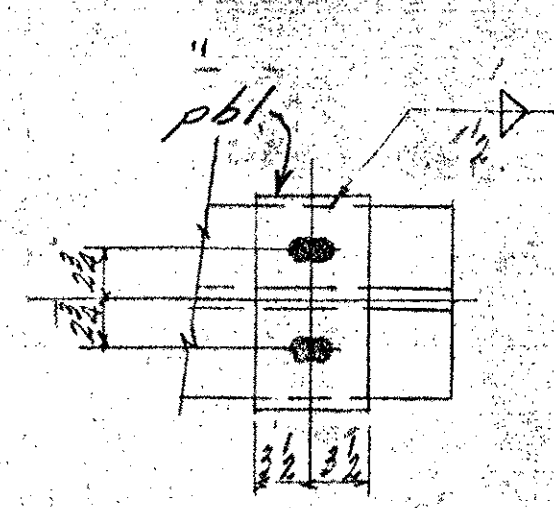


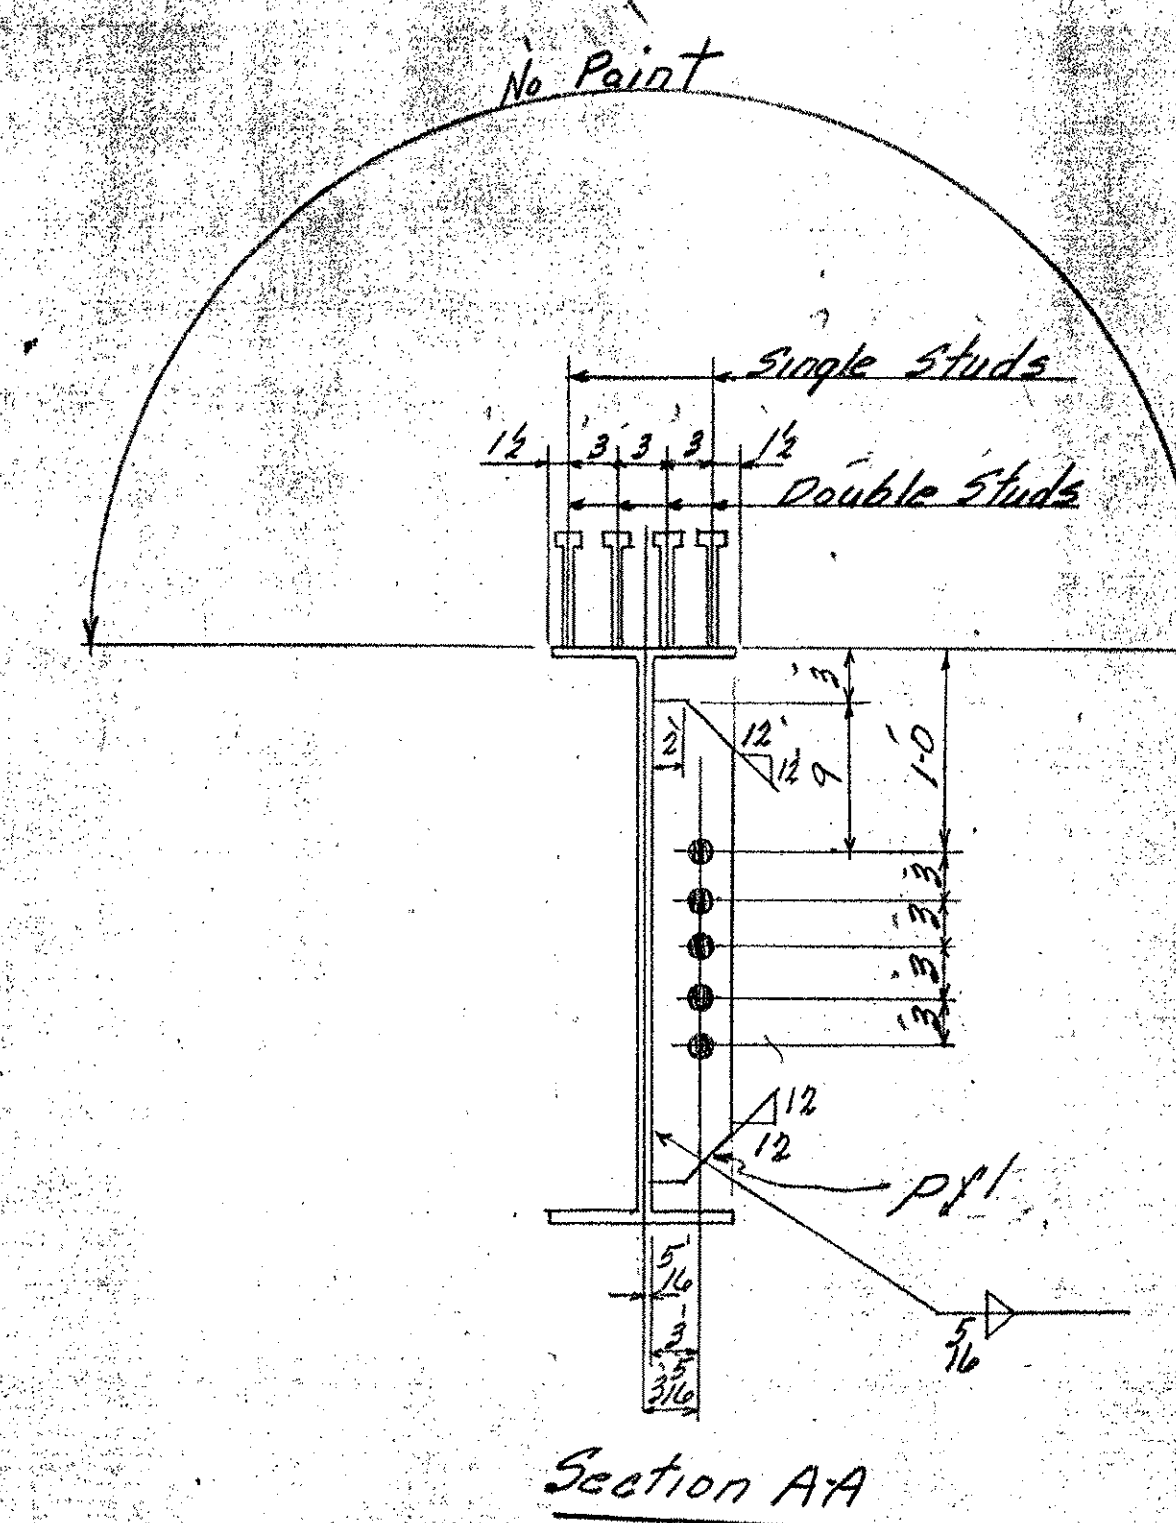

		DATE	PROJECT		PRINT RECORD		
DRAWN BY	LC	11-20-66	LOCATION	Georgia Fairfax - Fairfax St. Alameda			
CK'D BY	KLM	11-29-66	CUSTOMER	Lane Constr. Co.			
					NO.	FOR	DATE
					3	APP	11-29
					2	SHOP	11-29
					10	SLIP	12-5
					1	STATE	12-8
					2	LANE	12-8