
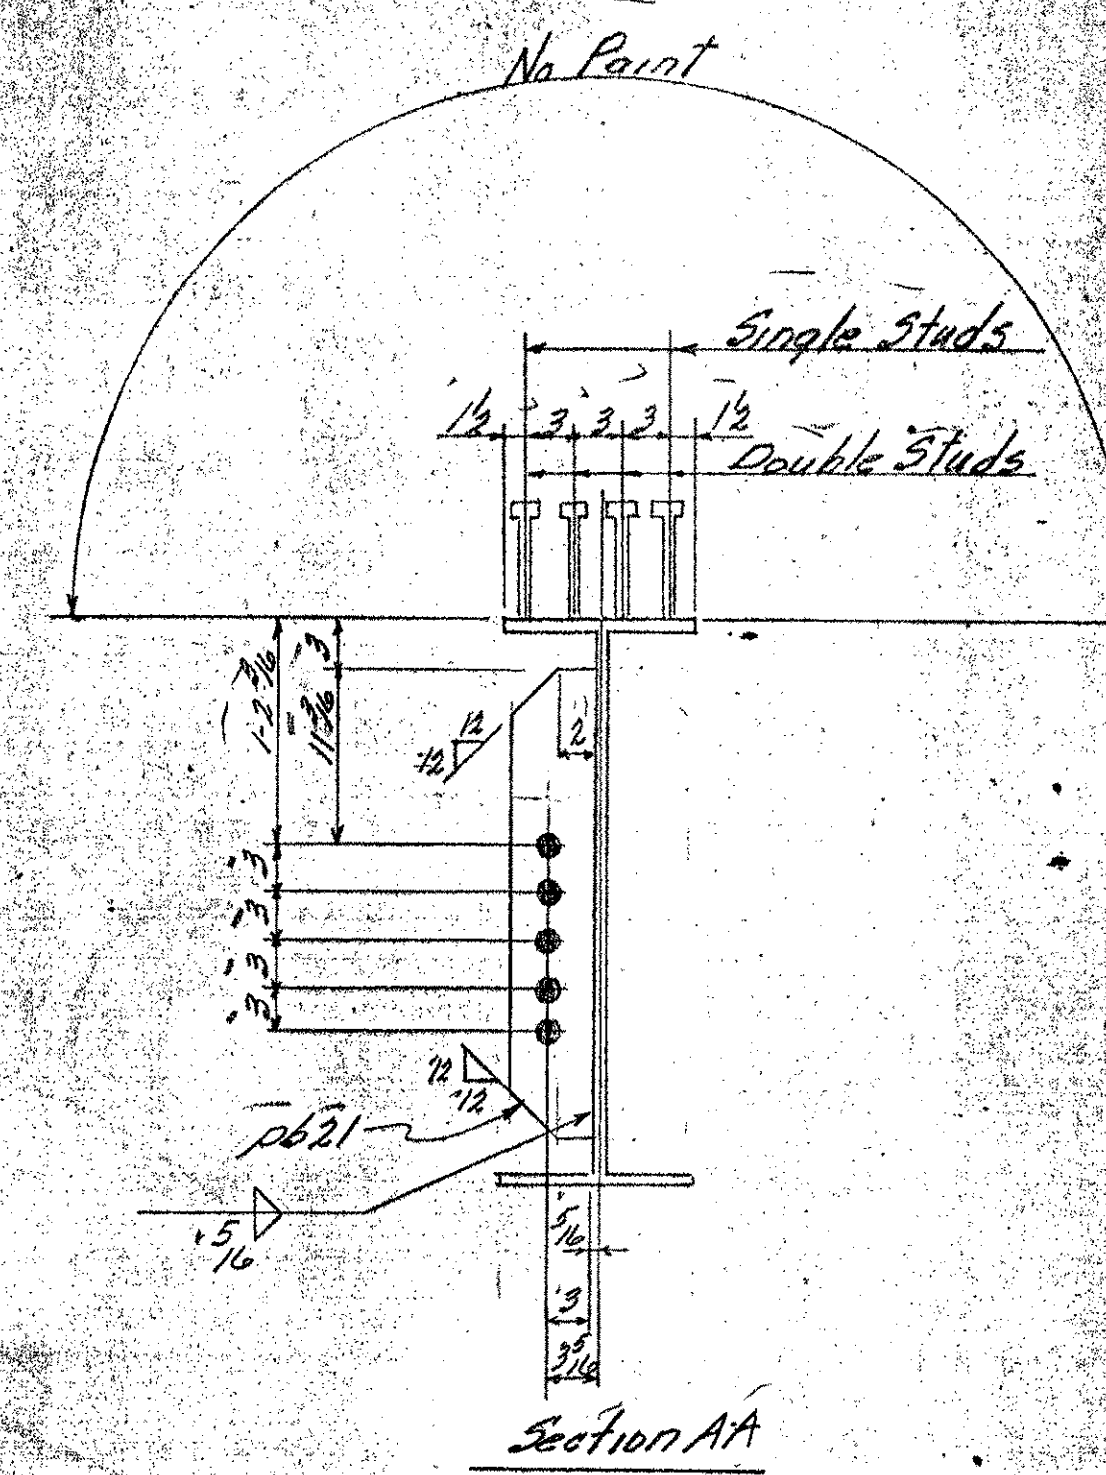


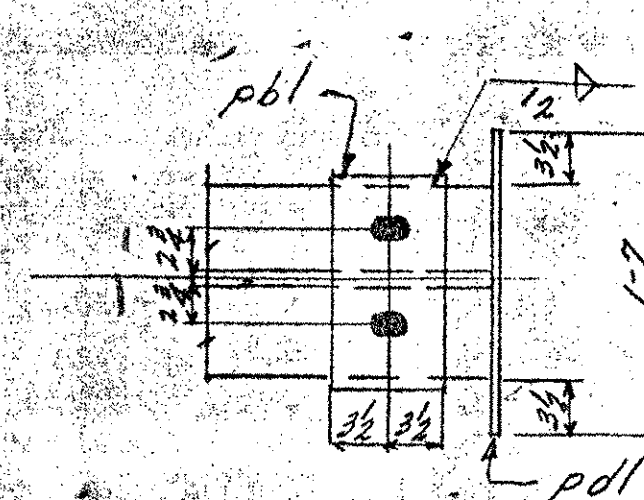

VERMONT STRUCTURAL STEEL CORPORATION BURLINGTON, VT.				Proj. No. "189-3(35)" #2		
		DATE	PROJECT	PRINT RECORD		
DRAWN BY	LC	11-2-26	LOCATION	I89 Over Approach Road		
OK'D BY	PLM	11-27-26	CUSTOMER	Luna Constr. Co.		
HOLES Paint/Painted BOLTS NONE PAINT Red Oxide Virginia 195 Noted			ARCHITECT	State of Vt Dept of Highways		
			JOB NO.	66-1184-300 5th St. SHEET NO. 27		
			66-1184-248 Short Study			
			NO.	FOR	DATE	
			3	APP	1-27	
			2 ¹	SHOP	11-27	
			20	Sh-y	12-5	
			2	STATE	12-5	
			2	CANE	12-28	