




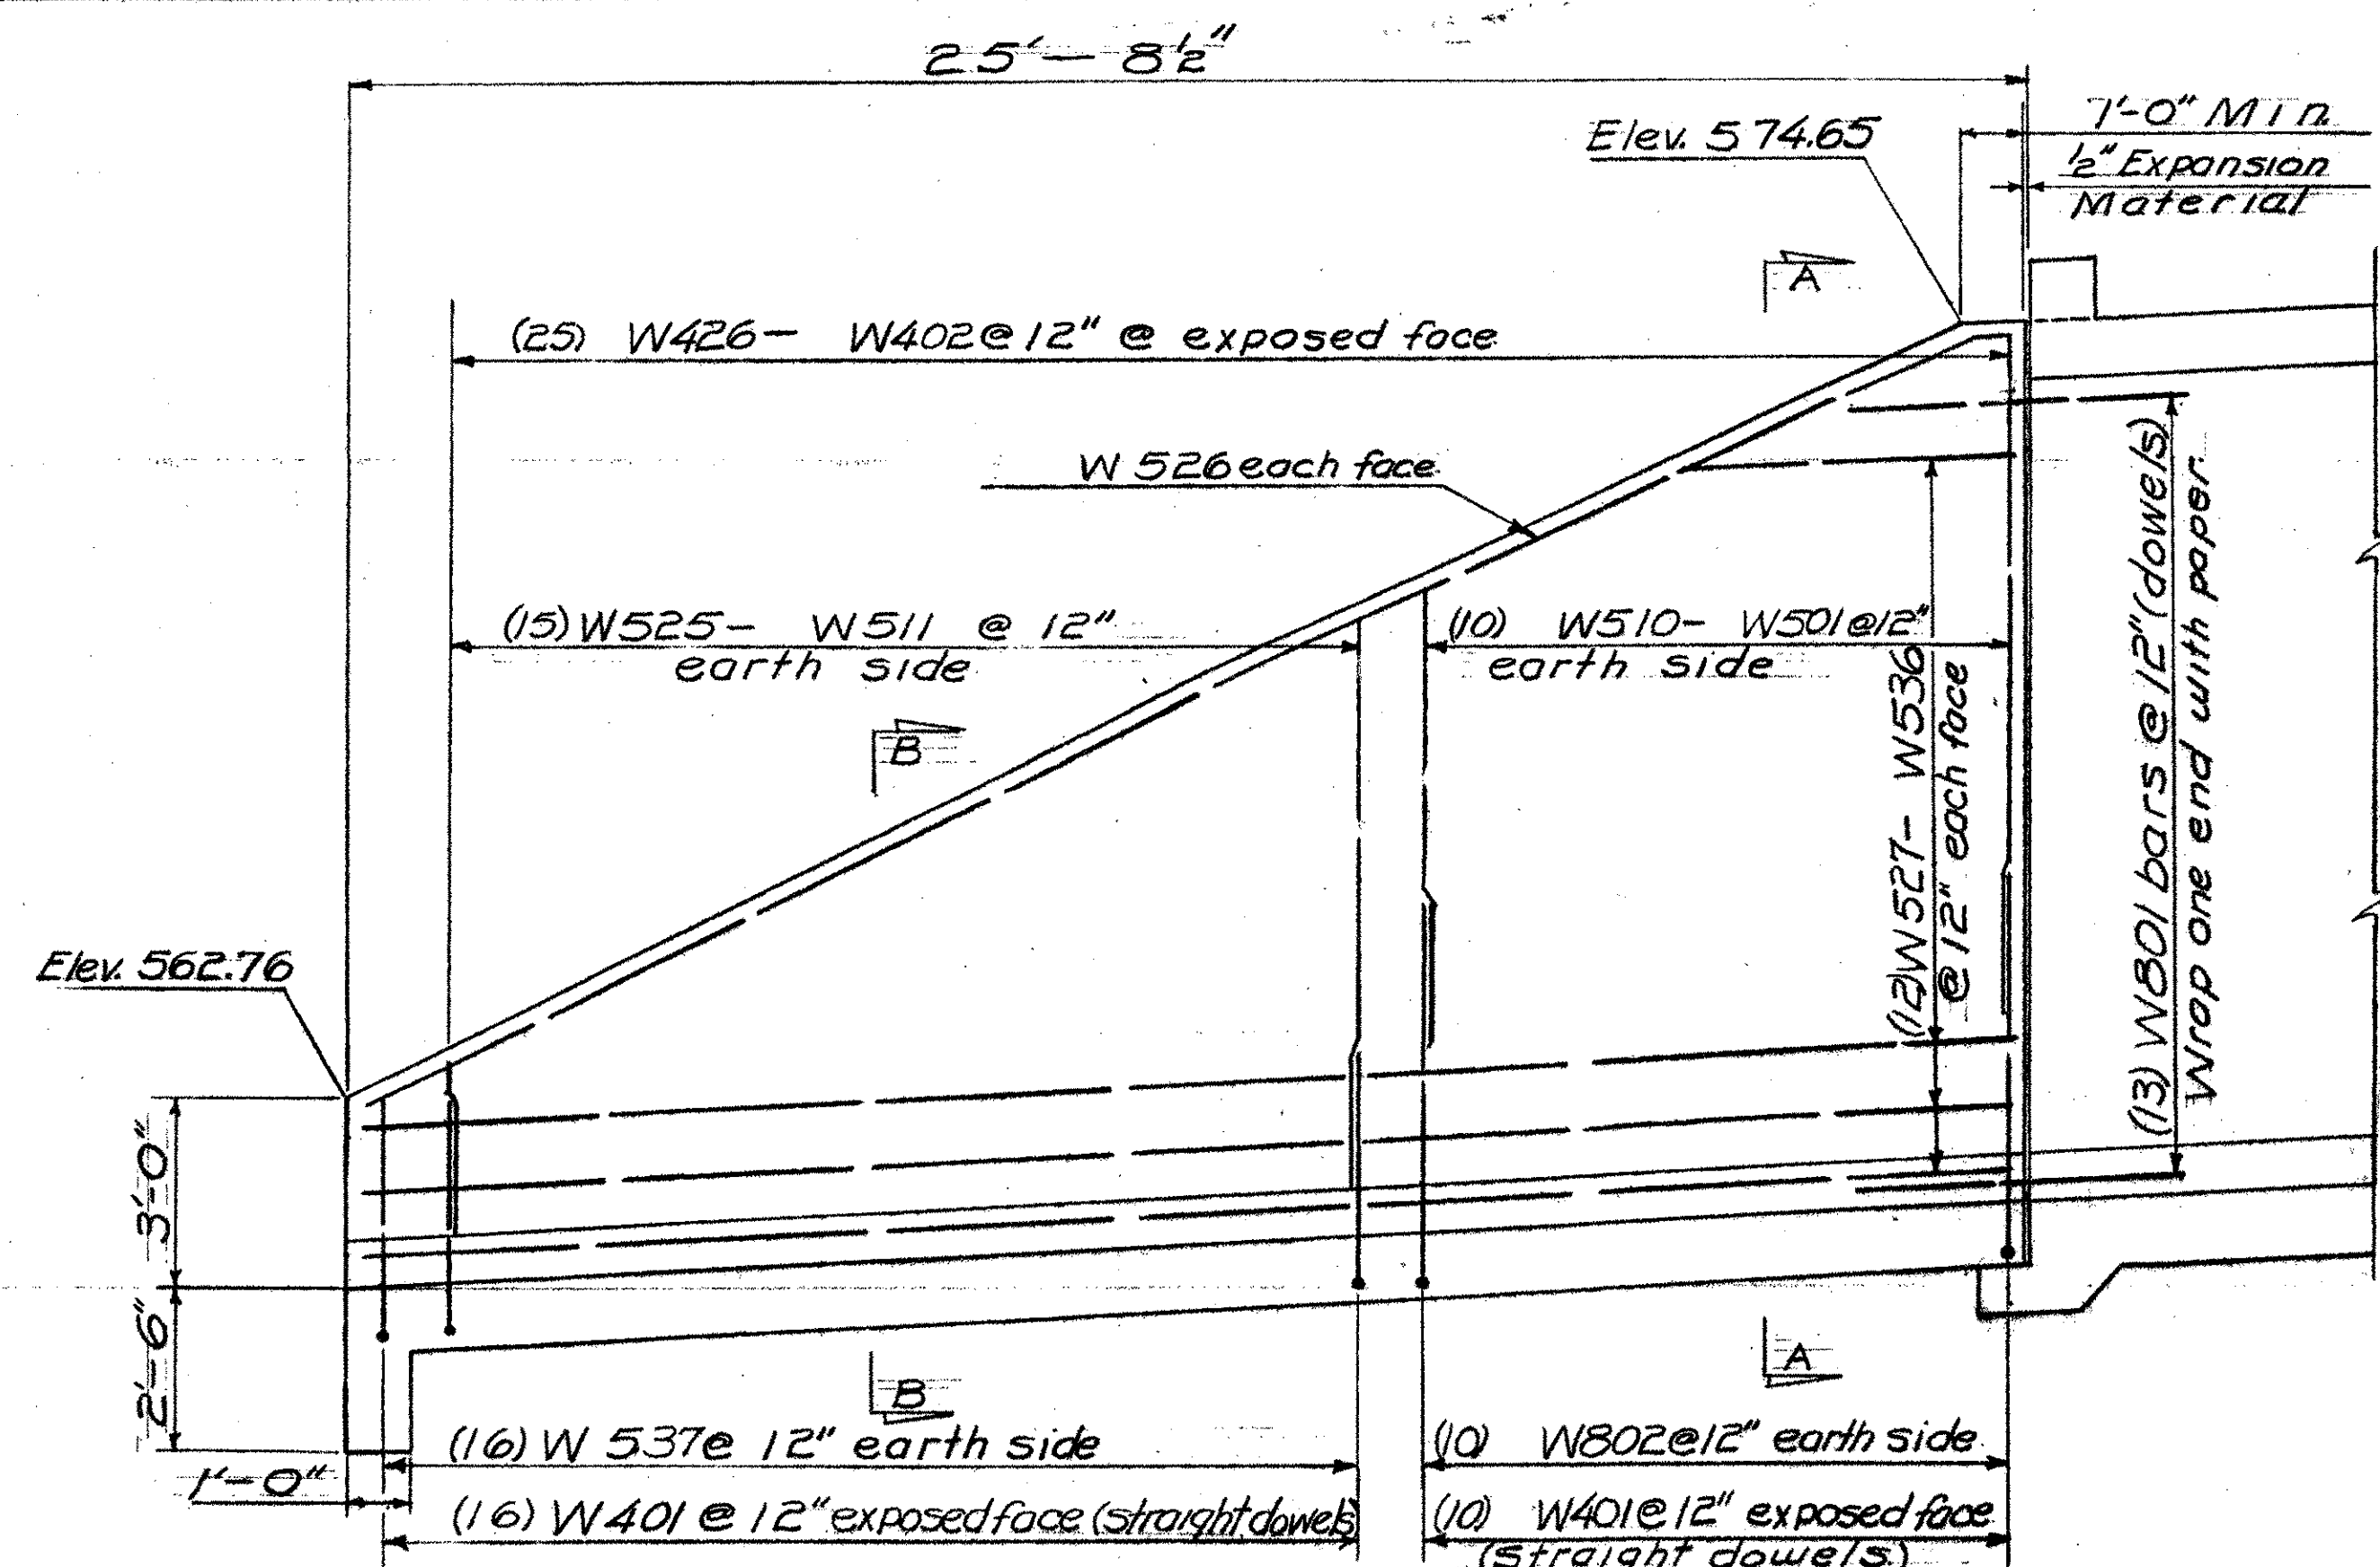


WINGS #14#2
Scale: 3/8" = 1'-0"

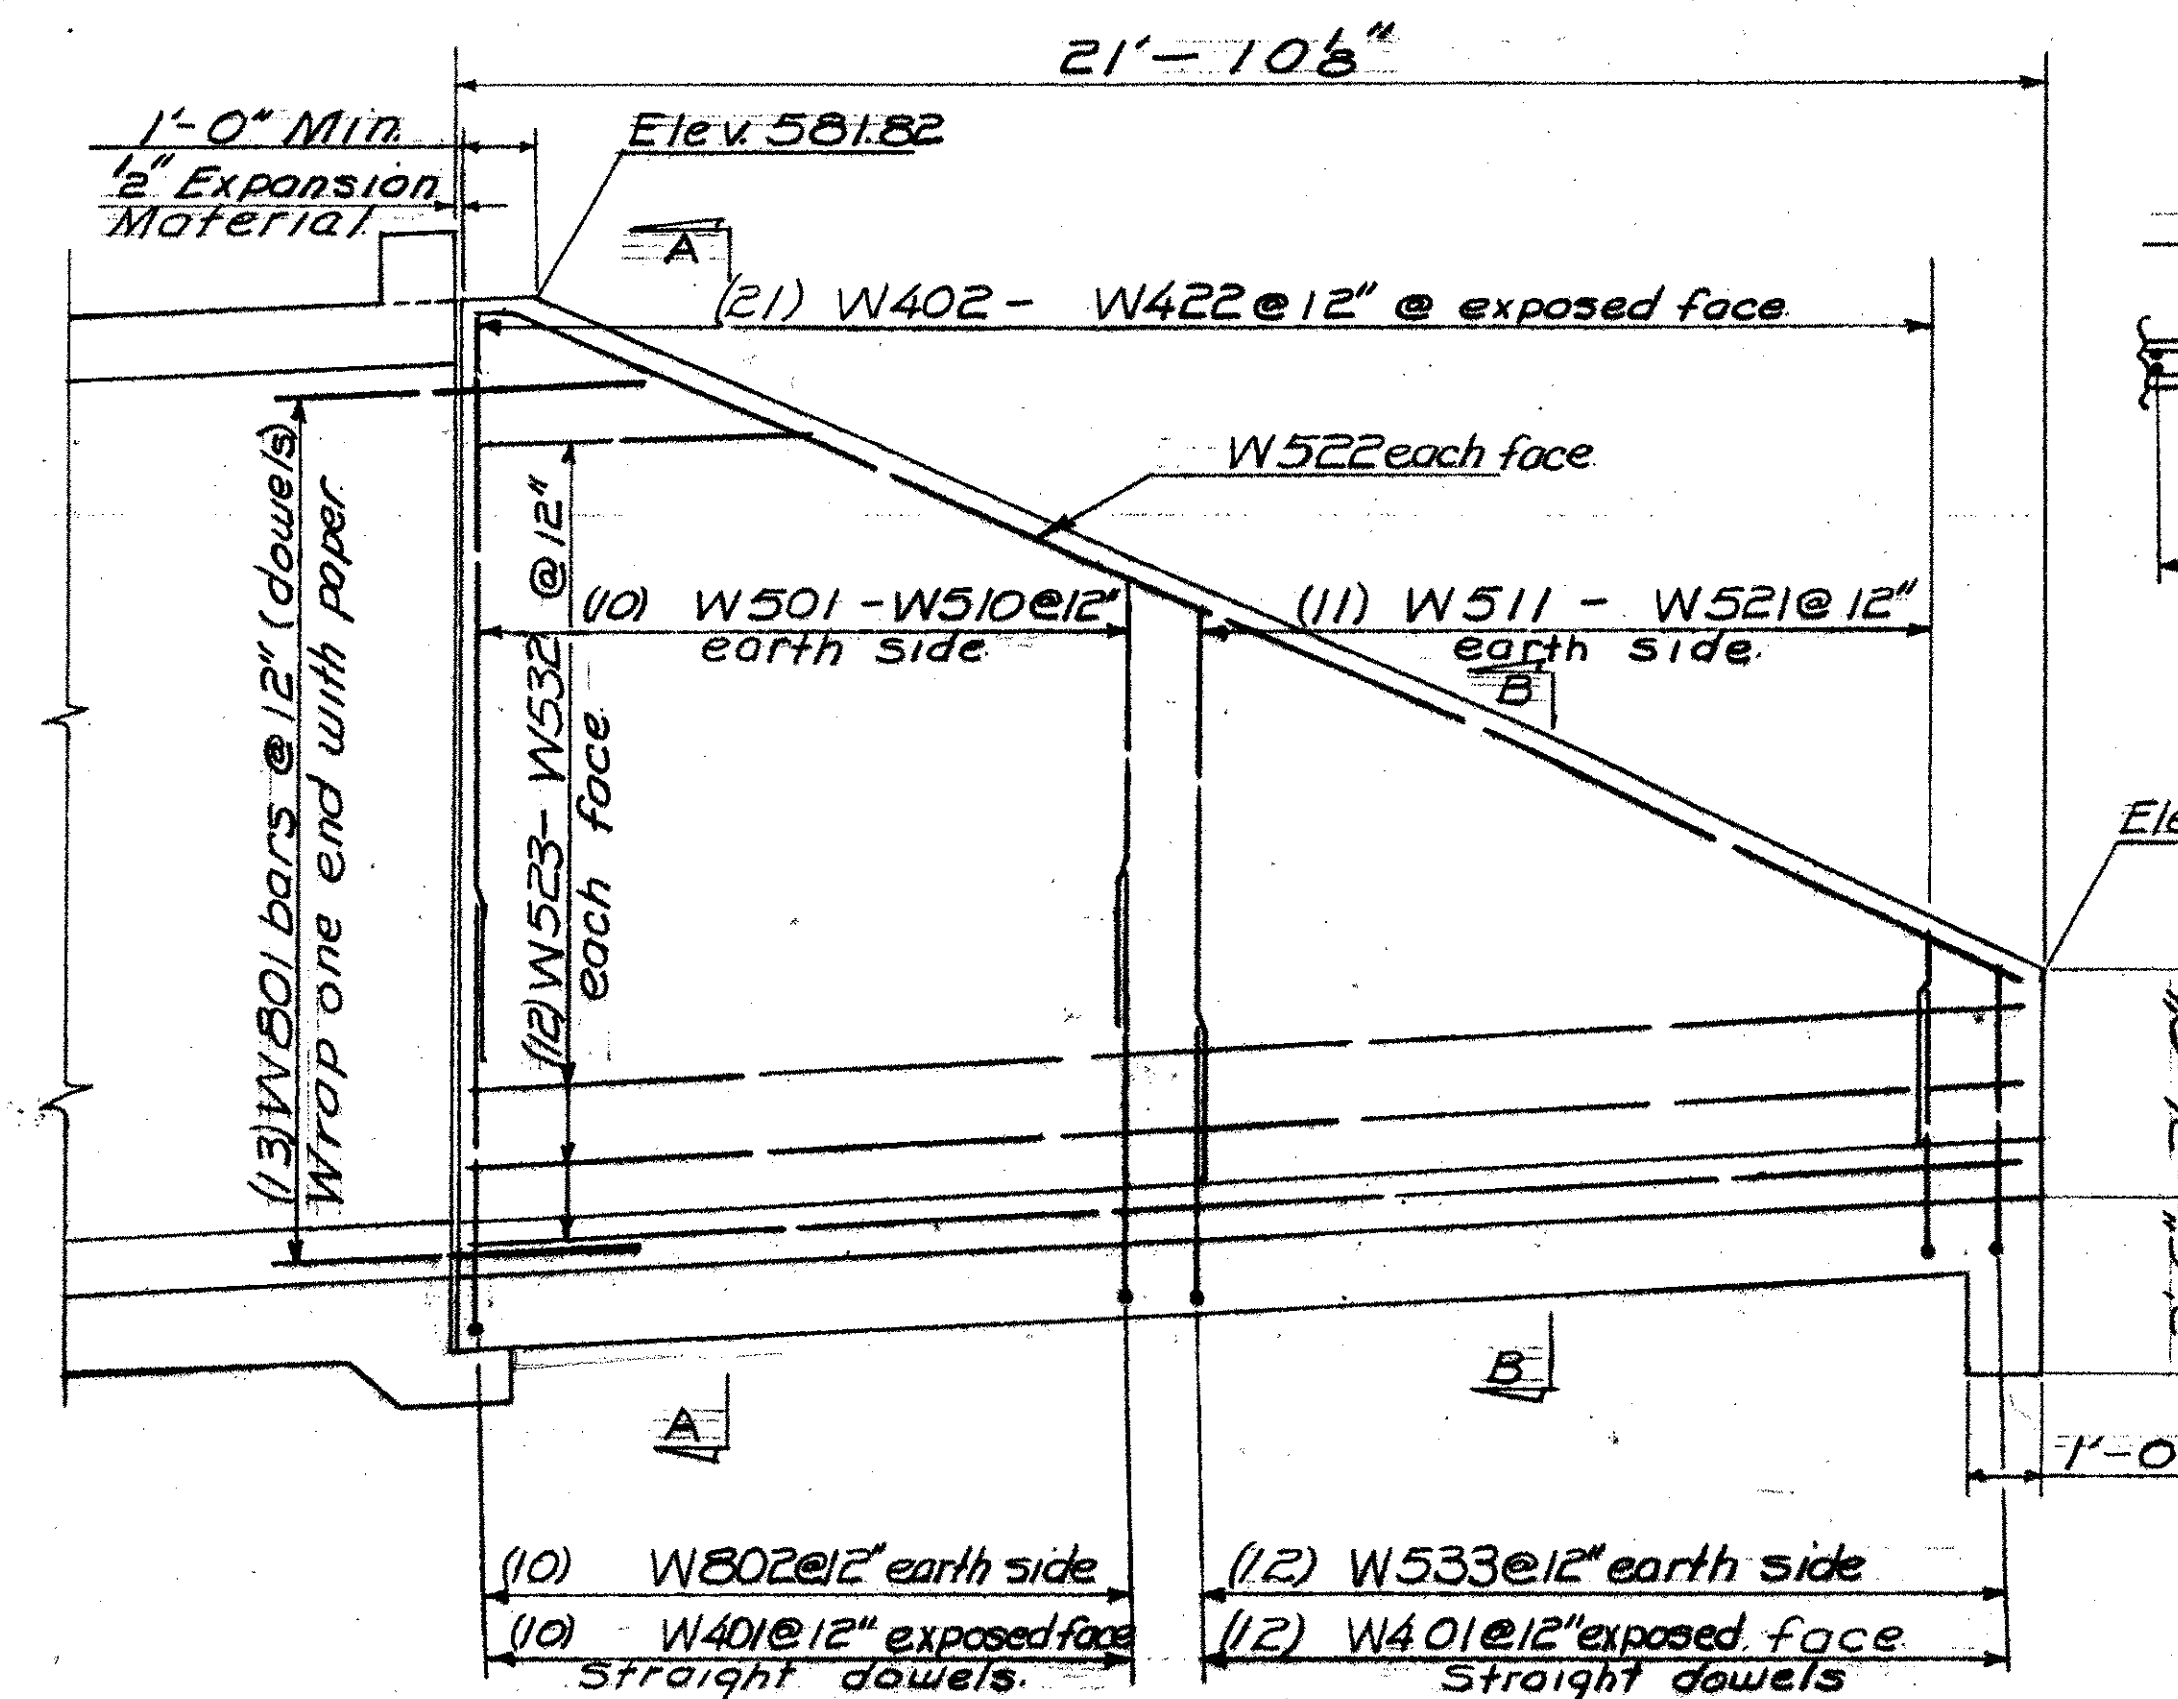




WINGS #344
Scale: 3/8" = 1'-0"

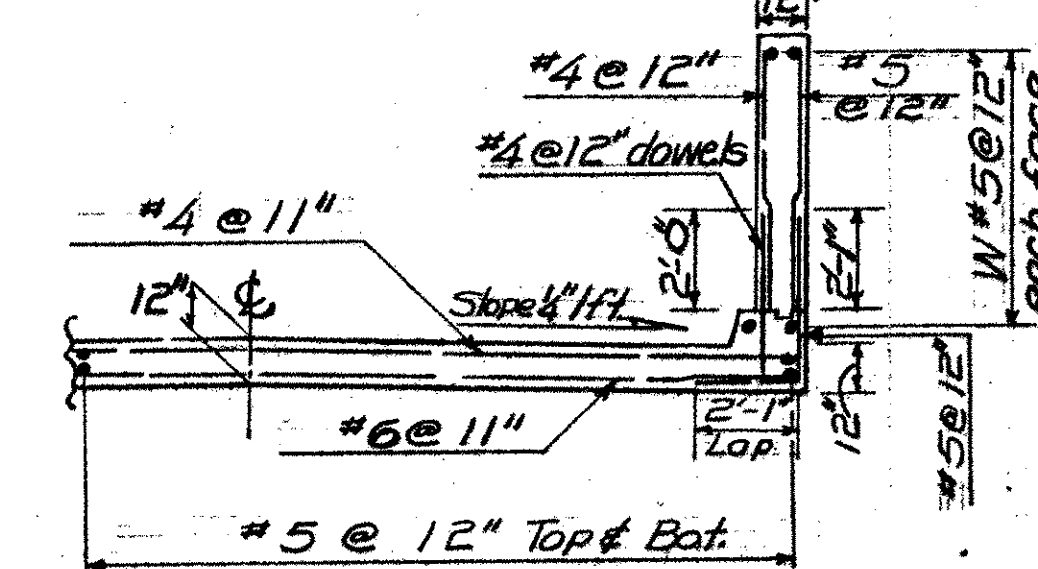


SECTION B-B
Scale: 1/4" = 1'-0"

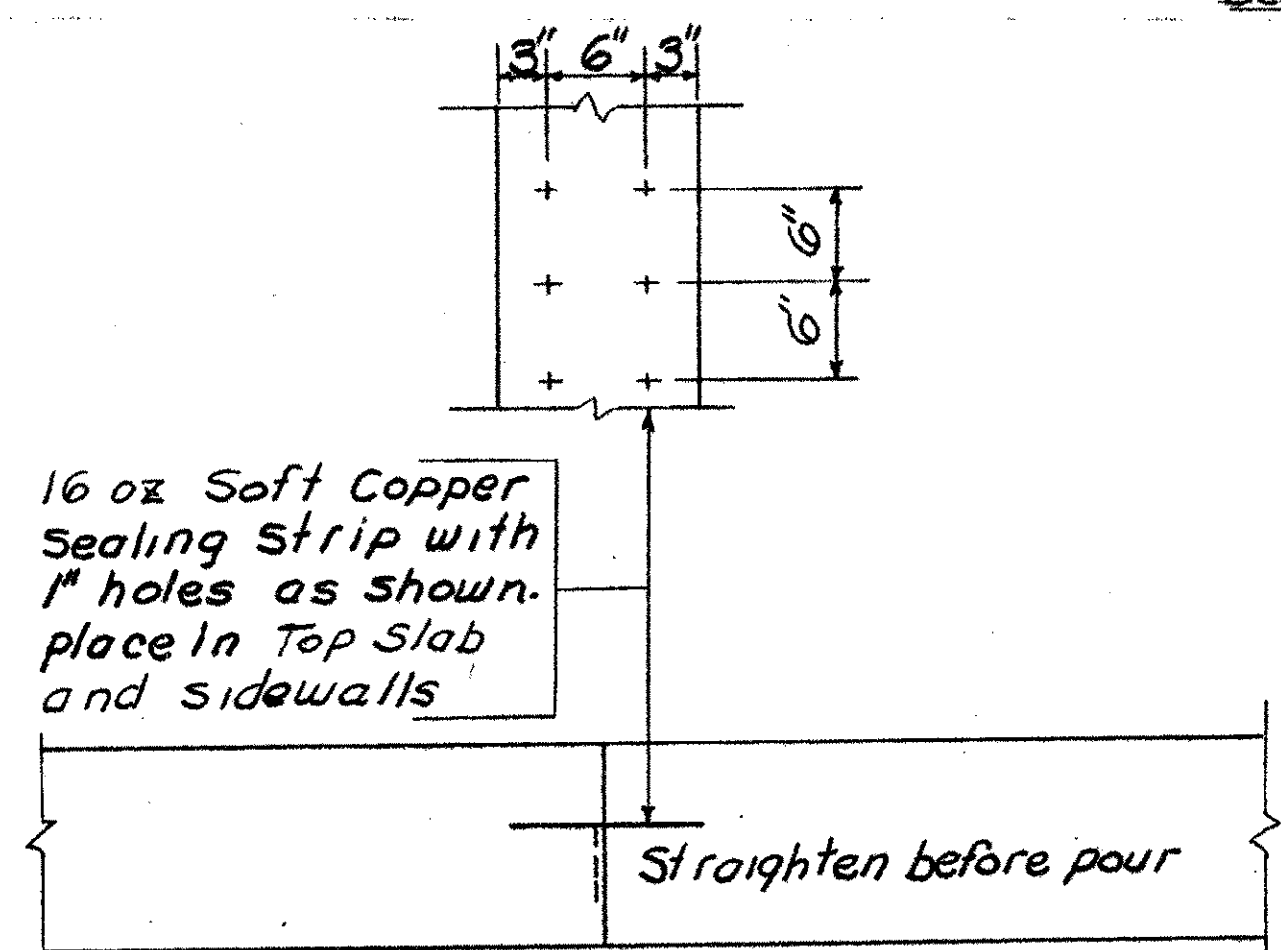


Inside face of Sidewall or Top Slab
CONSTRUCTION JOINT DETAIL
Scale: 1" = 1'-0"

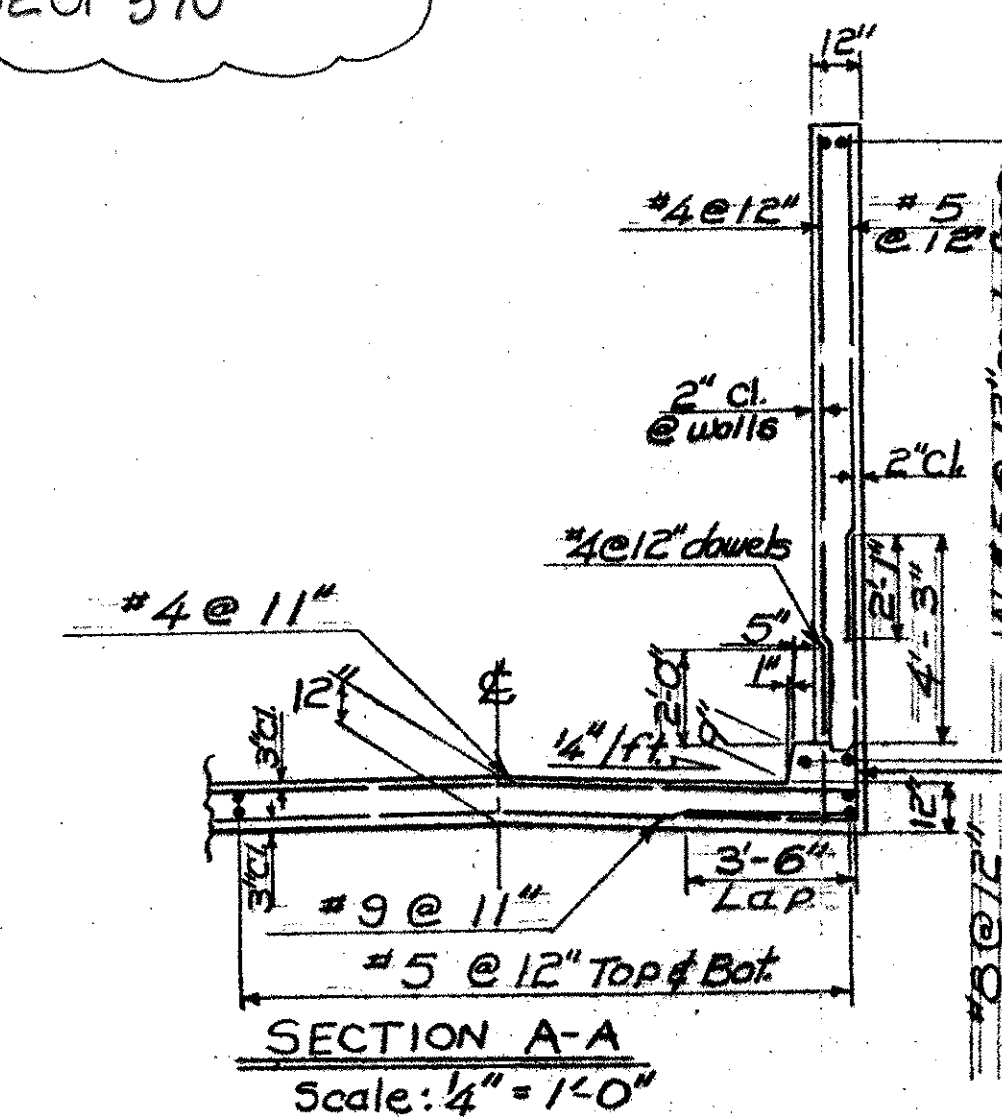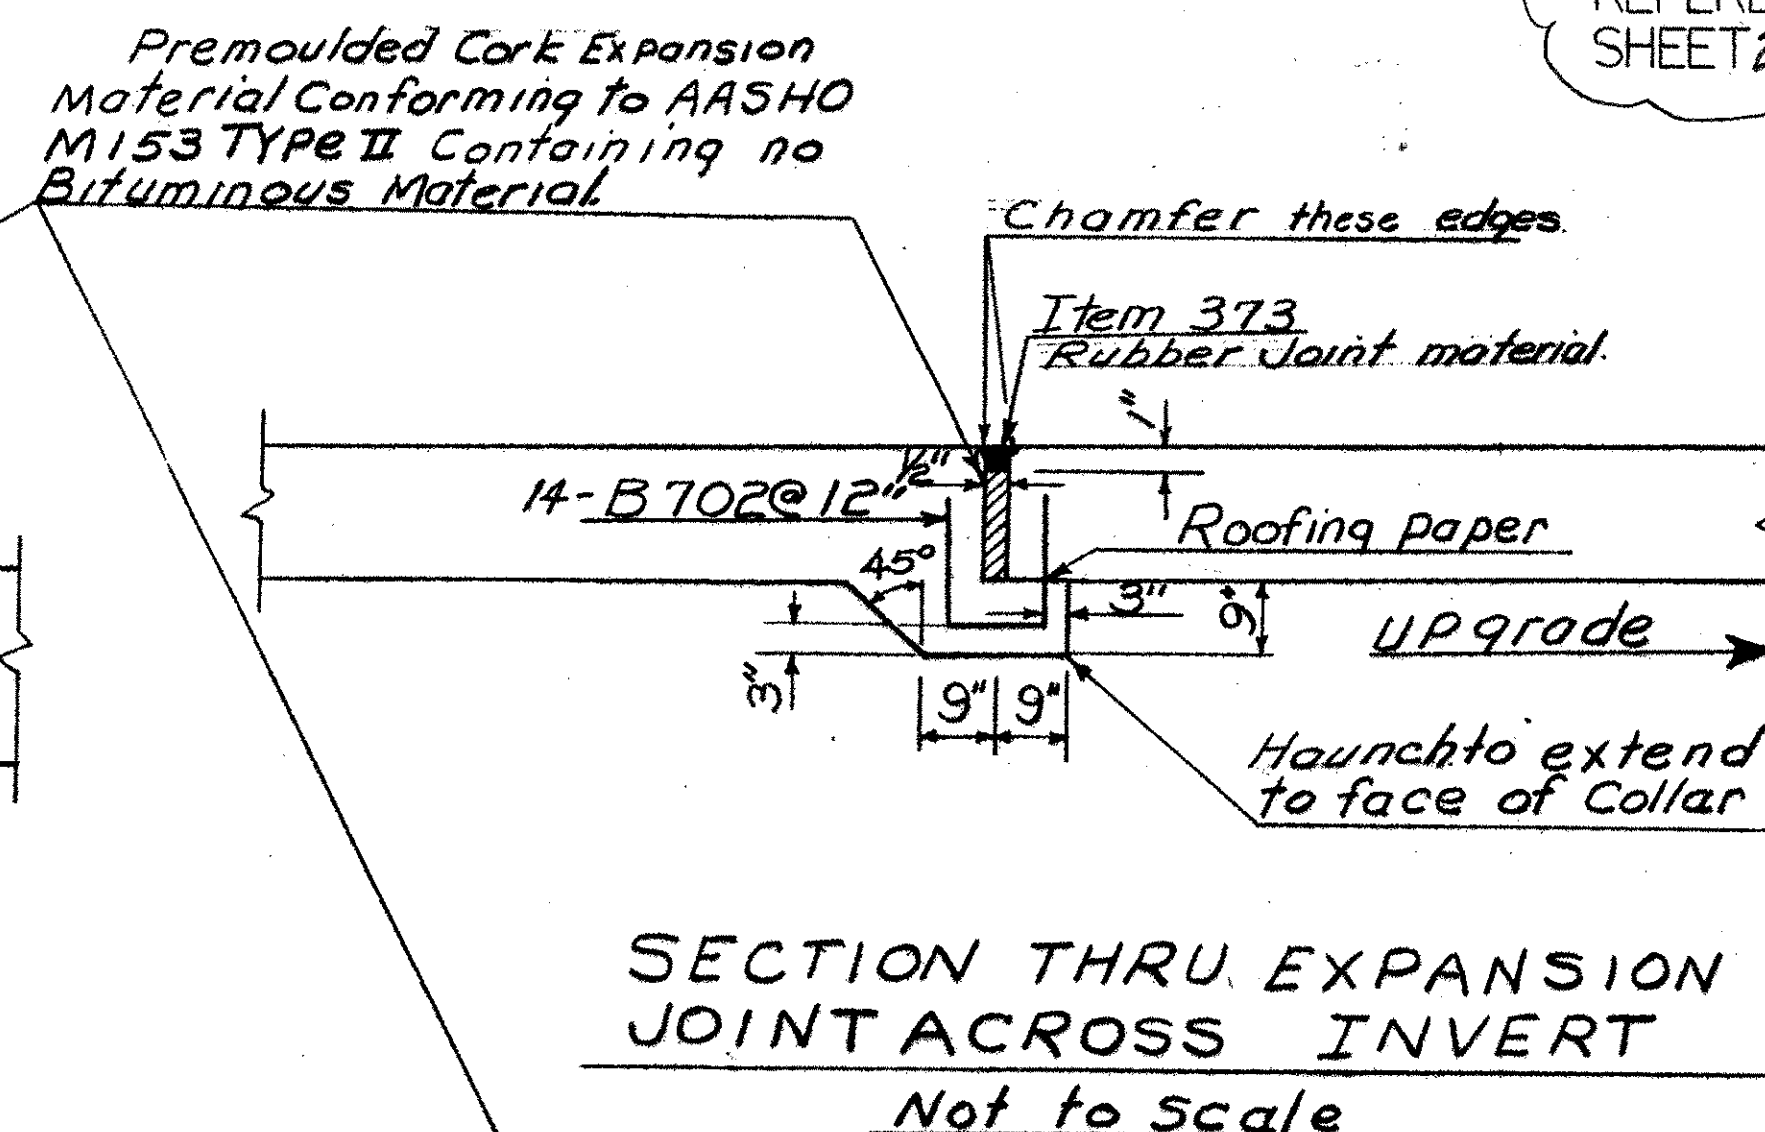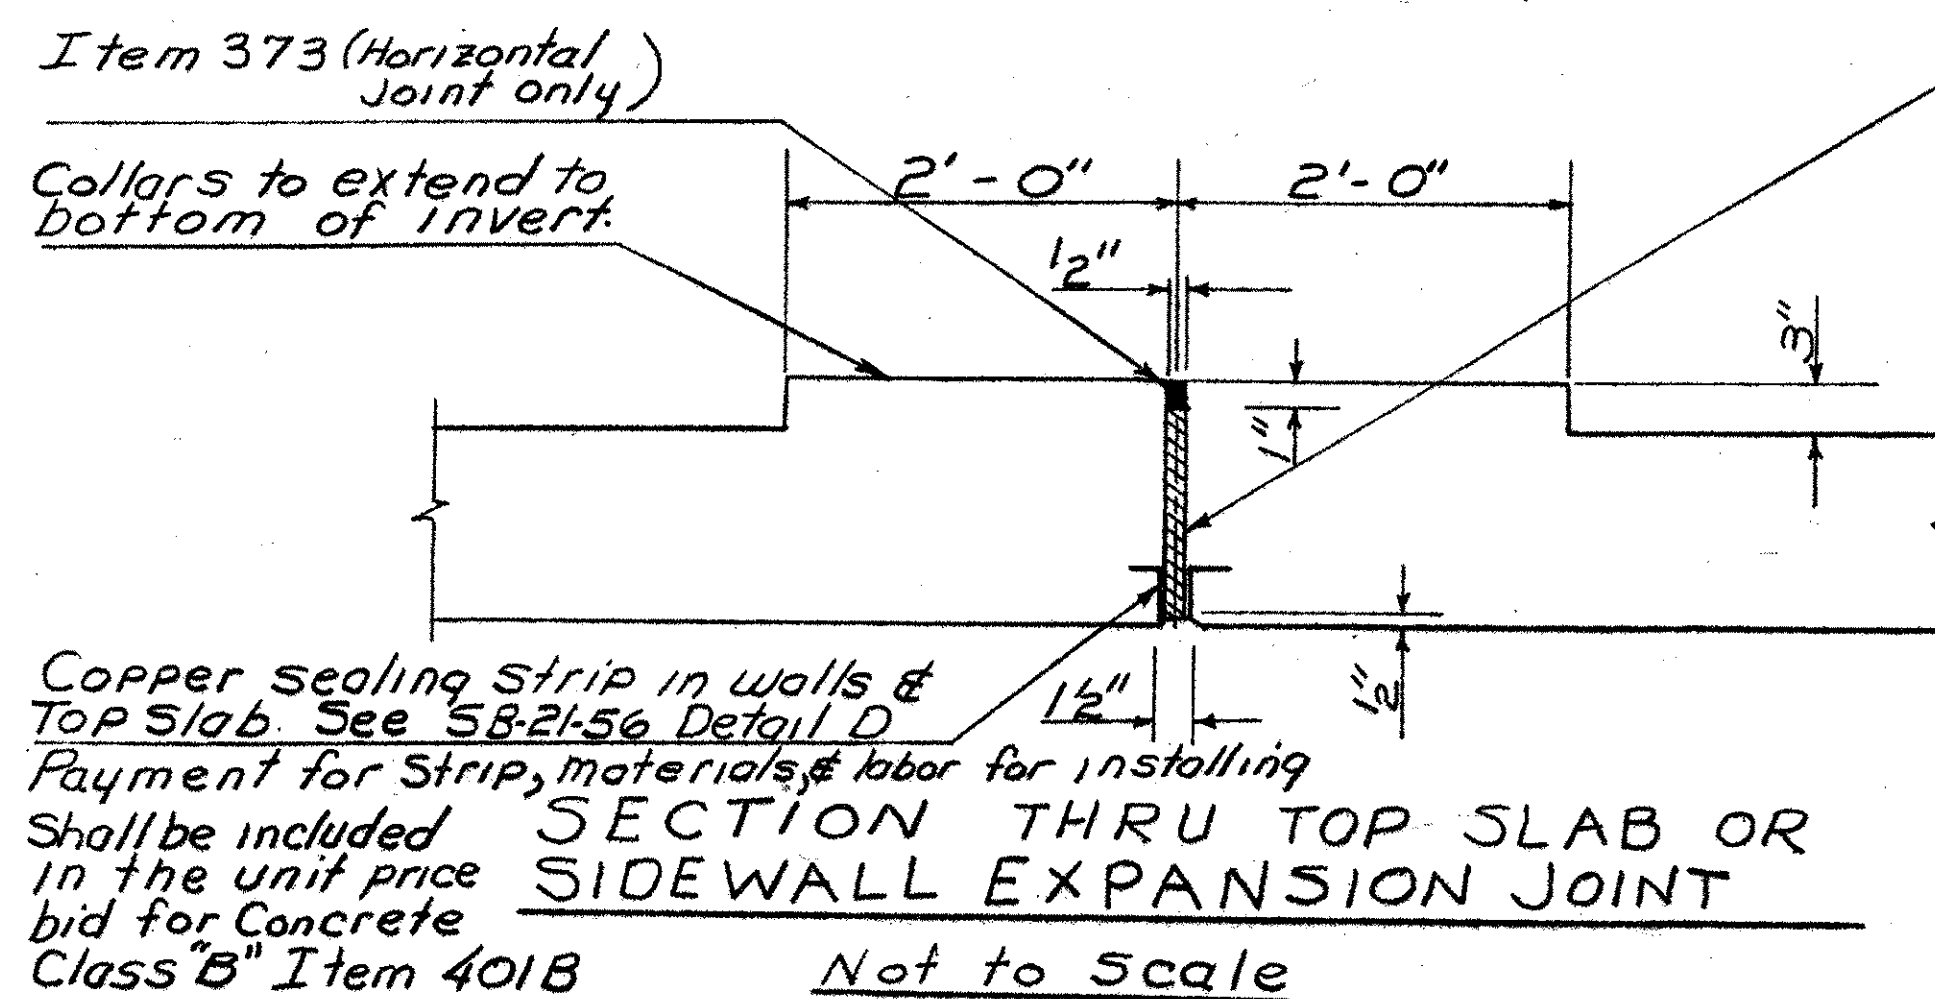


SECTION A-A
Scale: 1/4" = 1'-0"

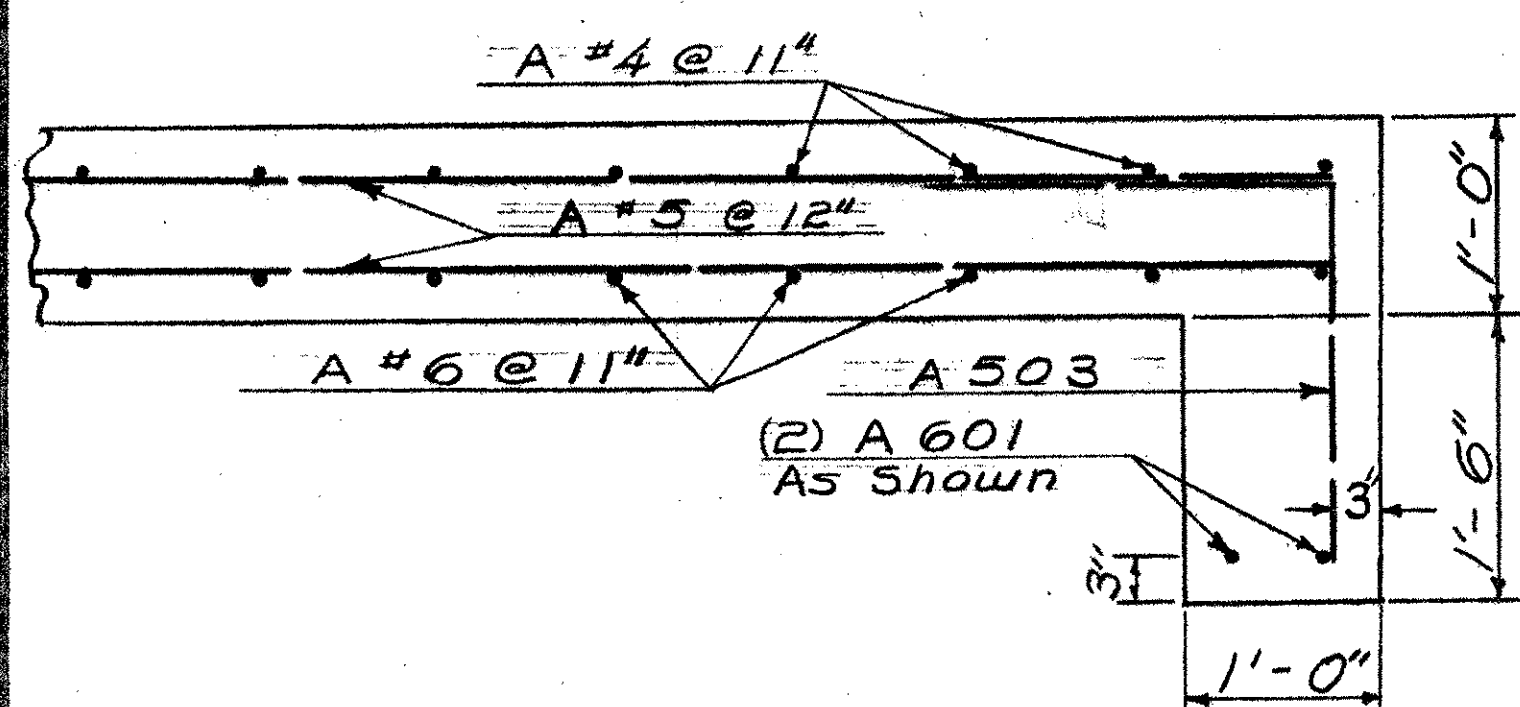

CUT OFF WALL DETAIL
Scale: 1" = 1'-0"

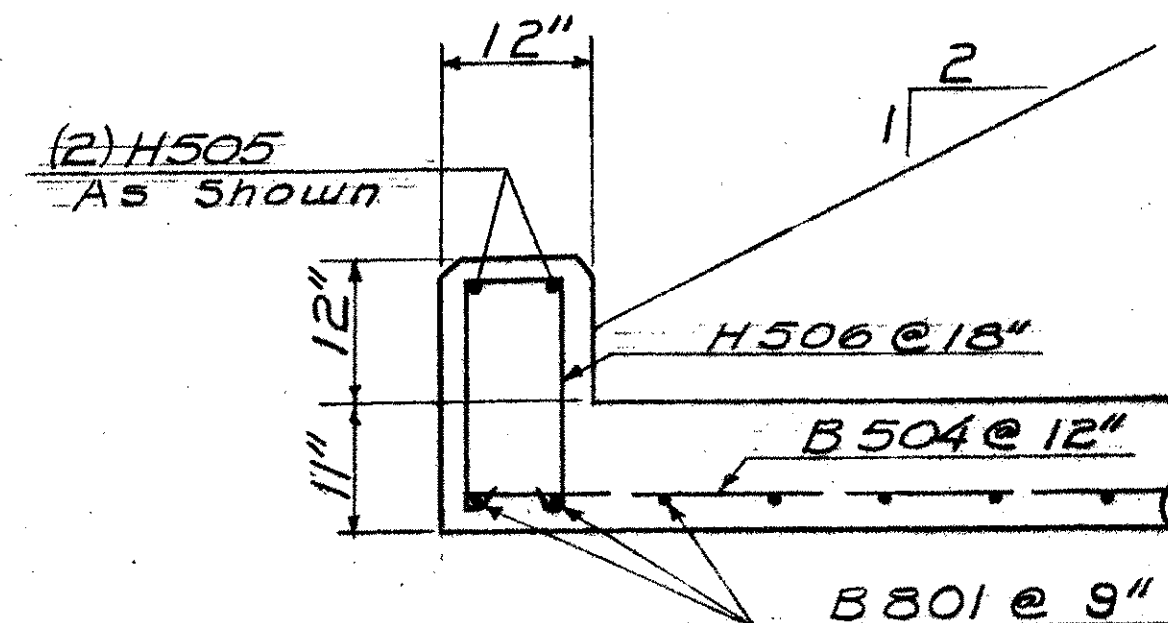

HEADER DETAIL
Scale: 3/4" = 1'-0"

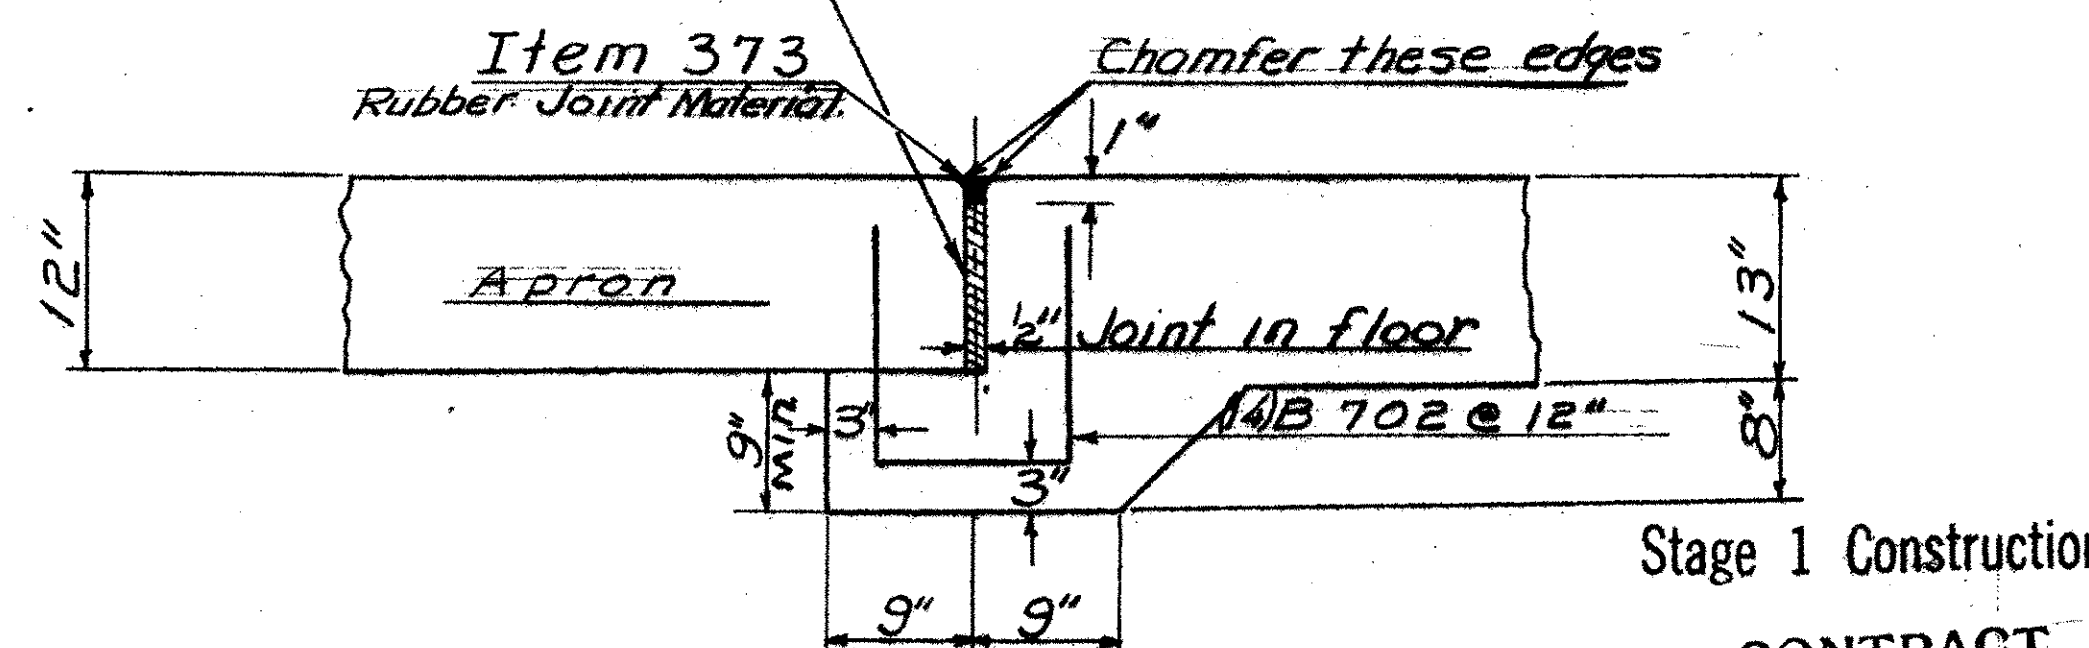

EXPANSION JOINT DETAIL AT APRONS
Scale: 1" = 1'-0"

Stage 1 Construction
CONTRACT 2

STATE OF VERMONT
DEPARTMENT OF HIGHWAYS

GEORGIA-FAIRFAX
TOWN OF FAIRFIELD-ST. ALBANS

ROUTE No. I 89 Log Sta. _____
Wingwall Details & Section
& Detail Drawings

SCALE As Noted

SURVEYED BY Gamsky, Millette & Spaulding
DRAWN BY G.E.H. CHECKED BY R.P.G.

S4:B6 PROJECT NO I 89-3(35) Cont #2
SHEET 212 OF 461

RR-302