


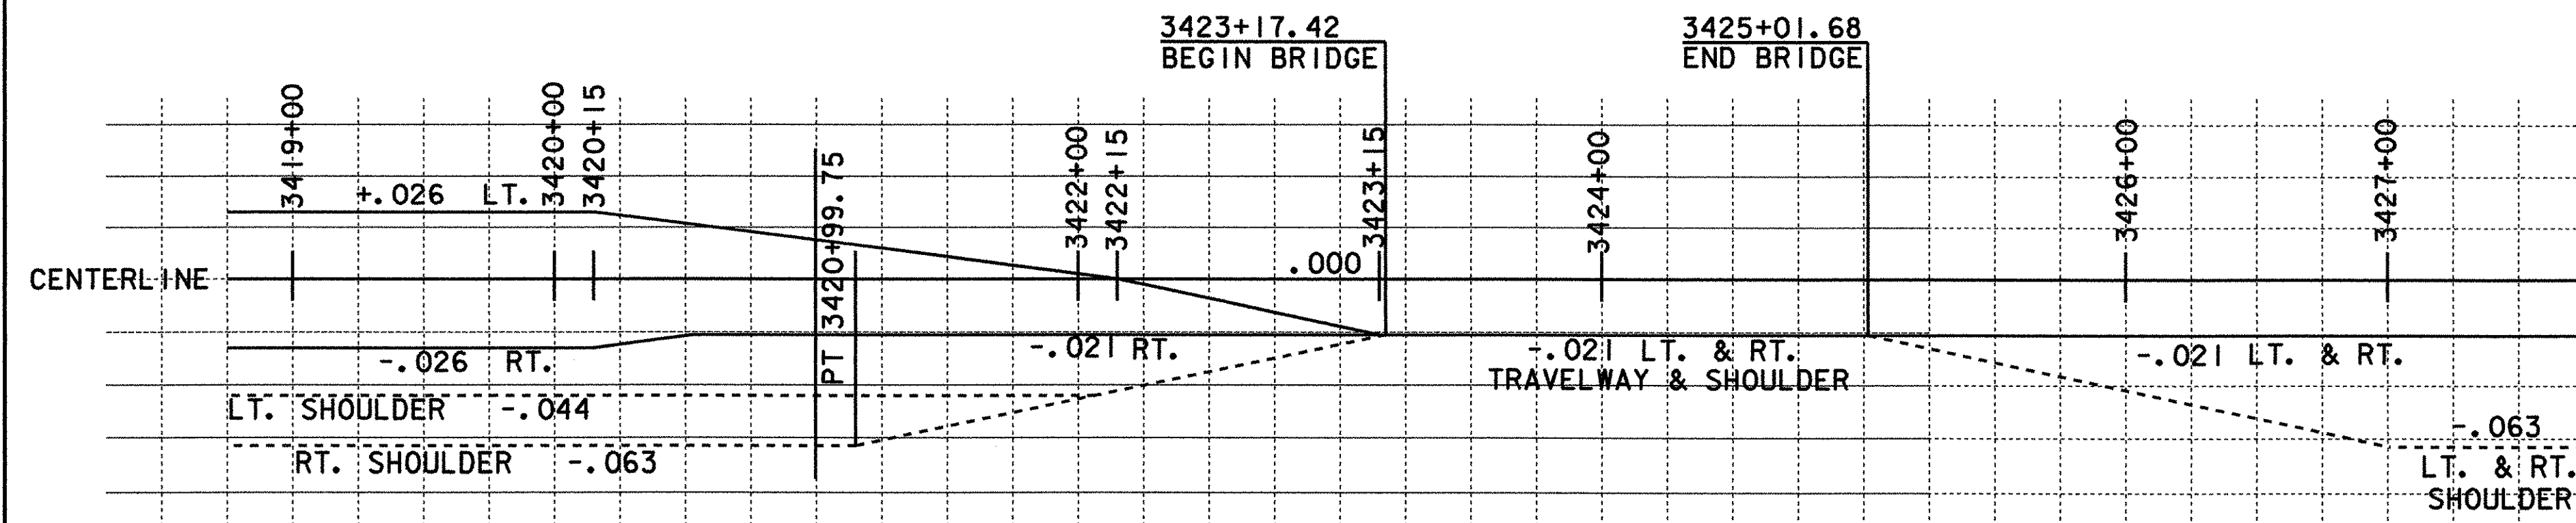
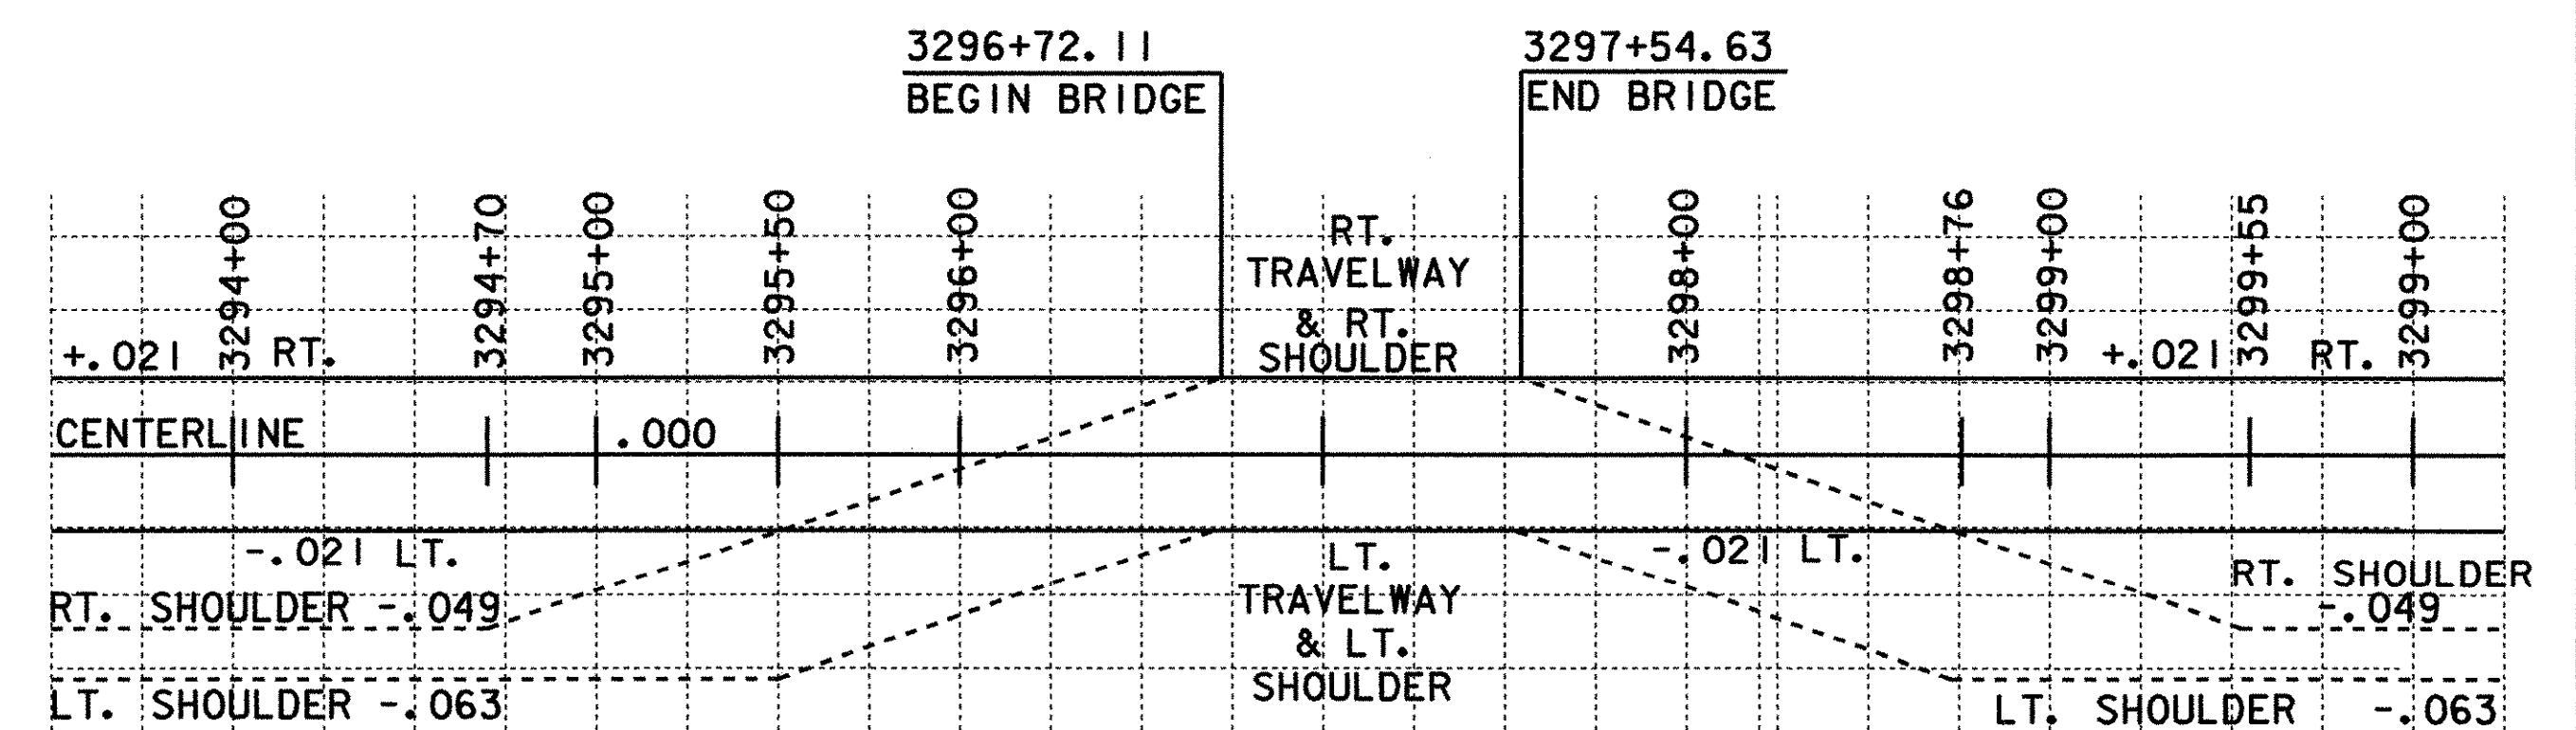
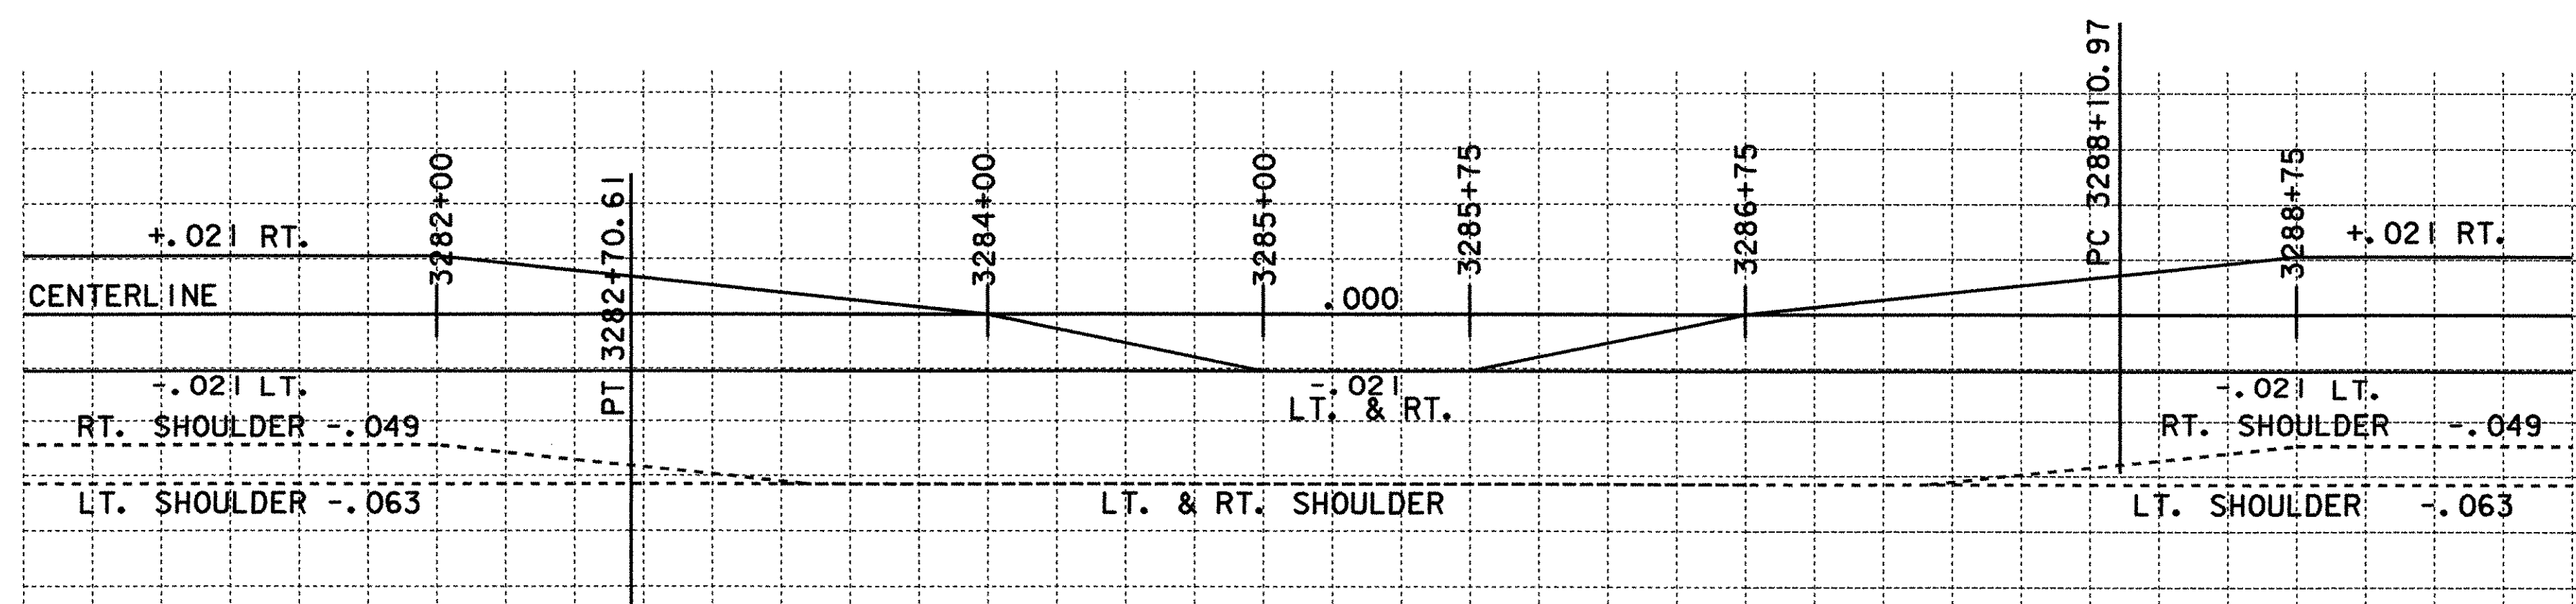


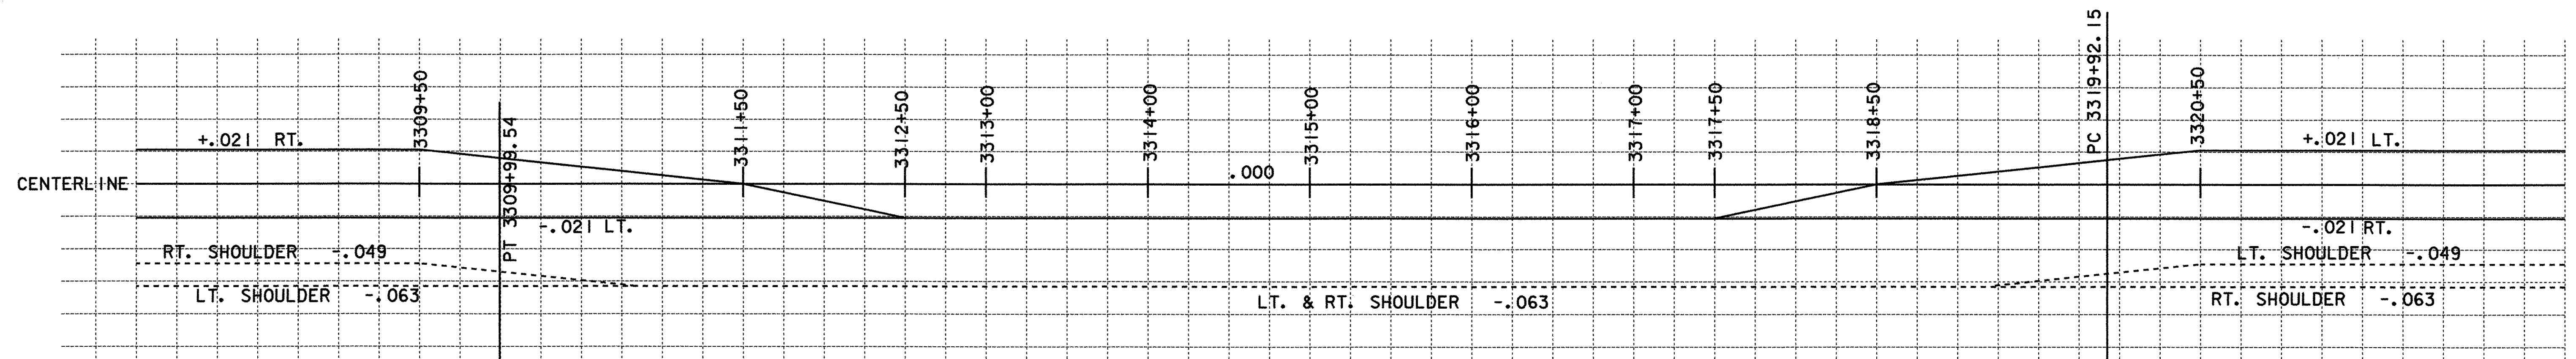

NOTE: AT THE BRIDGE THE SHOULDER CROSS SLOPE SHALL BE THE SAME AS THE TRAVELWAY LANES.

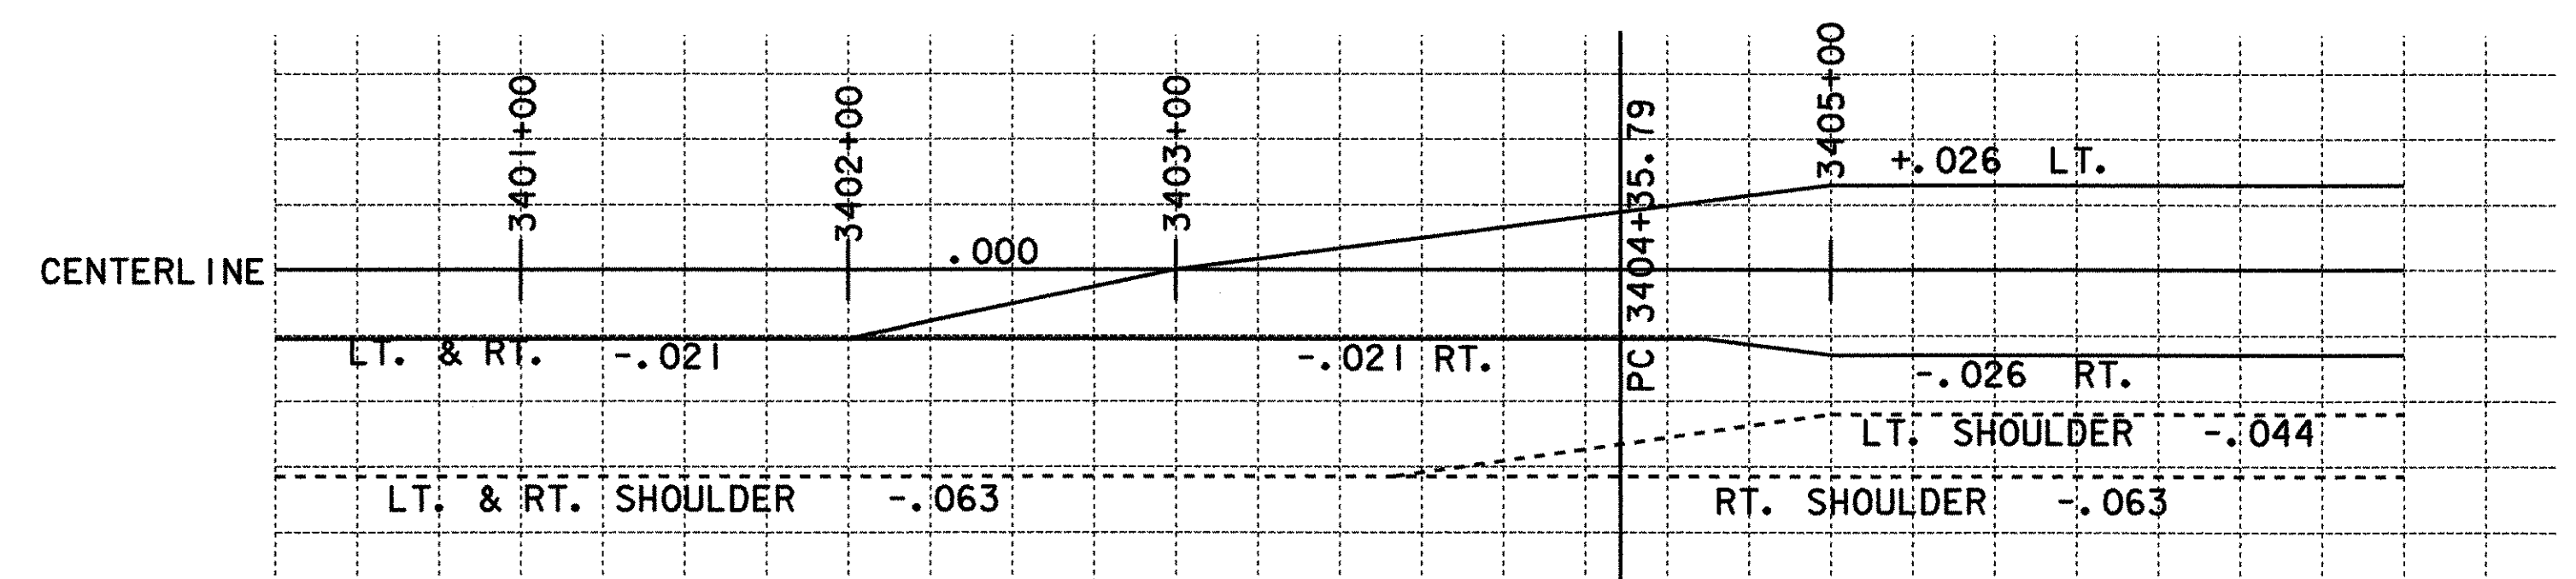

NOTE: AT THE BRIDGE THE SHOULDER CROSS SLOPE SHALL BE THE SAME AS THE TRAVELWAY LANES.

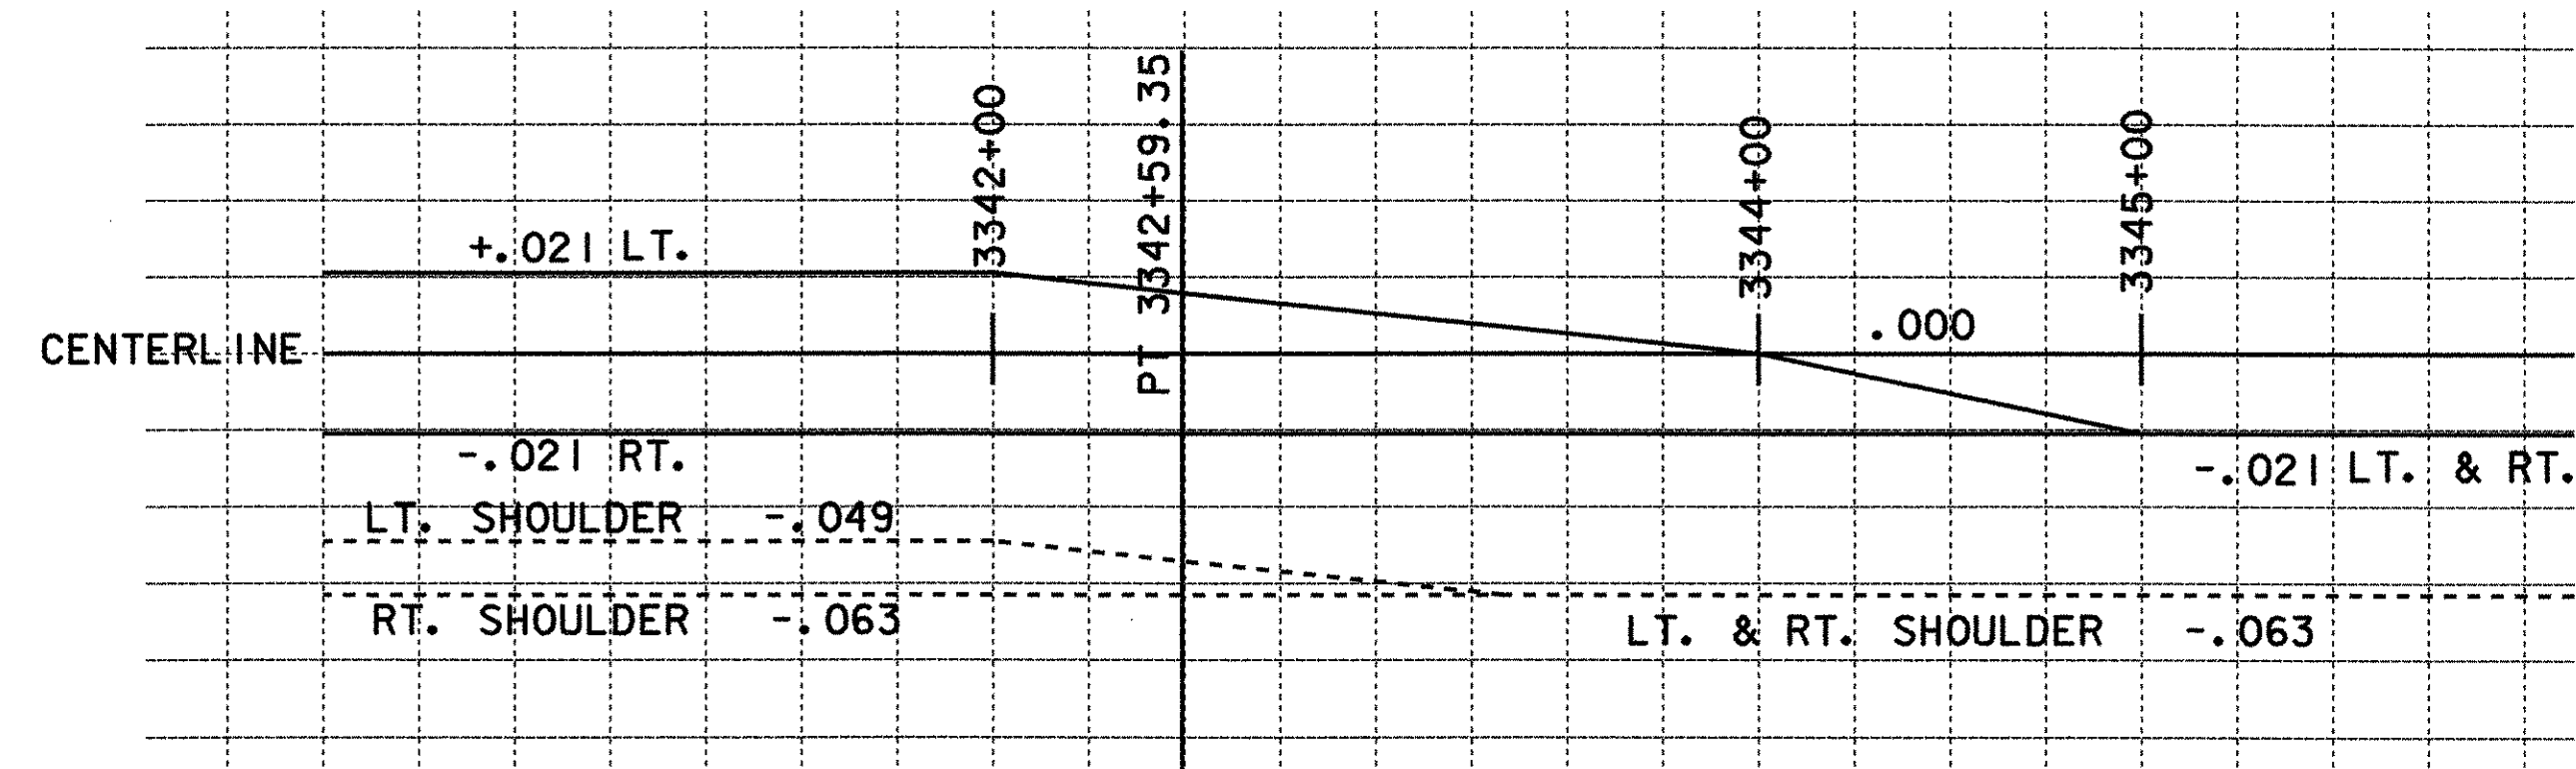

SOUTHBOUND BANKING TRANSITION DIAGRAMS

PROJECT: FAIRFAX - FAIRFIELD - ST. ALBANS		PROJECT NO.: IM 089-3(27)	
DESIGN FILE NAME:	/87A007B/DESIGN/DA007XS2.DGN	IPARM FILE NAME:	DA007BKS
SURVEYED BY:	ORVIS	SURVEY DATE:	18-AUG-2000
SQUAD LEADER:	DELLA SANTA	DRAWN BY:	SQUAD B
		SHEET:	296 OF 370