


NOTE: OFFSET DISTANCES ARE MEASURED FROM THE GRADE LINE.

SOUTHBOUND CROSS SECTIONS

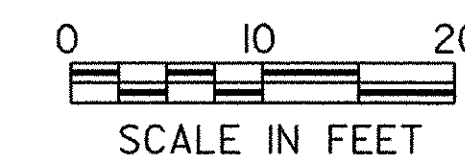

| | | | |
|-------------------|----------------------------------|--------------|--------------|
| PROJECT: | FAIRFAX - FAIRFIELD - ST. ALBANS | PROJECT NO.: | IM 089-3(27) |
| DESIGN FILE NAME: | /87A007B/DESIGN/DA007X52.DGN | PLOT DATE: | 18-AUG-2000 |
| IPARM FILE NAME: | DA007X24 | SURVEY DATE: | 6/98 |
| SURVEYED BY: | ORVIS | DRAWN BY: | SQUAD B |
| SQUAD LEADER: | DELLA SANTA | SHEET: | 301 OF 370 |