




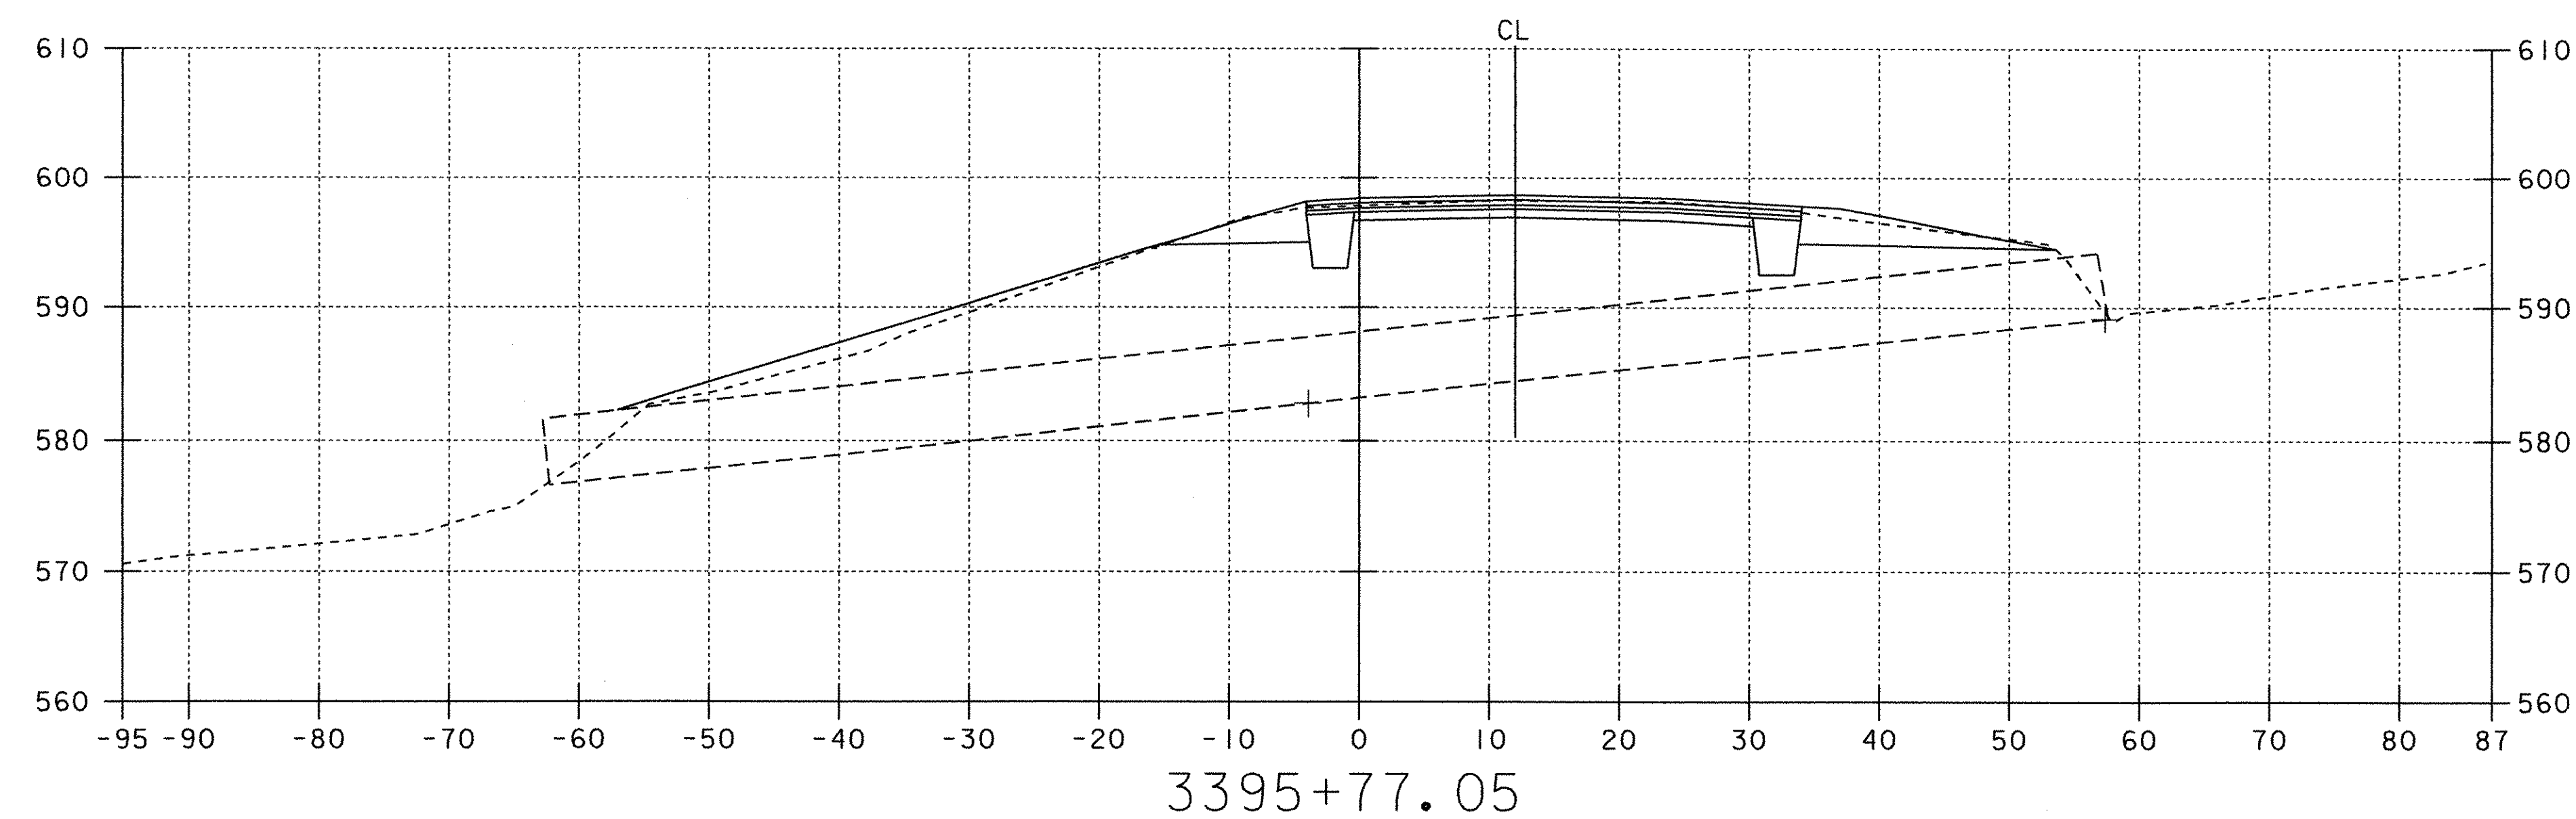


3395+77.05
EXISTING 60' ACCGMP (REFER TO BRIDGE SERIES 300)

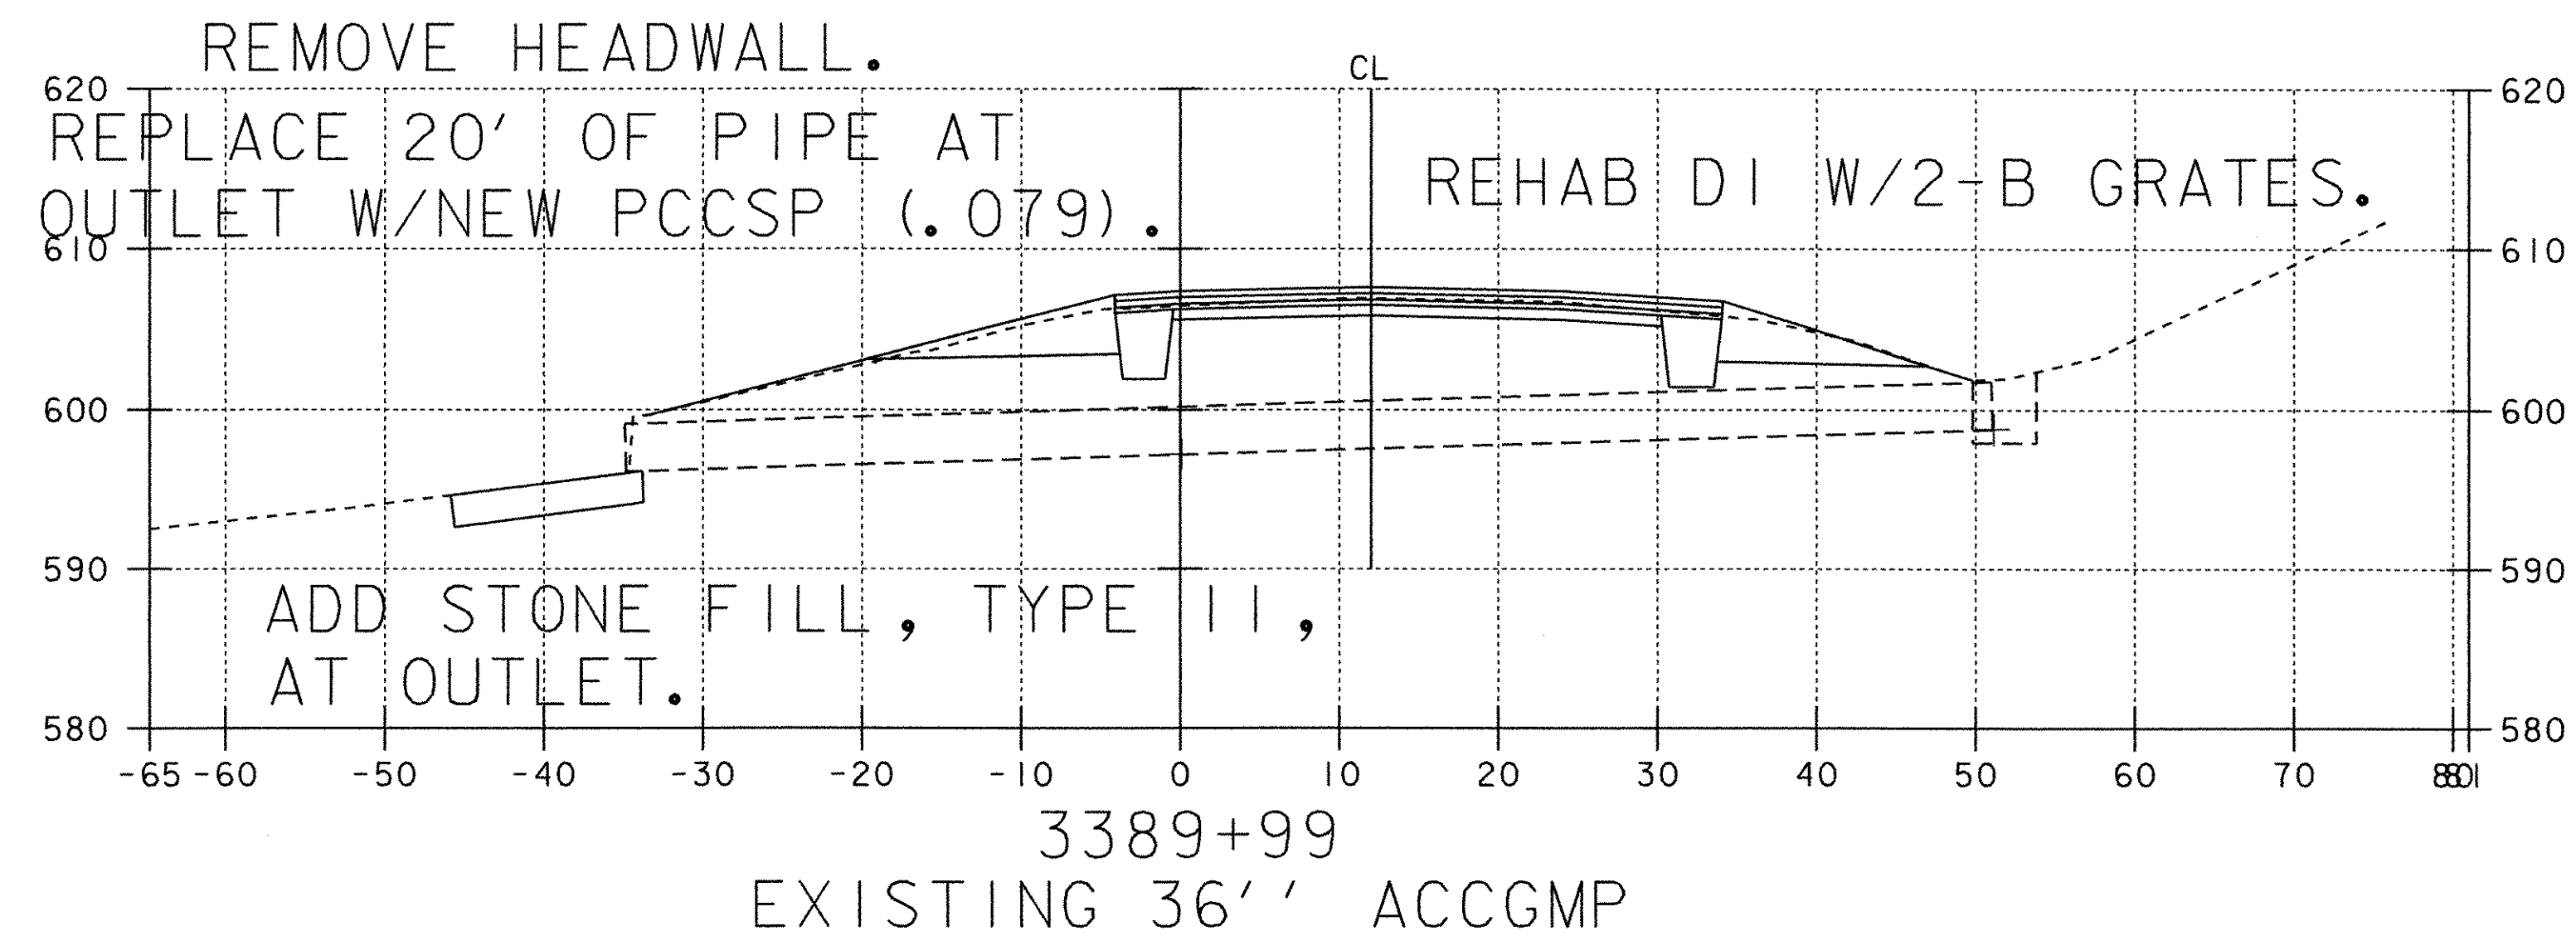

3389+99
EXISTING 36' ACCGMP

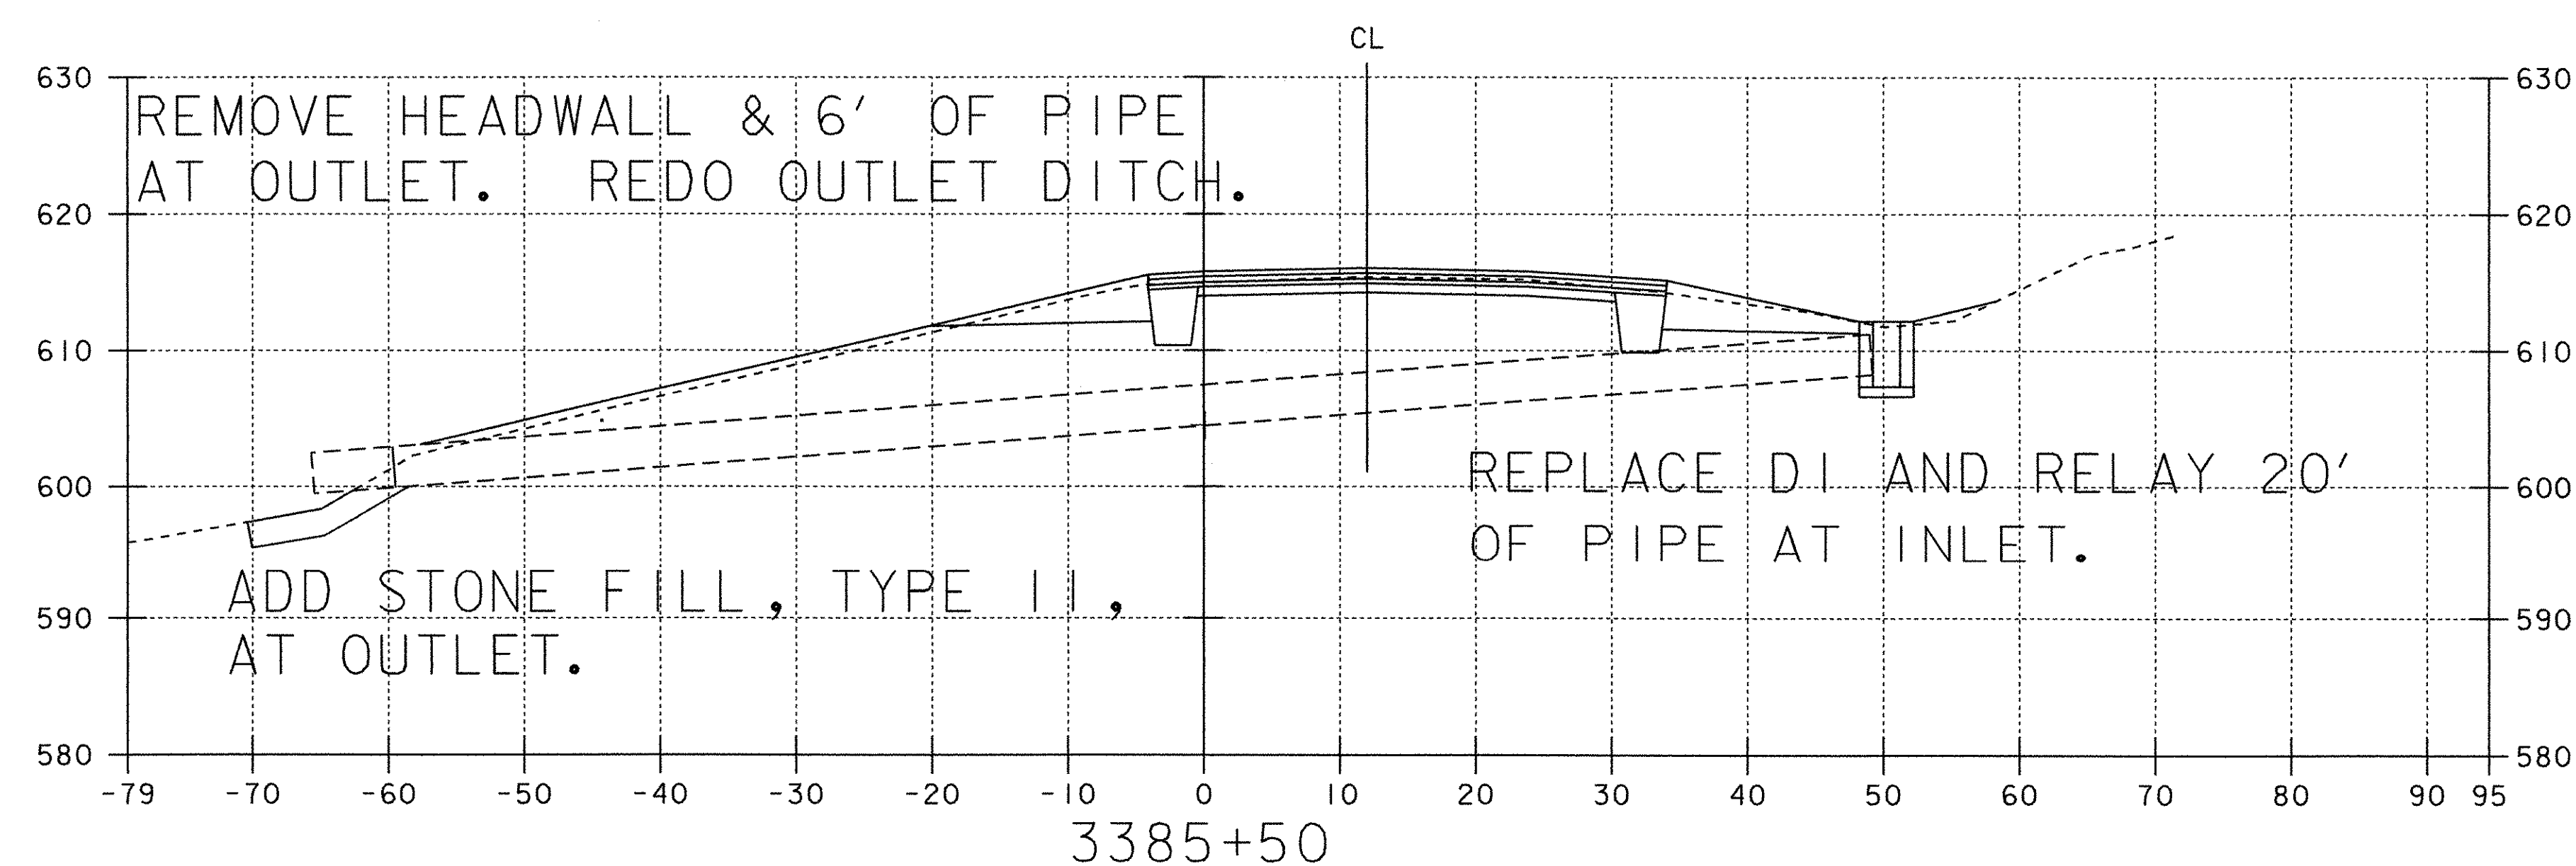

3385+50
EXISTING 36' ACCGMP
NORTHBOUND DRAINAGE CROSS SECTIONS

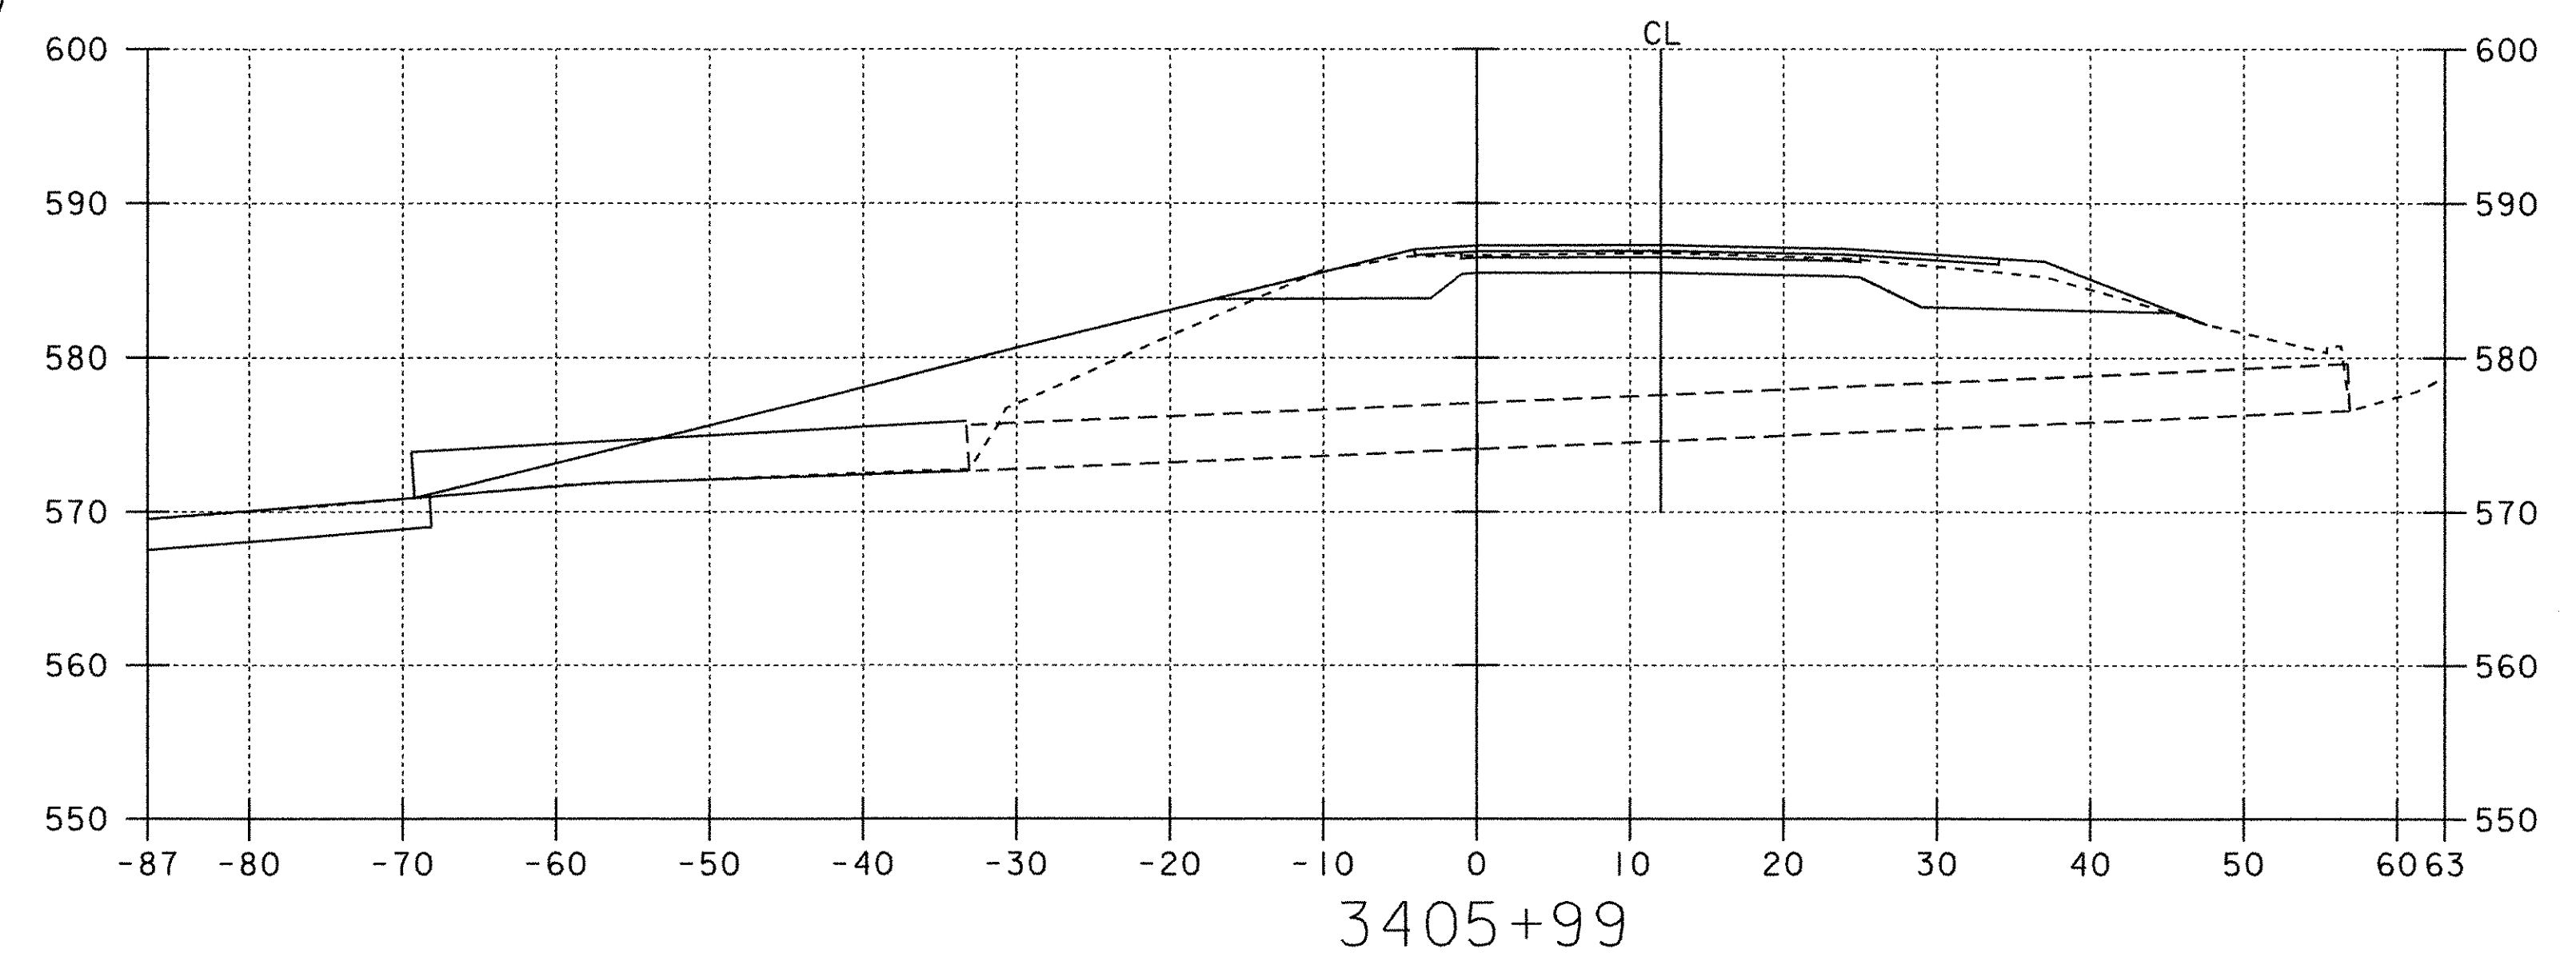

3405+99
EXISTING 36' RCP
EXTEND EXISTING 36' RCP AT OUTLET
W/NEW 36' X 36' RCP, CL III.
LINE DITCH BETWEEN CULVERTS WITH
STONE FILL, TYPE II

0 10 20
SCALE IN FEET

PROJECT:	FAIRFAX - FAIRFIELD - ST. ALBANS	PROJECT NO.:	IM 089-3(27)
DESIGN FILE NAME:	/87A007B/DESIGN/DA007DXS.DGN	PLOT DATE:	03-OCT-2000
IPARM FILE NAME:	DA007X69	SURVEY DATE:	6/98
SURVEYED BY:	ORVIS	DRAWN BY:	SQUAD B
SQUAD LEADER:	DELLA SANTA	SHEET:	367 OF 370