


NORTHBOUND DRAINAGE CROSS SECTIONS

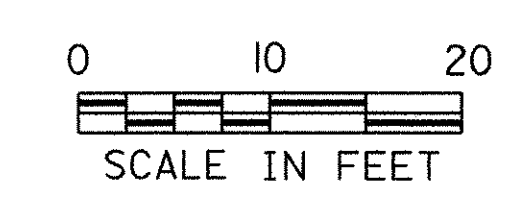

| | |
|--|-------------------------------|
| PROJECT: FAIRFAX - FAIRFIELD - ST. ALBANS | PROJECT NO. : IM 089-3(27) |
| DESIGN FILE NAME: /87A007B/DESIGN/DA007DXS.DGN | PLOT DATE: 17-AUG-2000 |
| IPARM FILE NAME: DA007X70 | SURVEY DATE: 6/98 |
| SURVEYED BY: ORVIS | DRAWN BY: SQUAD B |
| SQUAD LEADER: DELLA SANTA | SHEET: 368 OF 370 |