


NORTHBOUND DRAINAGE CROSS SECTIONS

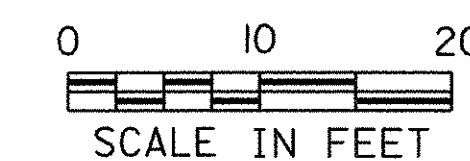

PROJECT: FAIRFAX - FAIRFIELD - ST. ALBANS	PROJECT NO.: IM 089-3(27)
DESIGN FILE NAME: /87A007B/DESIGN/DA007DXS.DGN	PLOT DATE: 03-OCT-2000
IPARM FILE NAME: DA007X7I	SURVEY DATE: 6/98
SURVEYED BY: ORVIS	DRAWN BY: SQUAD_B
SQUAD LEADER: DELLA SANTA	SHEET: 369 OF 370