


55124.09
34135.40
85-11.17
576.31
565.81
10.44
= 12.266% = 12.266/100

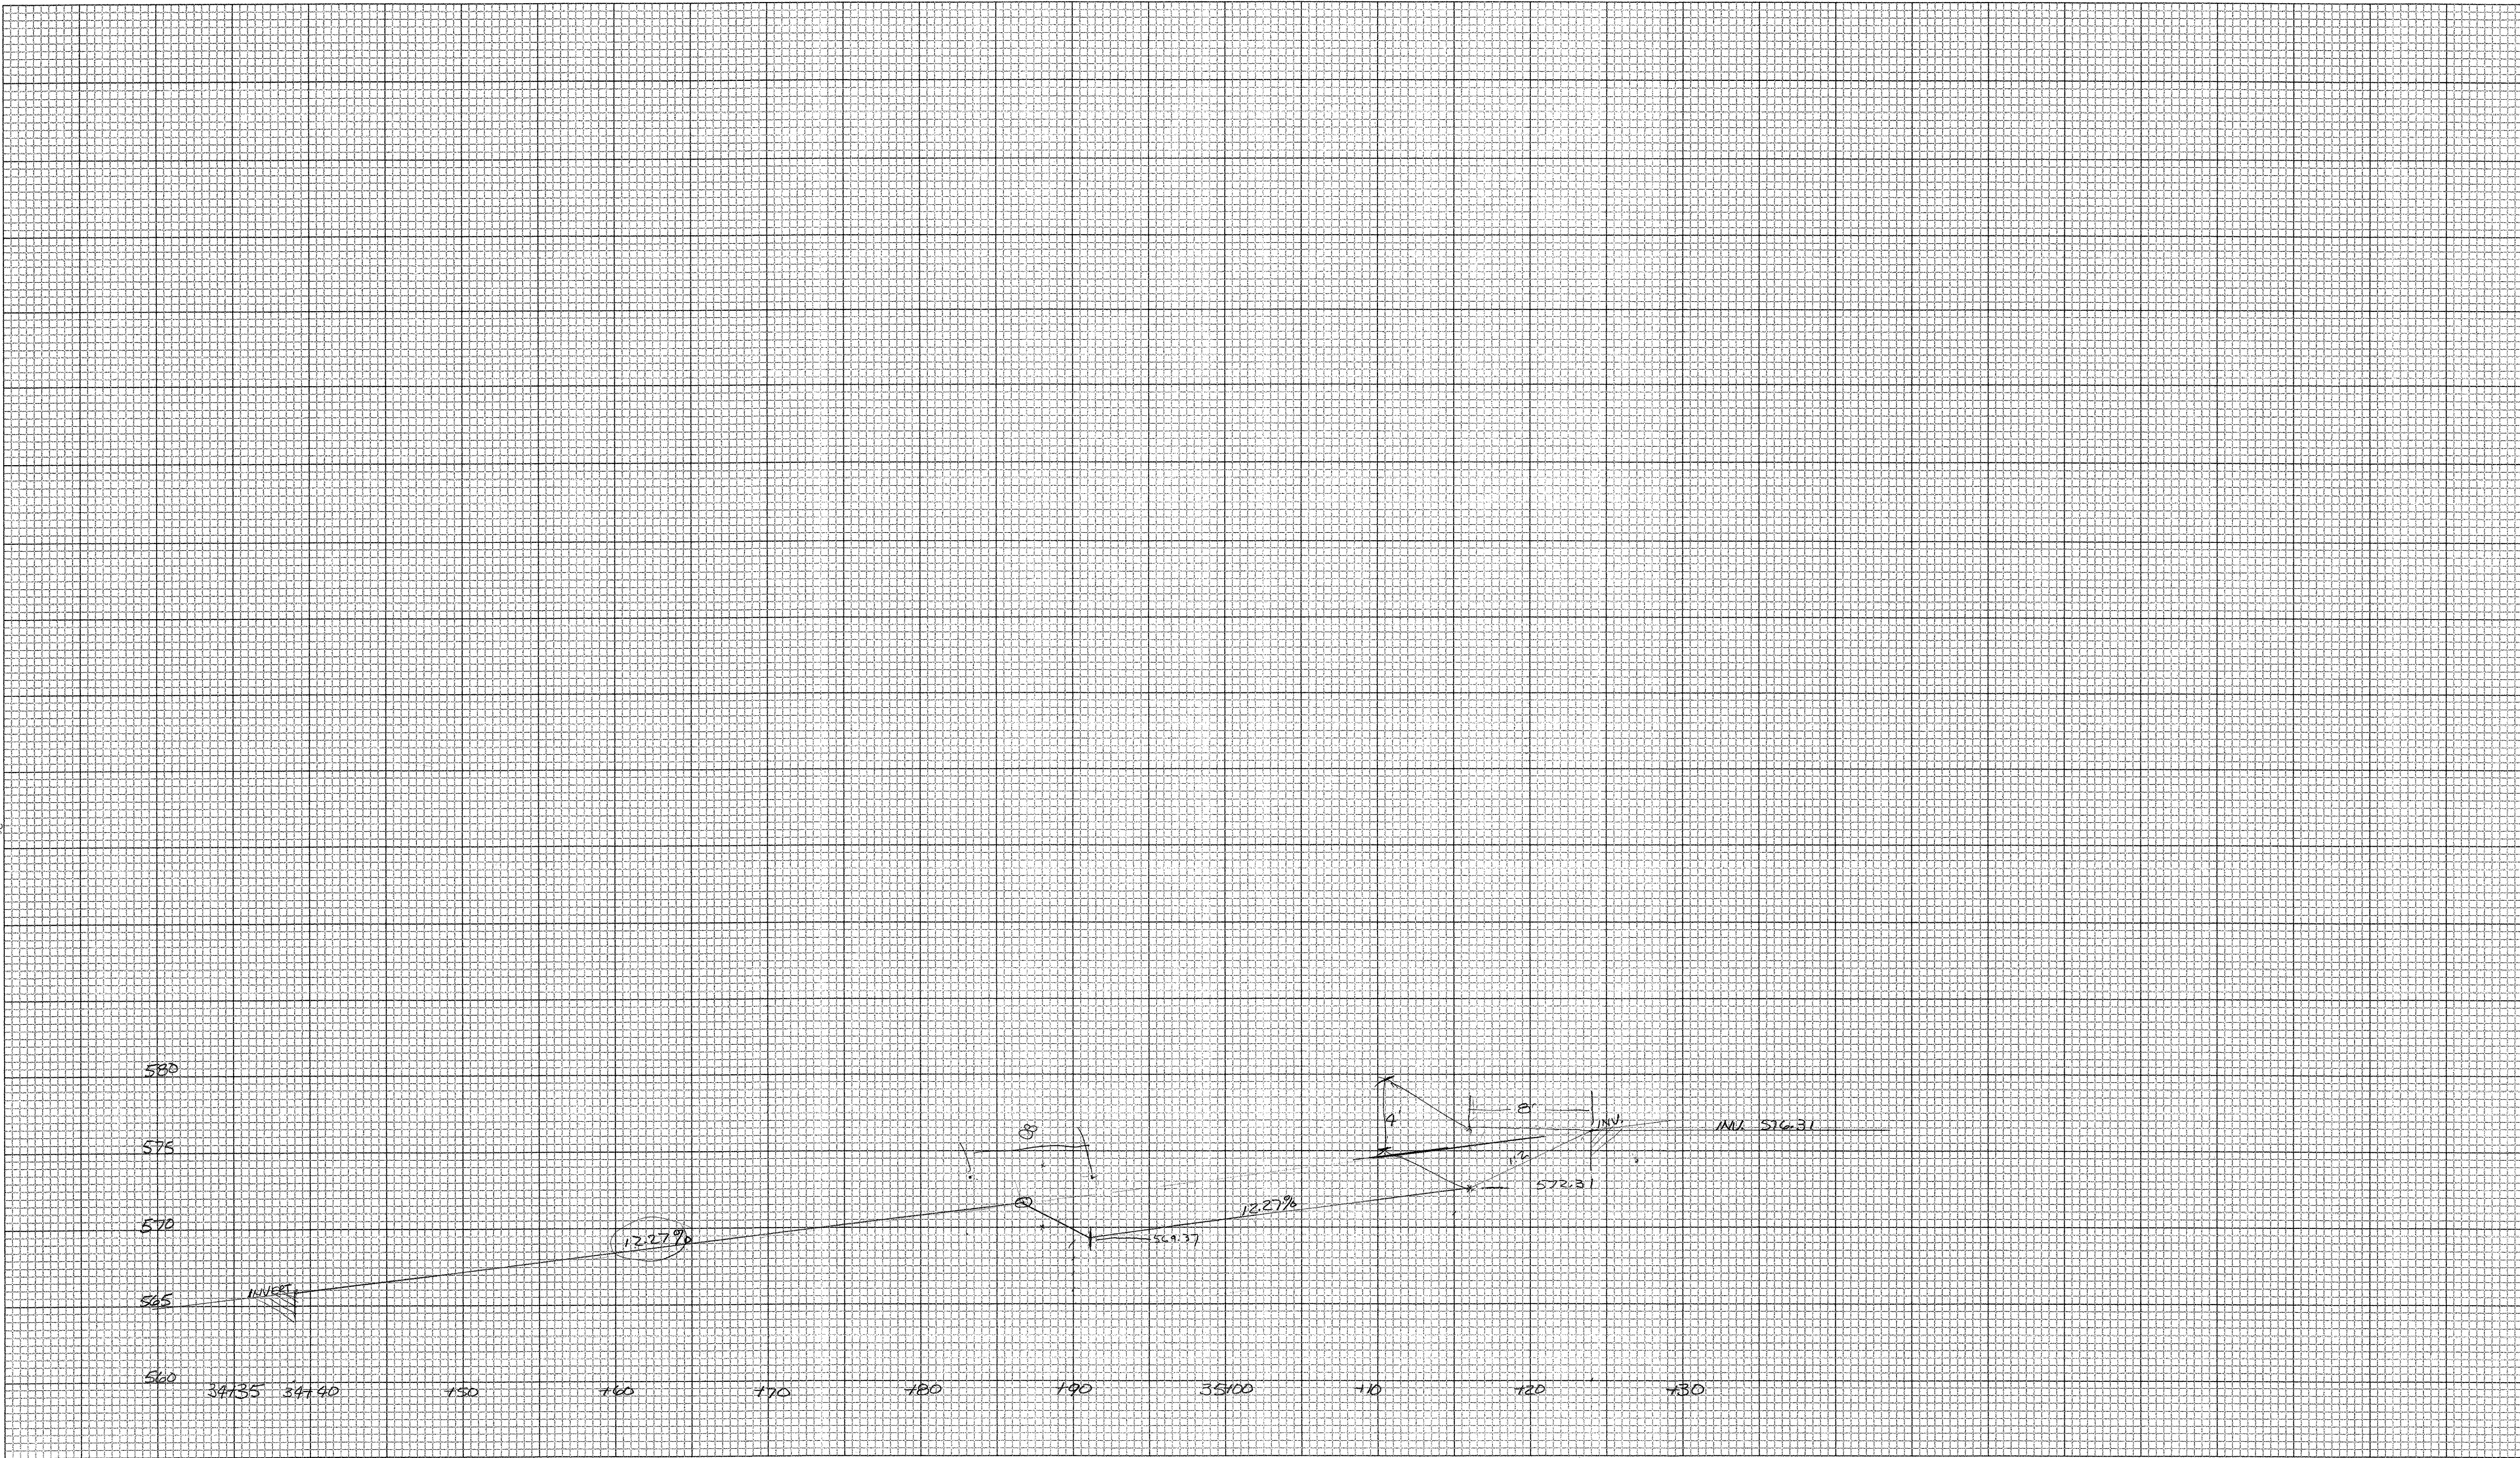

1"=5'H
1"=5'V

CROSS SECTION SHEET

PROJECT NAME:			
PROJECT NUMBER:			
FILE NAME:		PLOT DATE:	05-JUN-2000 09
PROJECT LEADER:		DRAWN BY:	
DESIGNED BY:		CHECKED BY:	
const: g:/common/cadd/e-xsection.dgn		SHEET	386 OF